


(X) DRAWING KEYED NOTES


- 1 PROVIDE NEW ADA COMPLIANT FLOOR-MOUNTED TOILET (P-101). PROVIDE NEW 4" SAN AND 2" VENT PIPING TO FIXTURE.
- 2 PROVIDE NEW WALL-HUNG LAVATORY AND FAUCET (P-418). PROVIDE NEW 1 1/2" SAN AND 1 1/2" VENT PIPING TO FIXTURE.
- 3 PROVIDE NEW SINGLE COMPARTMENT CRS SINK AND FAUCET (P-528). PROVIDE NEW 1 1/2" SAN AND 1 1/2" VENT PIPING TO FIXTURE.
- 4 PROVIDE TWO NEW SINGLE UNIT WATER COOLERS, ONE AT STD. HEIGHT AND THE OTHER AT ADA HEIGHT. PROVIDE NEW 2" SAN AND 1 1/2" VENT PIPING TO FIXTURE.
- 5 PROVIDE NEW FREE-STANDING EMERGENCY SHOWER AND EYE/FACE WASH (P-707). PROVIDE NEW 1 1/2" SAN AND 1 1/2" VENT PIPING TO FIXTURE.
- 6 PROVIDE NEW CLINIC SERVICE SINK (P-505). PROVIDE NEW 4" SAN AND 2" VENT TO FIXTURE.
- 7 PROVIDE NEW DOUBLE COMPARTMENT CRS SINK AND FAUCET (P-524). PROVIDE NEW 1 1/2" SAN AND 1 1/2" VENT PIPING TO FIXTURE.
- 8 2" UNDER SLAB VENT PIPING FROM FD. ROUTE TO VTR.
- 9 PROVIDE NEW WALL-HUNG SERVICE SINK AND FAUCET (P-514). PROVIDE NEW 1 1/2" SAN AND 1 1/2" VENT PIPING TO FIXTURE.
- 10 PROVIDE NEW FLOOR STANDING ICE MAKER, PROVIDE NEW 1 1/2" SAN AND 1 1/2" VENT PIPING FROM UNIT.
- 11 CONTRACTOR TO INSTALL VA FURNISHED/SUPPLIED RECESSED DIALYSIS UNIT. COORDINATE WORK WITH WATER TREATMENT CONTRACTOR THROUGH COR. PROVIDE 1 1/2" SAN AND VENT PIPING AND CONNECT TO UNIT.

(X) DEDUCT ALTERNATES


1. ALTERNATE BID ITEM 7: WATER CLOSET (P-101), LAVATORY (P-418) AND FLOOR DRAINS TO BE OMITTED FROM ROOM 83-A AND 83-B IN ALT. DESIGN.
2. ALTERNATE BID ITEM 7: CRS SINK (P-528) TO BE OMITTED FROM ROOM 83 IN ALT. DESIGN.
3. ALTERNATE BID ITEM 8: WATER COOLERS (P-604) TO BE REMOVED FROM WAITING AREA (48) AND RELOCATED ELSEWHERE ON BASEMENT LEVEL IN ALT. DESIGN.
4. ALTERNATE BID ITEM 8: WATER CLOSET (P-101) AND LAVATORY (P-418) IN FAMILY TOILET (50) TO BE RELOCATED IN ALT. DESIGN TO OPPOSITE (SOUTH) WALL.

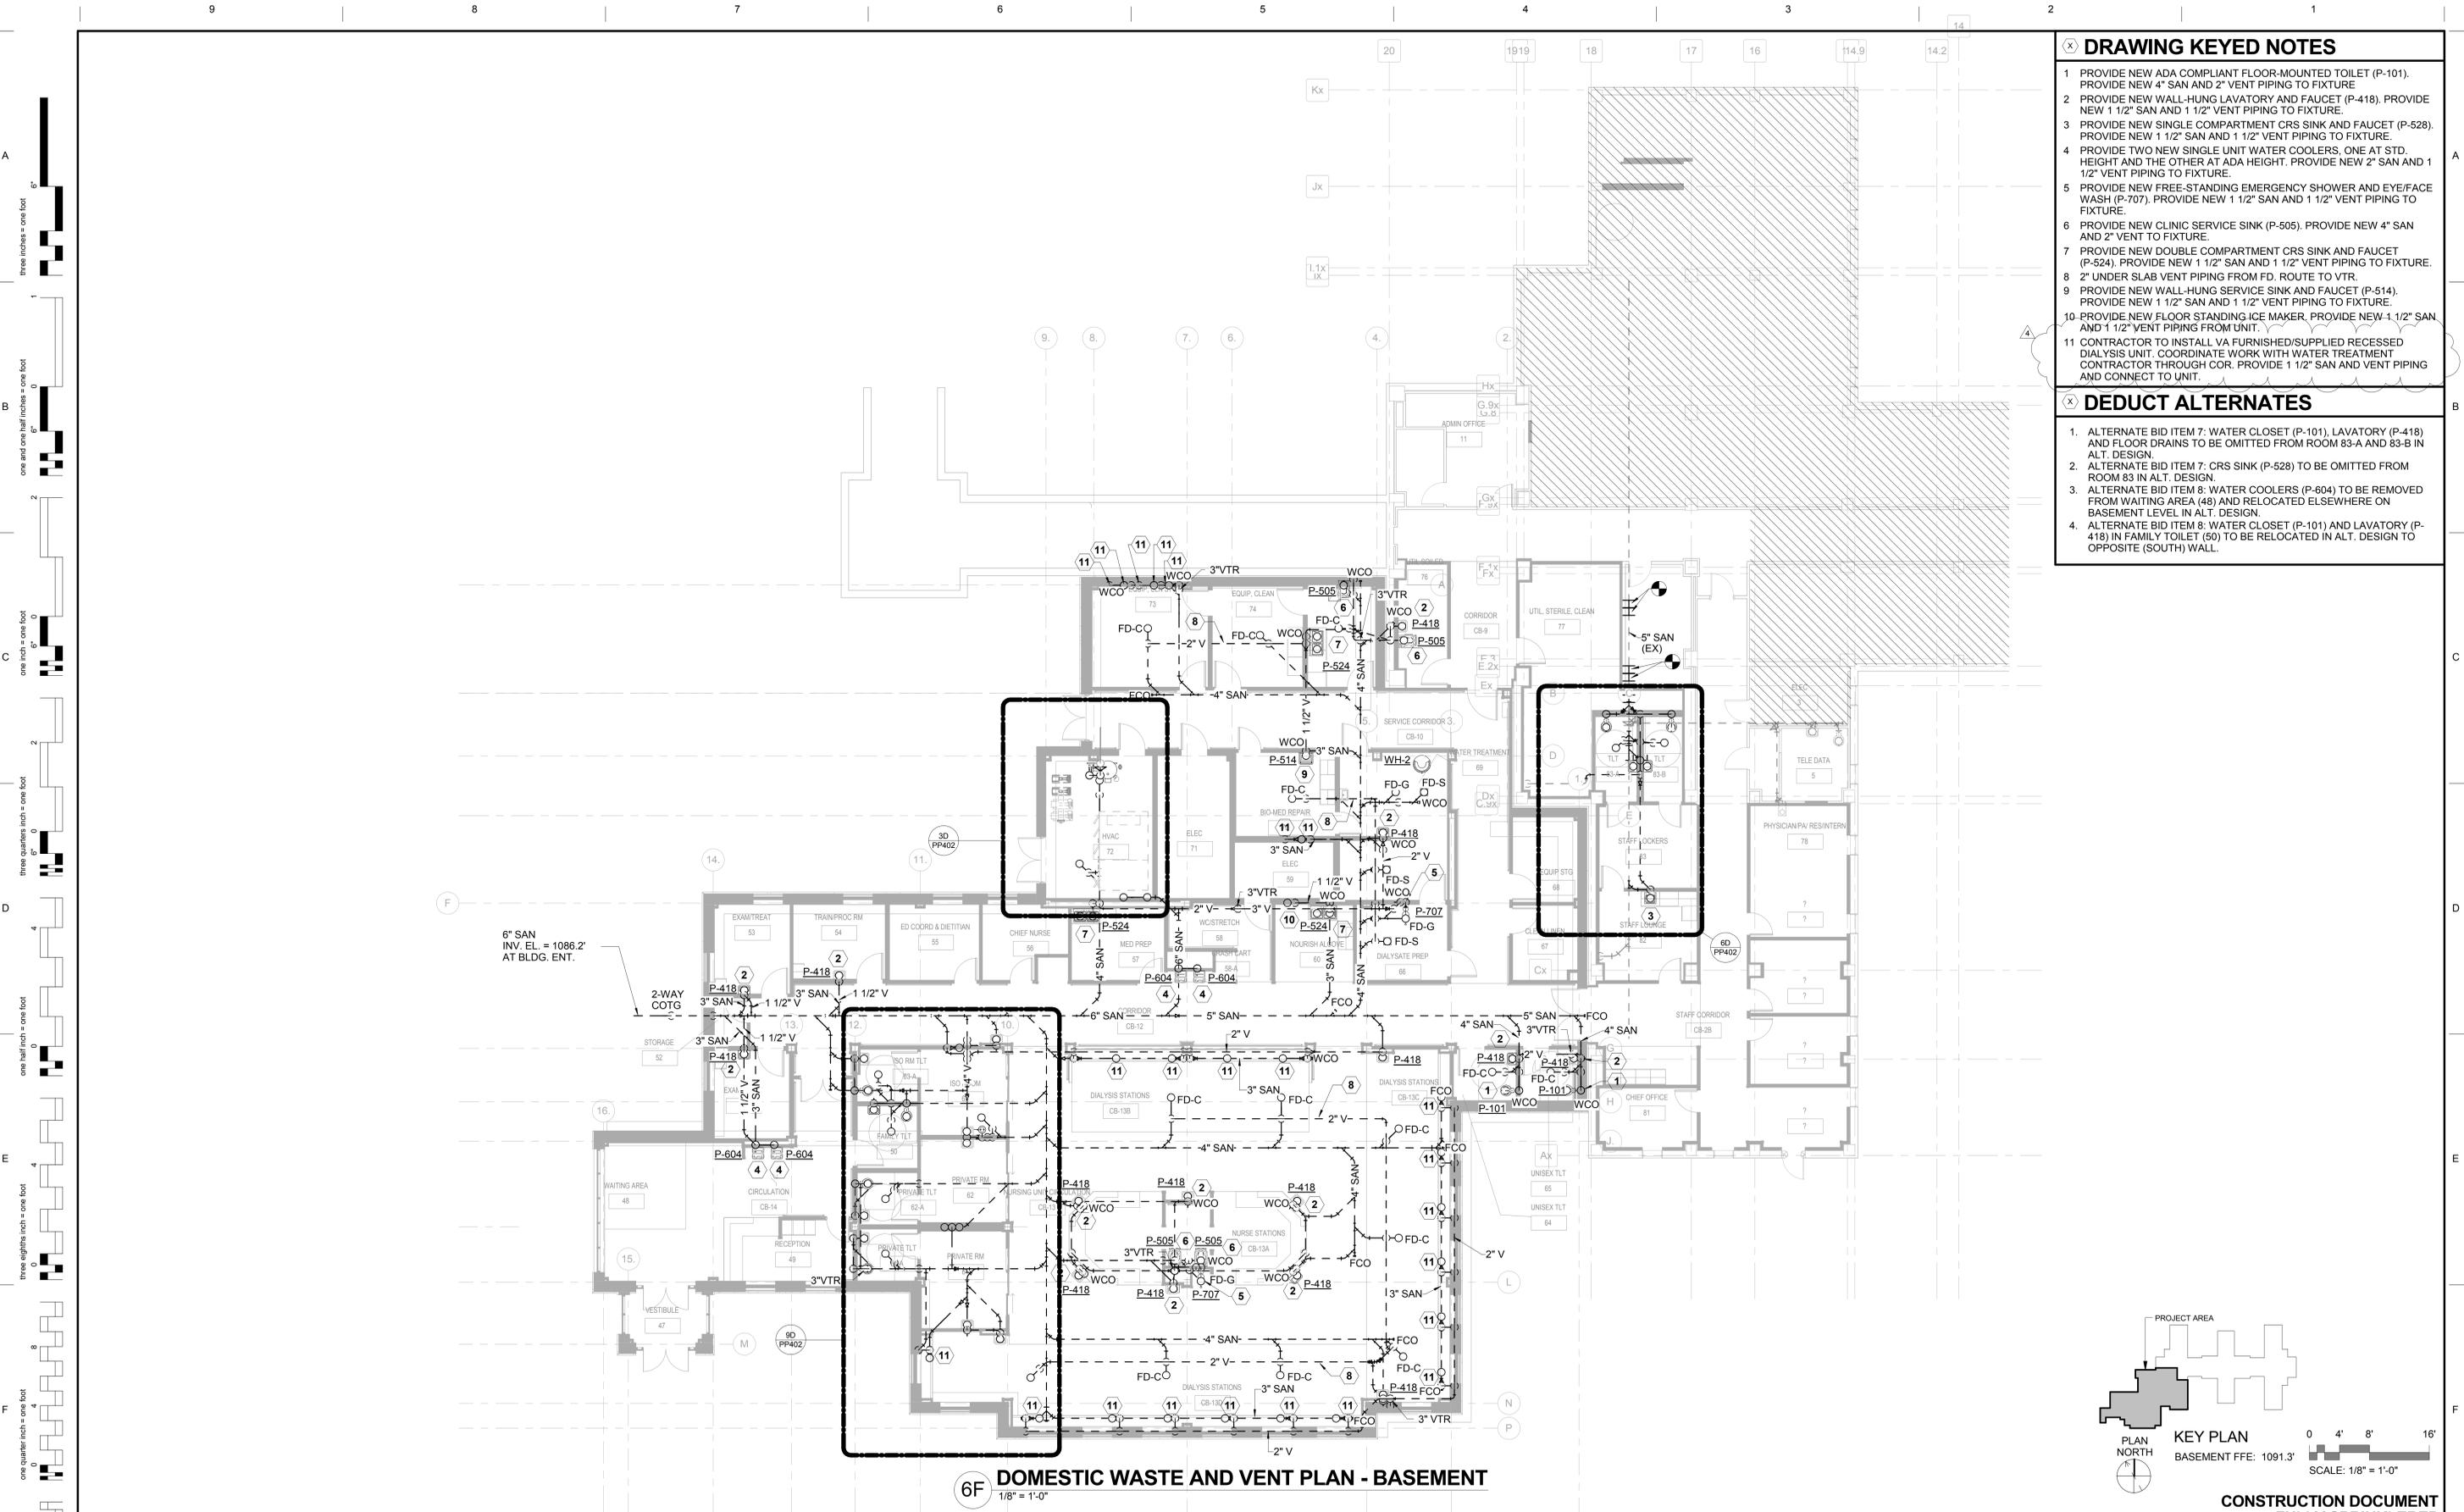

6F DOMESTIC WASTE AND VENT PLAN - BASEMENT
1/8" = 1'-0"

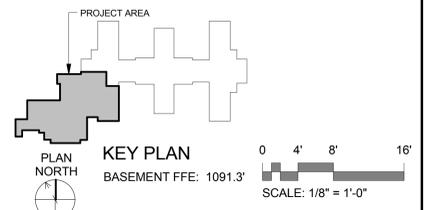

CONSTRUCTION DOCUMENT FULLY SPRINKLERED

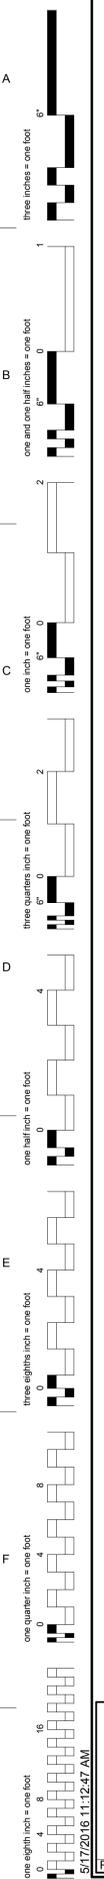

<p>Corporate Office: 766 Middle St. Fairhope, AL 36532 Phone: 251.990.5778 Fax: 251.990.3716</p>	Approved: Patient Safety Nurse	Approved: Energy Engineer	Approved: Safety Manager	Approved: Service Chief	Drawing Title DOMESTIC WASTE AND VENT PLAN - BASEMENT	Project Title RELOCATE AND EXPAND RENAL DIALYSIS	Date 2016.01.22
	Approved: Chief of Police	Approved: Infection Control Officer	Approved: Chief of Staff	Approved: Chief of Facility Management Svc.			Building Number 2
	Approved: Chief of Mental Health Service	Approved: GEMS Coordinator	Approved: Associate Director	Approved: Medical Center Director	Location SALEM VA MEDICAL CENTER	Drawing No. PL102	Sheet 90 of 144
	4 ADDENDUM # Revisions:	5/16/16 Date					