


TAG	CONSTRUCTION DESCRIPTION
(C1)	CONTROL JOINT
(G1)	ALUM. WINDOW SYSTEM
(G2)	CURTAIN WALL SYSTEM WITH 1" CLEAR INSUL. GLAZING
(G3)	CURTAIN WALL SYSTEM WITH 1" FROSTED INSUL. SPANDREL GLAZING
(D1)	INSUL. ALUM. ENTRY DOOR
(D2)	INSUL. HM DOOR
(D3)	INSUL. SECT. WALL OVERHEAD DOOR
(L1)	PREFINISHED METAL LOUVERS
(M1)	PREFINISHED METAL PANEL RAINSCREEN SYSTEM
(M2)	PRECAST SIL BY WINDOW MNFG
(P1)	SEALANT, COLOR TO MATCH EXISTING SURFACE
(R1)	FULLY - ADHEAR EPDM ROOFING MEMBRANE
(RD)	ROOF DRAIN (5C/A903)
(RS)	ROOF SCUPPER
(S1)	REINFORCE CONCRETE STAIR

Deduct	
1	Delete one elevator (shaft to remain)
2	Delete the generator
3	Delete the glazing and HVAC components from the overhead connector
4	Delete Terazzo tile from floors and walls of corridors & lobbies
5	Use storefront windows in lieu of curtain wall
6	Paint in lieu of tile
7	Delete the penthouse structure
8	Fixed furnishings in lieu of Herman Miller
9	Use T5 28 watt lighting in lieu of LED lighting
10	Use stucco in lieu of brick
11	Delete the entire overhead connector

DEDUCT #7:
DELETE THE PENTHOUSE STRUCTURE. MEP EQUIPMENTS EXPOSED.

DEDUCT #11:
DELETE THE ENTIRE OVERHEAD CONNECTOR AND LEAVE BUILDING 106 AS IS CURRENTLY. ALL DEMO NOTES AND PLAN FOR BUILDING 106 SHALL NOT APPLY.

THE 2ND FLOOR LOBBY SHALL BE A (38) WINDOW TYPE INSTEAD OF A DOOR SHOWN.

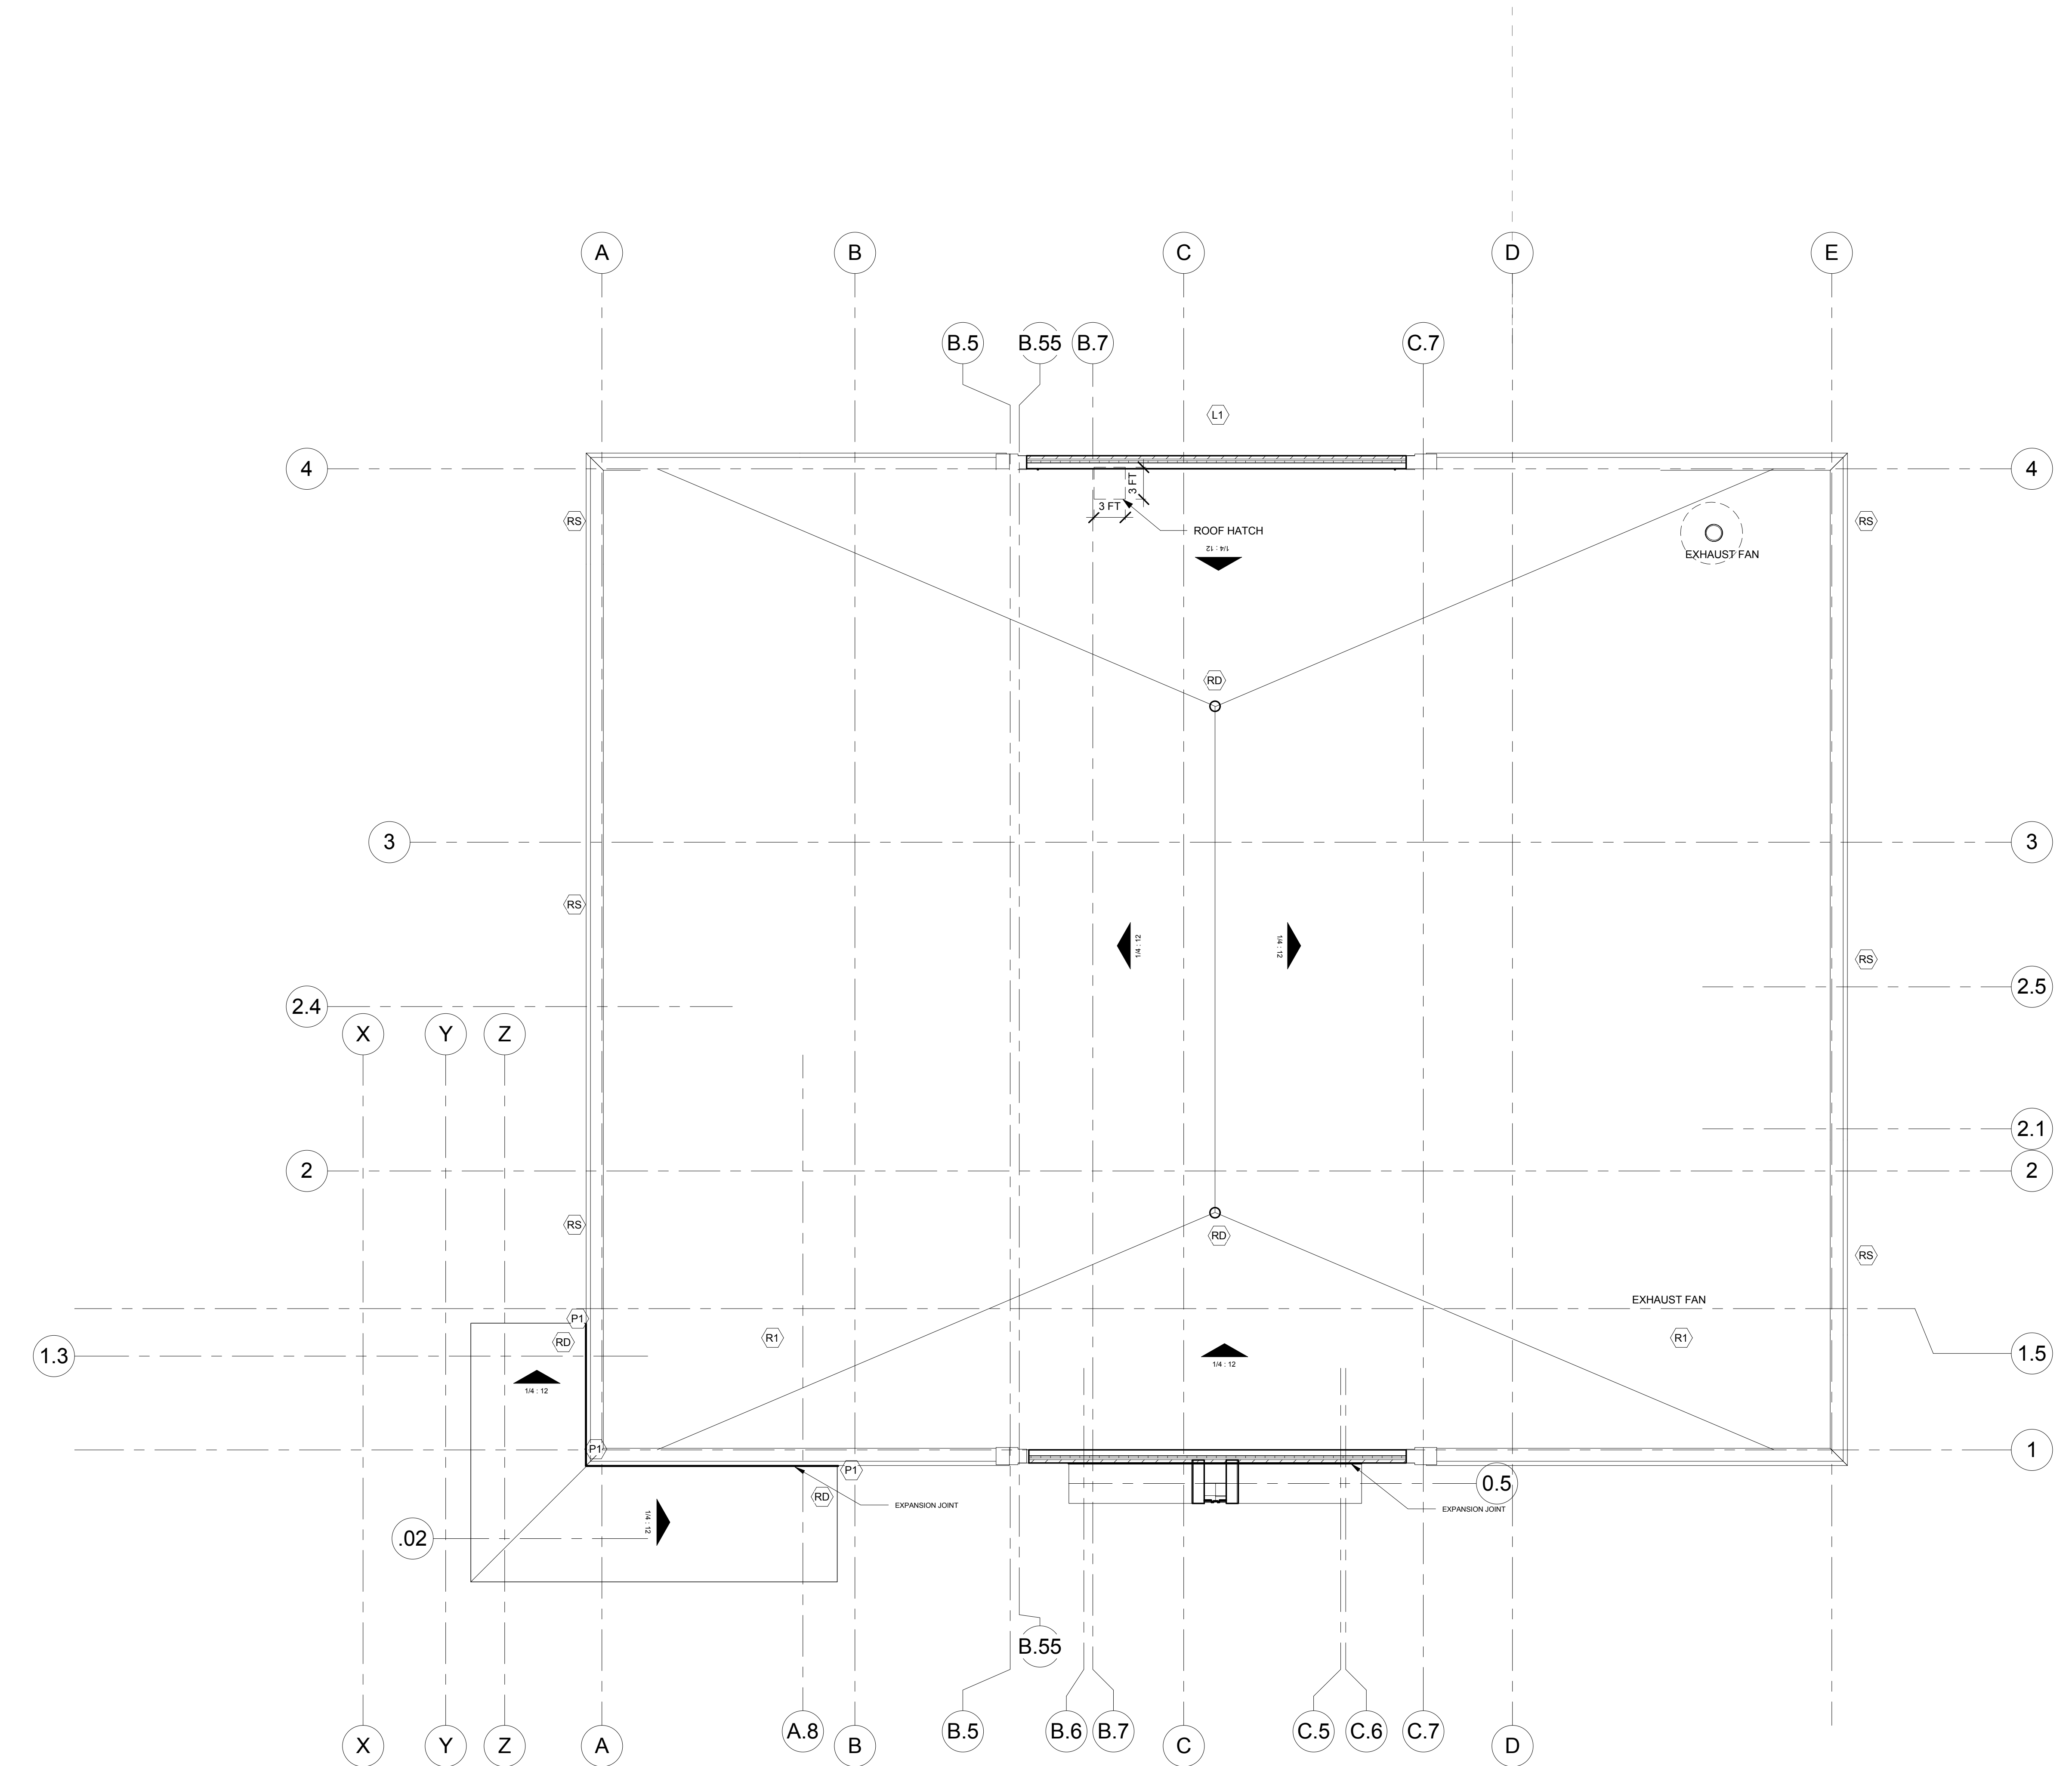

100% CONSTRUCTION DOCUMENTS

		CONSULTANTS:						ARCHITECT/ENGINEERS:  <small>URS architects • engineers • planners</small>  Accord Architects & Engineers		Drawing Title ROOF PLAN- PENTHOUSE DEDUCT		Project Title CONSTRUCT CLINIC ADDITION TRACK 3 CLINIC BUILD		Project Number 544-302		<div>Office of Facilities Management</div> <div> Department of Veterans Affairs</div>	
		 ROWE PROFESSIONAL SERVICES COMPANY Engineering • Surveying • Aerial Photography / Mapping Landscape Architecture • Planning 511 Broadway Street, Myrtle Beach, SC 29577 Tel: 843.444.1020 www.rowesp.com Fax: 843.448.3936						Approved: Project Director		Location WJBD VA MEDICAL CENTER COLUMBIA, SC 29209		Drawing Number A-203A					
Revisions:		Dates								Date 07/30/2015		Checked Checker		Drawn Author			