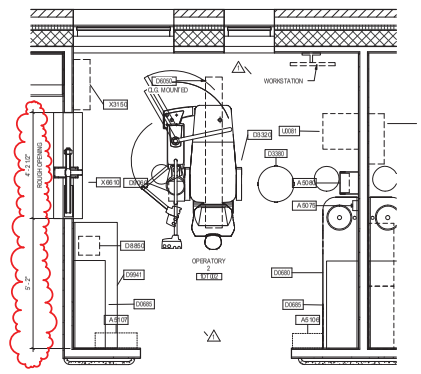

2 TYPICAL DENTAL EXAM ROOM
AI-302 1/2" = 1'-0"

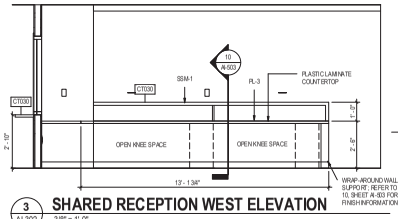

3 SHARED RECEPTION WEST ELEVATION
AI-302 3/8" = 1'-0"

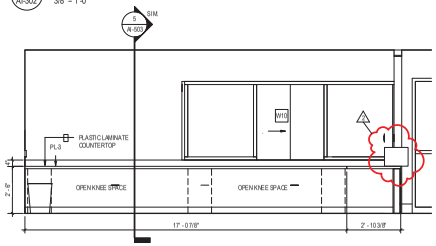

4 SHARED RECEPTION SOUTH ELEVATION
AI-302 3/8" = 1'-0"

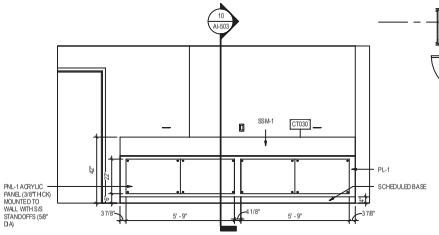

5 SHARED RECEPTION EAST ELEVATION
AI-302 3/8" = 1'-0"

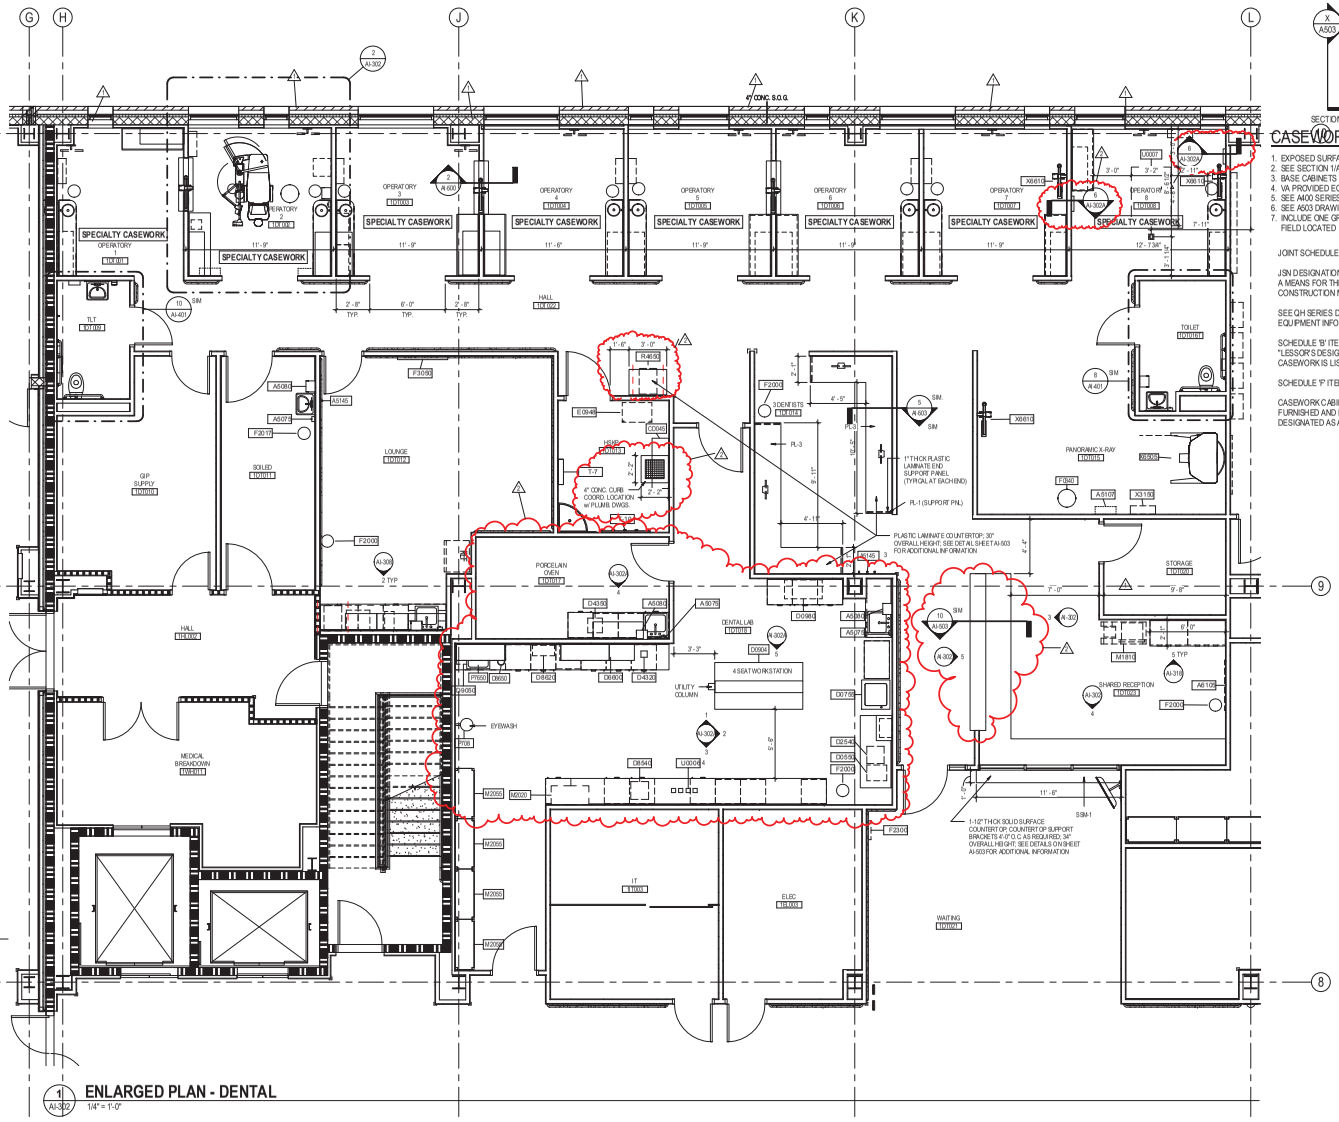

1 ENLARGED PLAN - DENTAL
AI-302 1/4" = 1'-0"

X AI503 — ELEVATION TAG
AEXXX — JSN NUMBER
SECTION TAG

CASEWORK GENERAL NOTES:

1. EXPOSED SURFACES TO BE PLASTIC LAMINATE U.O.N.
2. SEE SECTION 11A503 FOR TYPICAL WALL AND BASE CABINET DETAIL
3. BASE CABINETS TO RECEIVE RUBBER BASE U.O.N.
4. VA PROVIDED EQUIPMENT DASHED FOR REFERENCE ONLY
5. SEE A400 SERIES DRAWINGS FOR ENLARGED TOILET ROOM PLANS
6. SEE A503 DRAWING FOR CASEWORK SECTIONS AND DETAILS
7. INCLUDE ONE GROMMET PER 5 LF OF PLASTIC LAMINATE COUNTERTOP; FIELD LOCATED

JOINT SCHEDULE NUMBERS (JSN)

JSN DESIGNATIONS ARE USED TO TAG SCHEDULED EQUIPMENT AND AS A MEANS FOR THE VA TO RECONCILE SPECIFIC BUDGETS WITH THE CONSTRUCTION MANAGER (i.e. CASEWORK)

SEE QH SERIES DRAWINGS FOR JSN SCHEDULE 'B' AND SCHEDULE 'F' EQUIPMENT INFORMATION.

SCHEDULE 'B' ITEMS ARE TO BE FURNISHED AND INSTALLED BY THE "LESSOR'S DESIGNEE" OR "GENERAL CONTRACTOR/SUBCONTRACTOR. CASEWORK IS LISTED AS SCHEDULE 'B' ITEMS.

SCHEDULE 'F' ITEMS ARE TO BE FURNISHED AND INSTALL BY THE VA.

CASEWORK CABINETS, WALL CABINETS, AND COUNTERTOPS SHALL BE FURNISHED AND INSTALLED BY THE CASEWORK SUBCONTRACTOR UNLESS DESIGNATED AS A VENDER PURCHASED ITEM.

CONSTRUCTION DOCUMENT CD-2
As indicated

Number	Revision	Issued To	Issued By
2	Bulletin No. 7	16-03-24	
1	Bulletin No. 5	16-03-07	

Stantec
400 MORGAN CENTER
101 EAST DIAMOND STREET
BUTLER, PA 16001
www.stantec.com

The Contractor shall verify and be responsible for all dimensions. DO NOT scale the drawing - any errors or omissions shall be reported to Stantec without delay.
The Copyrights to all designs and drawings are the property of Stantec. Reproduction or use for any purpose other than that authorized by Stantec is forbidden.

BARBER & HOFFMAN, INC.
Consulting Engineers
215 Executive Drive, Suite 202
Cranberry Township, PA 16066
724-741-0849/ (f) 724-741-0849
barberhoffman.com

CAVEO HINMAN CONSULTING ENGINEERS
1821 Cumberland Avenue, Suite 100
Charlotte, NC 28203
704-348-3097
www.caveoeng.com

1800 Diagonal Road, Suite 525 |
Alexandria, VA 22314
P 703.416.6780 | F 703.836.4423
www.hcai.com

Cambridge HEALTHCARE SOLUTIONS PA, LP
evolve environment | architecture

Drawing Title	ENLARGED PLAN - DENTAL
	2
Approved: Project Director	Butler VA
Project Title	Butler VA
Location	353 North Duffy Road, Butler, PA 16001
Date	2016.02.19
Checked	
Drawn	
Project Number	218010805
SPO NO.	VA-101-10-RP-0105
Building Number	
Drawing Number	AI-302
Dwg.	of 99

Office of Construction and Facilities Management
Department of Veterans Affairs

3/24/2016 3:19:01 PM
C:\...\ORIGINAL SHEET - ARCH E1 BASE
3/24/2016 3:19:01 PM