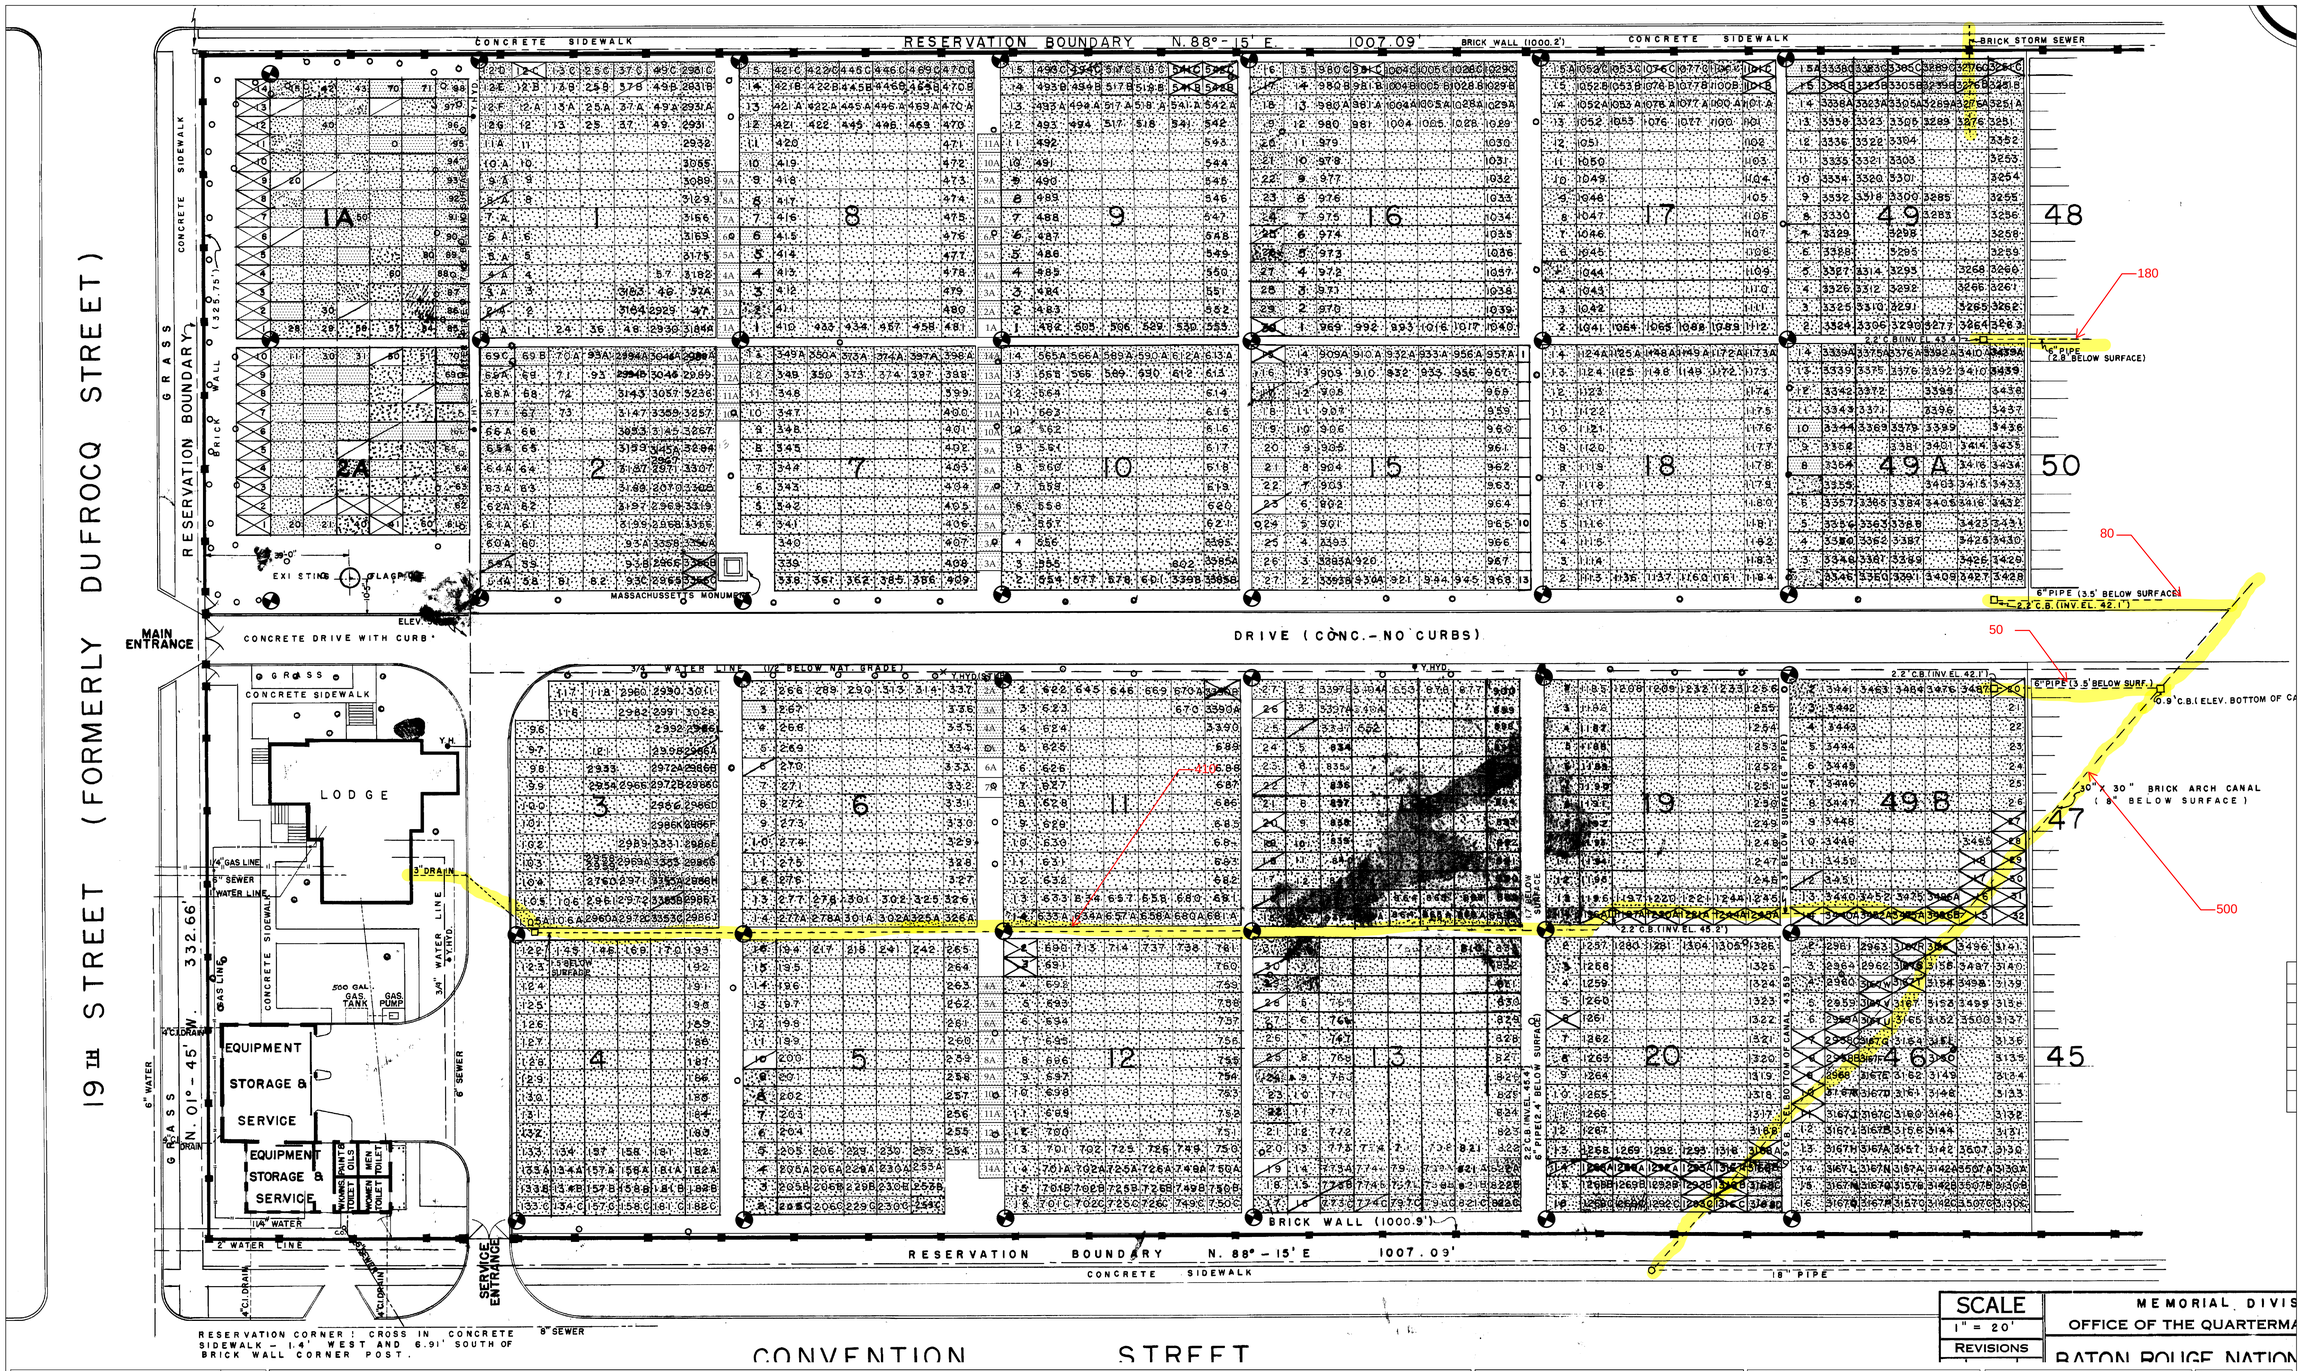

SCALE	MEMORIAL DIVIS
1" = 20'	OFFICE OF THE QUARTERMA
REVISIONS	BATON ROUGE NATION

Revisions	Date
Added Control Marker As-Builts	12/15/11
Sem-Annual Update	9/12/11
Sem-Annual Update	3/16/11
Sem-Annual Update	9/17/10
Sem-Annual Update	3/23/10
Sem-Annual Update	8/4/09

CAPACITY IN GRAVESITEs

SECTION	SIZE OF GRAVESITE	TOTAL	SET ASIDE	AVAIL	OBST	REMARKS

Scale : NTS

LEGEND
- AVAILABLE GRAVESITE
- SET ASIDE
- OBSTRUCTED GRAVESITE
- OCCUPIED GRAVESITE
- GRAVES FACE
- GRAVESITE CONTROL MONUMENT

National Cemetery Administration
Memorial Service Network II
Decatur, Georgia 30033

Drawing Title: Sections 1-20, 46, 49A and 49B Layout Drawing

Project: Baton Rouge National Cemetery
Location: Baton Rouge, LA

Date: 3/25/10
Project No.:

Approved: Area Director
Approved: Cemetery Director
Building Number
Checked
Drawn: DCJ

Path: \\Cematla101\share\MSN II Drawings\Baton Rouge\Updated Layout

Drawing Title: 829LA200
Dwg. Of

VA FORM 08-6231, FEB. 1983

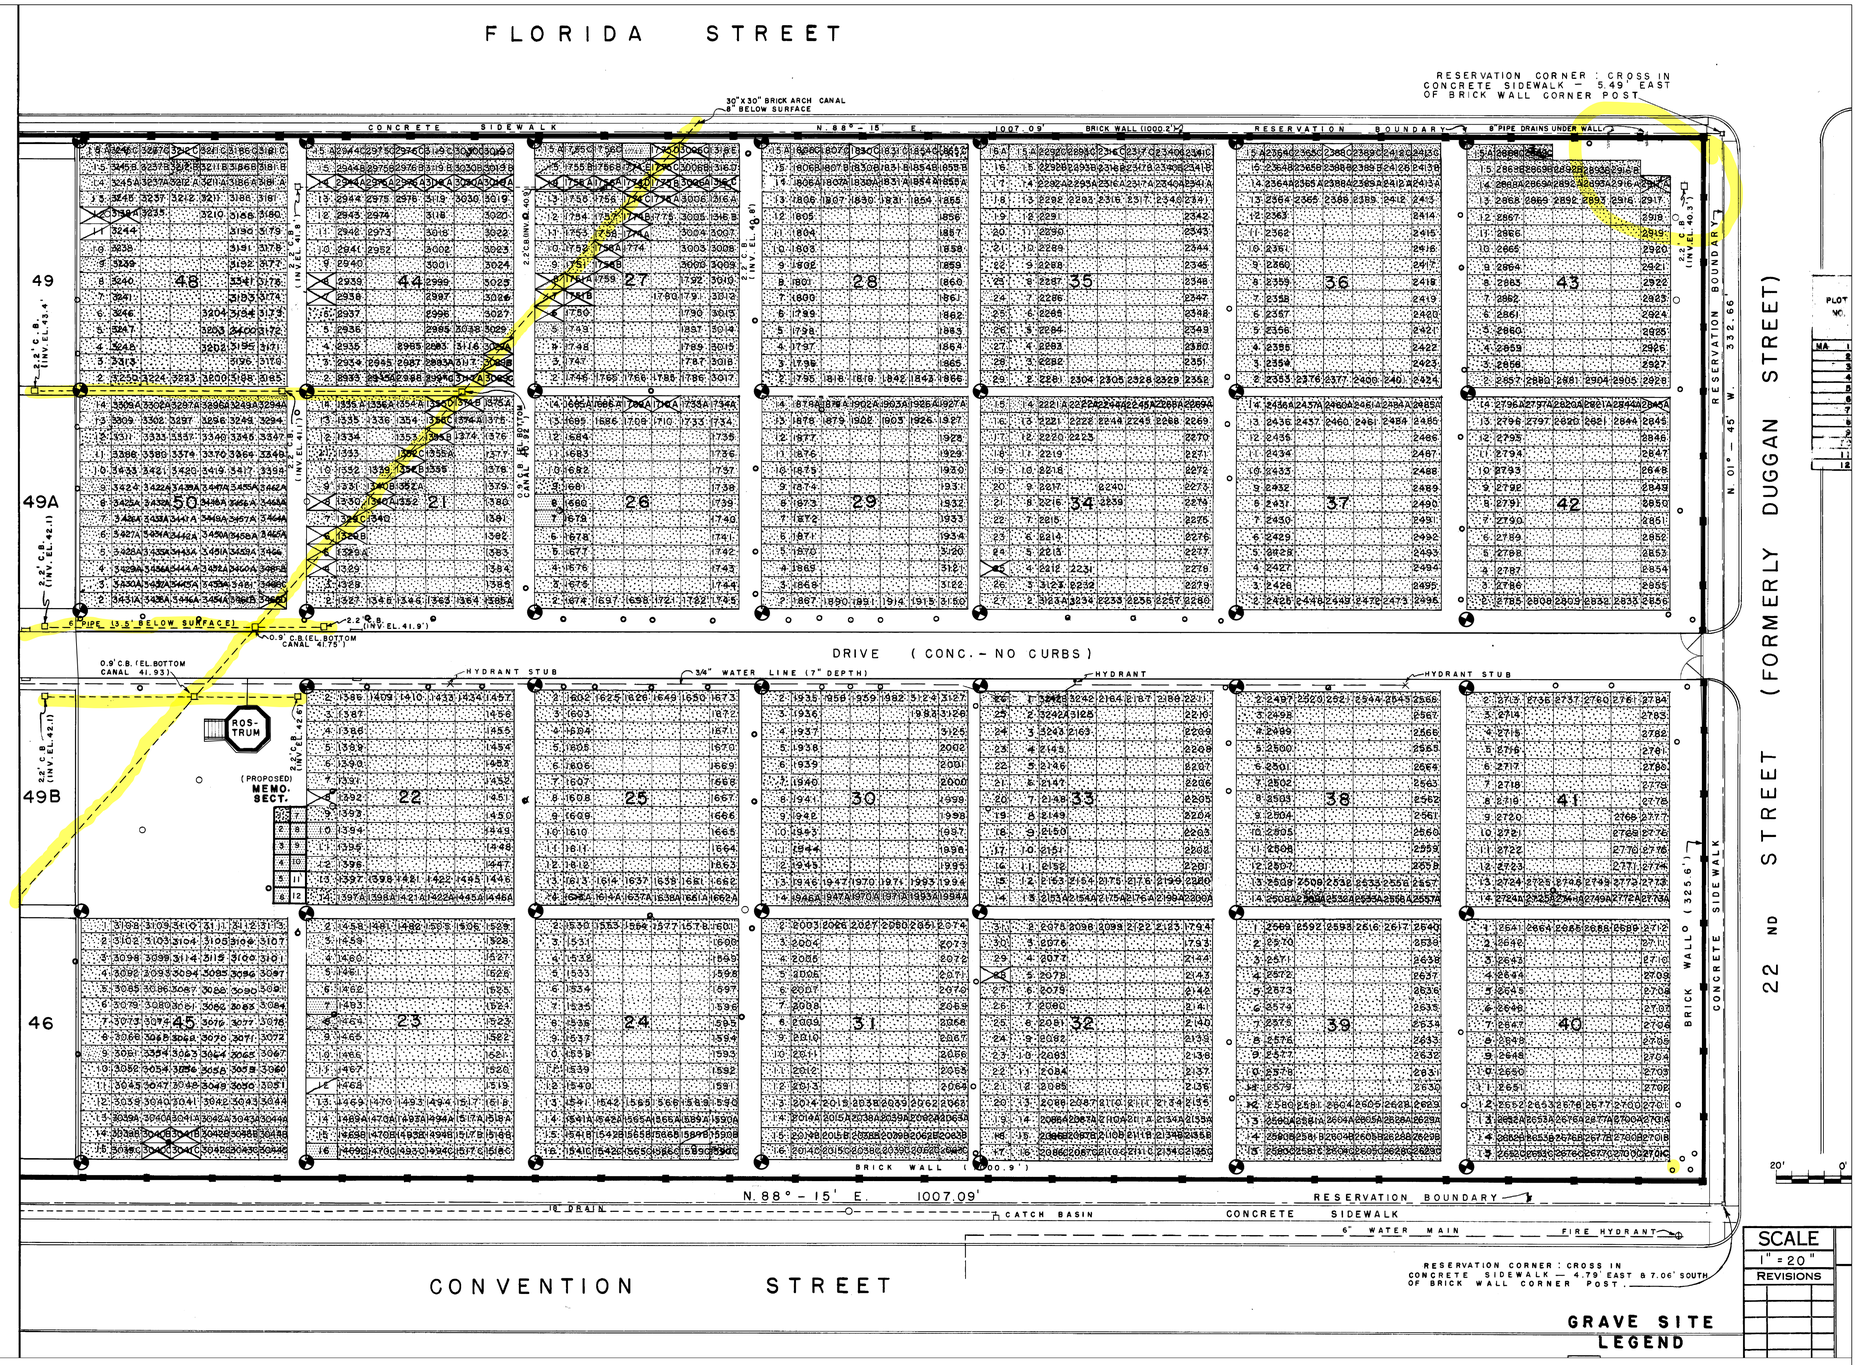

SCALE
1" = 20"
REVISIONS

GRAVE SITE LEGEND

Semi-Annual Update	12/15/11
Semi-Annual Update	9/13/11
Semi-Annual Update	3/16/11
Semi-Annual Update	9/17/10
Semi-Annual Update	3/23/10
Semi-Annual Update	8/4/09
Revisions	Date

CAPACITY IN GRAVESITEs

SECTION	SIZE OF GRAVESITE	TOTAL	SET ASIDE	AVAIL	OBST	REMARKS

Scale : NTS

LEGEND
- AVAILABLE GRAVESITE
- SET ASIDE
- OBSTRUCTED GRAVESITE
- OCCUPIED GRAVESITE
- GRAVES FACE
- GRAVESITE CONTROL MONUMENT

National Cemetery Administration
Memorial Service Network II
Decatur, Georgia 30033

Drawing Title: Sections 21-46 Layout Drawing

Project: Baton Rouge National Cemetery
Location: Baton Rouge, LA

Date: 3/25/10
Project No.

Approved: Area Director
Approved: Cemetery Director
Building Number
Checked
Drawn: DCJ
Path: \\Cematla101\share\MSN II Drawings\Baton Rouge\Updated Layout

Drawing Title: 829LA300 Section 21-46
Dwg. Of

VA FORM 08-6231, FEB. 1983