



SHEET NOTES

KEY NOTES

1. CUT AND REMOVE EXISTING COMPRESSED AIR PIPING & ALL RELATED APPURTENANCES UP TO FLOOR PENETRATION AND CAP PIPING BELOW FLOOR. PATCH FLOOR AND CAP PIPING. ABANDON PIPING AT FLOOR BELOW.

100% CD/BID SUBMISSION
FEBRUARY 2, 2016


65% CD SUBMISSION	03/16/15
100% CD/BID SUBMISSION	02/03/16
Addendum #1 delete square box key note on plan	05/19/16
Revisions:	Date

CONSULTANTS:

MAZZETTI
220 Montgomery Street, Suite 650
San Francisco, CA 94104
TEL: 415.632.3366
www.mazzetti.com
PROJECT NUMBER: 130-085



ARCHITECT

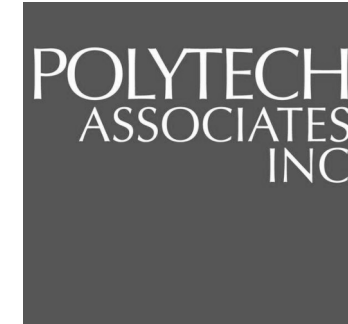

POLYTECH ASSOCIATES INC.
235 Pine Street, 17th Floor
San Francisco, CA 94104
TEL (415) 397-3117
FAX (415) 397-1517

Drawing Title
PLUMBING PIPING FIRST FLOOR PLAN - TRAINING CENTER

Approved: Project Director

Project Title
POST TRAUMATIC STRESS DIAGNOSIS (PTSD)
EXPANSION AND RENOVATION

Location
795 WILLOW ROAD, MENLO PARK, CA

Date
01/05/16

Checked
Author

Drawn
Checker

Project Number
612-125

Building Number
Building 334

Drawing Number

334TC PL201

Office of
Construction
and Facilities
Management

