

V. A. Medical Center
VAMC NEW ORLEANS
2400 Canal St
New Orleans, LA 70119


Southeast Louisiana Veterans Health Care System (SLVHCS)


Fixed Cysto Table

Salient Characteristics:


- Operating System: If Windows-based, must run on Windows 7 or newer
- 16"x16" flat panel detector
- 2 Color monitors at table
- Reference monitor at workstation
- Table must hold patient weight of 500 lbs or more
- Unrestricted patient access from all sides of the table
- HD Interface for displaying external video signals
- Capability of sending images to an additional monitor
- Urodynamics measurement system
- DICOM compliant
- Vista Imaging Approved
- The entire system is capable of being operated by the urologist while doing the procedure
- Ergonomic footswitch for controlling table lift, table tilt, table longitudinal and transverse movement
- Handheld control
- Built in holder for drain bag
- Initial start-up inventory for drain bags
- Tissue Screen Included
- Heavy Duty stirrups
- Built-in capability to measure dose area product
- Capable of displaying live dose ratings
- Features to limit radiation to staff and patient
- Capability to import and view images from other modalities and other vendors
- Fluoroloop
- Pulsed Fluoroscopy with at least 5 settings on pulses/second ≤ 30 pulses/second
- Table Travel: Longitudinal>50cm, Transverse>12cm, Vertical>72cm-122cm
- Tilt
 - Trendelenburg at least 0°-20°
 - Reverse Trendelenburg at least 0°-85°
- Mattress Pad Included
- High Frequency X-Ray generator
- X-Ray tube stand or fixed tube arm with left or right orientation
- HIPPA compliant
- Onsite initial clinical training—32 hours
- Onsite follow-up clinical training—16 hours

- **The equipment must fit in the existing room without any construction modifications (see attached drawings). This equipment will go in room 3J260.**
- **There is no drain in the room.**
- **There shall be no ceiling-mounted components.**
- **The ceiling in the room is 9'0" and there is a ceiling-mounted lift and exam light already installed in the room.**
- Installation
- Two sets of operator and service manuals
- Biomed training to include travel and lodging for 2 staff

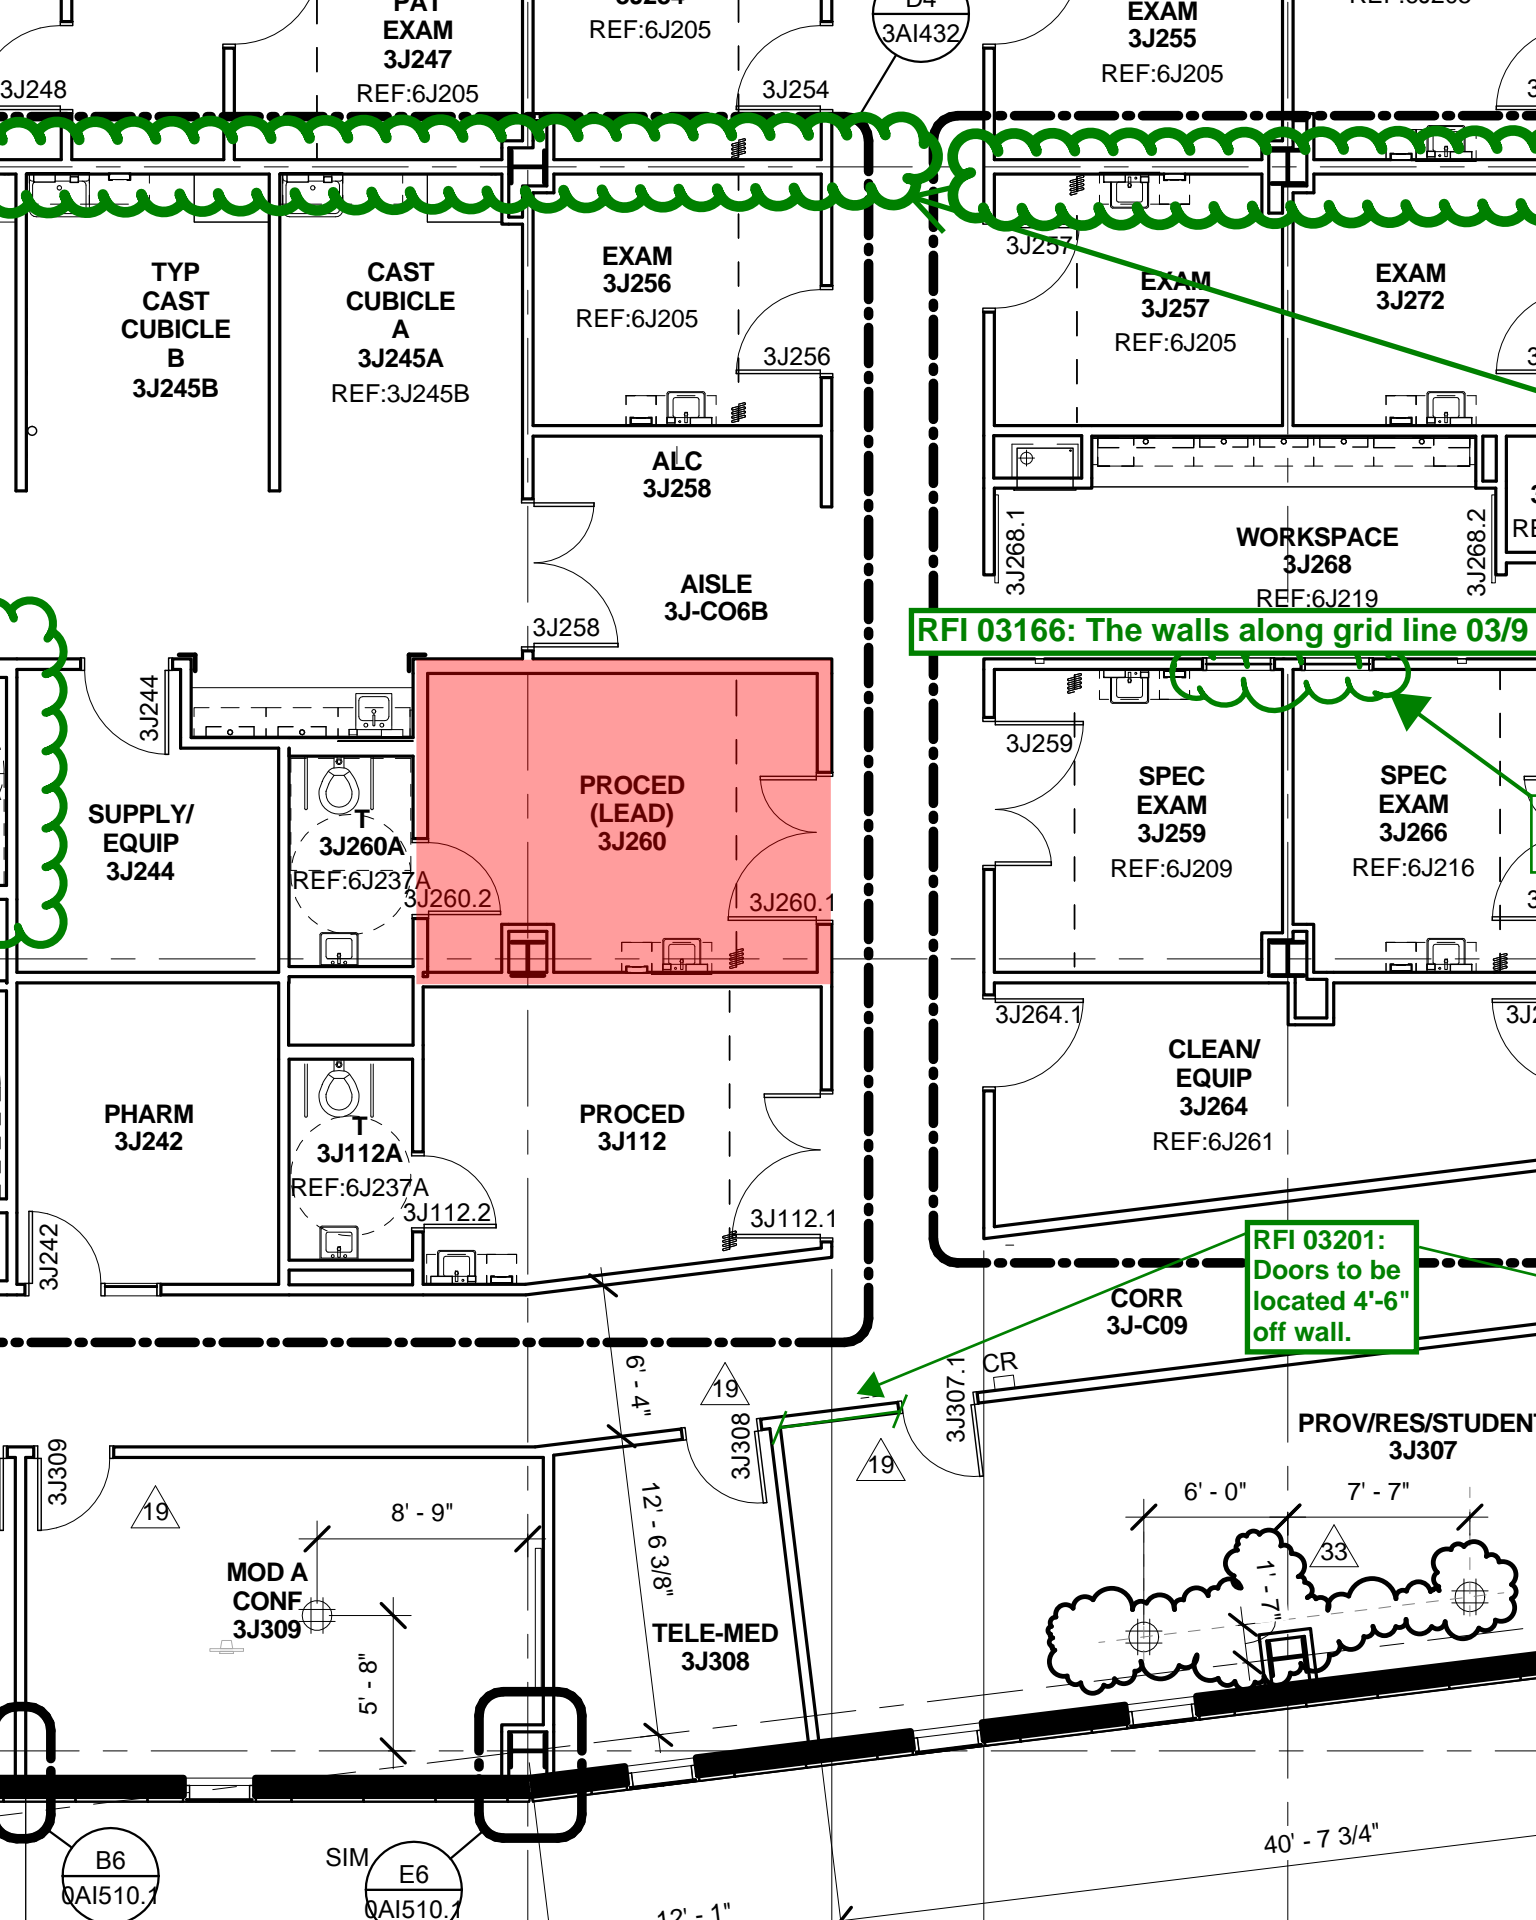

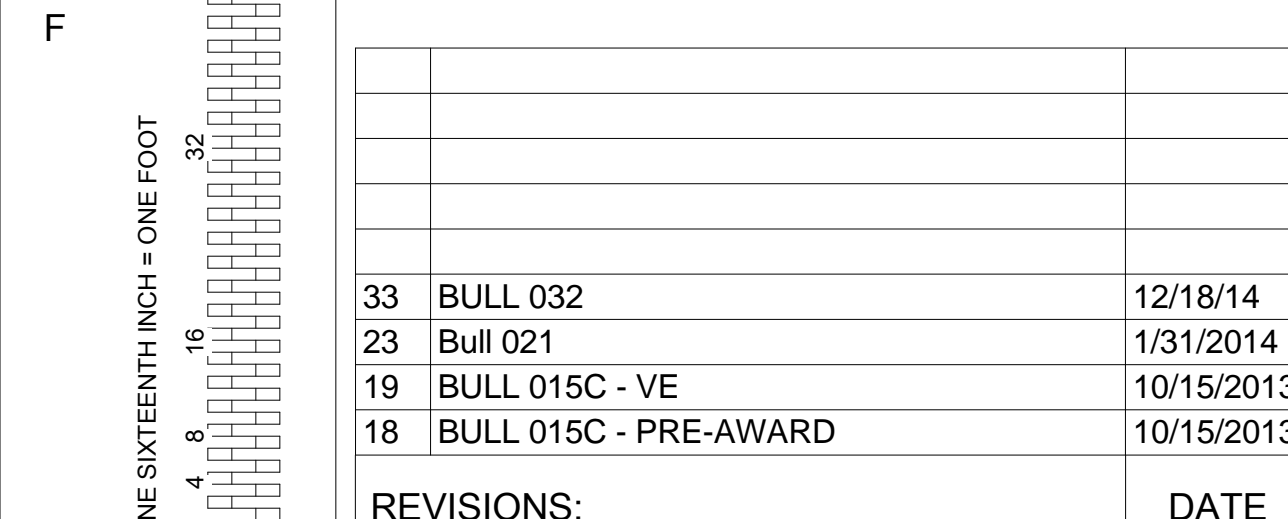

CONSULTANTS:
 DESMAN ASSOCIATES / PARKING
 CODE CONSULTANTS, INC. / CODE CONSULTANT
 THE SEXTANT GROUP / AV & ACOUSTICAL
 HAMMER DESIGN ASSOCIATES / FOOD SERVICE
 PYBURN & ODOM / ABATEMENT
 TATA & HOWARD / TANK CONSULTANT
 I.S.C. GROUP, INC. / IRRIGATION
 DAN EUSER WATER ARCHITECTURE, INC. / WATER FEATURE

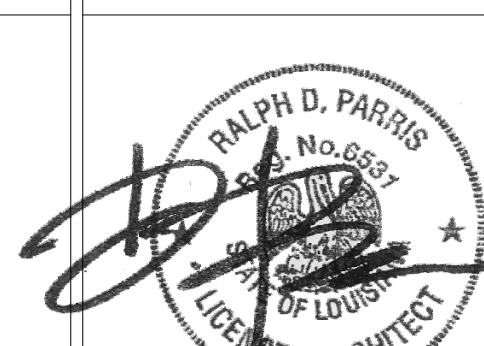

ARCHITECT/ENGINEERS:

studio **NOVA**

SCHRENK & PETERSON CONSULTING ENGINEERS / CIVIL
KORDA/NEMETH ENGINEERING / STRUCTURAL
BR+A CONSULTING ENGINEERS / MECH, ELECT, PLUMBING, LOW VOLTAGE
ARCHITECTURAL ENGINEERING / PLUMBING
SCALES ASSOCIATES / FIRE PROTECTION

DRAWING TITLE

BLDG 3 THIRD FLOOR PLAN - AREA J2

APPROVED: PROJECT DIRECTOR

	PROJECT TITLE SLVHCS REPLACEMENT MEDICAL CENTER PROJECT		
	LOCATION NEW ORLEANS, LOUISIANA		
	DATE February 29, 2012	CHECKED ML	DRAWN AG/DMH

		FULLY SPRINKLERED	
PROJECT NUMBER 629-HS2-401	BUILDING NUMBER 03	OFFICE OF CONSTRUCTION AND FACILITIES MANAGEMENT	
DOCUMENT SET PACKAGE WP_08			
DRAWING NUMBER 3A1103-J2			
		 Department of Veterans Affairs	

SEE SHEET 0A1201 FOR GRAB BAR MOUNTING
HEIGHTS AND DIMENSIONAL LAYOUT

TOILET WITH WALL MOUNTED UP-SWING GRAB BARS
10 28 00

SEE SHEET 0A1201 FOR GRAB BAR MOUNTING
HEIGHTS AND DIMENSIONAL LAYOUT

FLOOR PLAN SHEET NOTE SERIES BEGINS WITH NOTE 100
NOT ALL SHEET NOTES APPEAR ON EVERY SHEET

- 001 SLAB OPENING - REF STRUCTURAL DWGS
- 002 ALIGN PARTITIONS
- 003 LINE OF CURTAIN WALL SILL - REF EXTERIOR SERIES DWGS.
- 004 LINE OF HOISTWAY BELOW
- 005 AIR HANDLER UNIT - REF MECHANICAL DWGS
- 006 STEEL BRACING - REF STRUCTURAL DWGS
- 007 CONCRETE HOISTWAY PENETRATIONS - REF STRUCTURAL DWGS
- 008 ACCORDIAN FIRE DOOR - REF DOOR SCHEDULE
- 009 NOT USED
- 010 08 13 FLOOR VAULT DOOR - 36" X 36" - REF DTL E10A16B
- 011 ROOF/FLOOR/SLAB DRAIN LEADER - REF PLUMBING DWGS
- 012 ELECTRICAL PANEL - REF ELECTRICAL DWGS
- 013 MEDICAL GAS ZONE VALVE BOX/MEDICAL GAS ALARM PANEL - REF MED GAS DWGS
- 014 SLOPE FLOORING IN SHOWERTOILET ROOM TO FLOOR DRAIN
- 015 SLAB RECESS FOR DIMENSIONED SHELVING TRUCK - VFY RECESS DIMENSION W/ SHELVING MANUFACTURER.
- 016 14 91 34 TRASH/LINEN CHUTE & STATION: SEE DETAILS E06A0507
- 017 14 91 34 TRASH/LINEN CHUTE: NO LOADING STATION
- 018 14 91 34 TRASH/LINEN CHUTE: NO LOADING STATION @ LEVEL 01 FLOOR
- 019 SLAB PENETRATION - SEE DETAILS E04A0507
- 020 08 13 1 3/4 HOUR FIRE RATED ACCESS PANEL - 24" X 48"
- 021 ELECTRICAL RISERS - SEE PLANS SET ON F50A01E2 - REF ELEC DWGS
- 022 CONCRETE ENCASED ELECTRICAL FEEDERS ABOVE - REF STRUCTURAL & ELEC DWGS
- 023 09 27 02 GLASS FIBER REINFORCED GYPSUM COLUMN COVER - 36" Ø. UON.
- 024 BOLD DASHED LINE INDICATES ROUTE OF STRUCTURAL EXPANSION JOINT - REF STRUCTURAL DWGS. REFERENCE FLOOR PLAN LEGEND FOR INTERIOR EXPANSION JOINT COVER ASSEMBLY INFORMATION.
- 025 11 01 01 MARKER BOARD REF INTERIOR ELEV SHEET NOTE 207.
- 026 11 01 10 TACK BOARD REF INTERIOR ELEV SHEET NOTE 208.
- 027 10 08 01 FOLD-DOWN BENCH
- 028 10 08 01 FOLD-DOWN SHOWER SEAT
- 029 SLAB RECESS FOR WALK-OFF GRILLE - VFY RECESS DIMENSION W/ GRILLE MANUFACTURER FOR FLOOR FINISH PLANS FOR EXTENTS.
- 030 RECESS PLUMBING ROUGH-IN FOR FUTURE SINK - REF PLUMBING DWGS
- 031 BENT PLATE W/ TRAFFIC COATING WRAP @ WALL BASE - REF R30A01E6
- 032 LINE OF 2/HZR RATED SHUT ABOVE - REF DETAILS E1 & E3 SHIT 0A01507
- 033 05 05 01 ACCESS LADDER
- 034 10 33 11 WIRE MESH PARTITION
- 035 05 52 13 PIPE AND TUBE LEVELING
- 036 11 13 00 MANUA DOCK LUGGER AND BUMPERS
- 037 13 44 00 MODULAR MEZZANES (INT. STAIRS & WIRE MESH PTNS.
- 038 05 50 01 METAL GRATE CATWALK
- 039 WALL MOUNTED HAND SINK - REF PLUMBING DWGS
- 040 RECESSED EMERGENCY SHOWER AND EXPOSED STAINLESS STEEL SHOWER HEAD - REF PLUMBING DWGS
- 041 08 39 19 FLOOR BRACKETS - FLOOR PLANK SYSTEM - REF D50A01E11
- 042 CONG. W/ S/S GL. LI ELEV SHAFTS - REF STRUCT DWGS & DTL D20A01507
- 043 BENT PLATE W/ PEDESTRIAN TRAFFIC COATING WRAP - REF C30A01E6
- 044 PLENUM SYSTEM - SEE EXTERIOR DRAWINGS
- 045 CENTER PARTITION ON GRILLE
- 046 CENTER PARTITION ON MULLION
- 047 10 21 13 TOILET PARTITIONS
- 048 TOP OF SHAFT LID ASSEMBLY - REF DETAIL B40A04507
- 049 CONG CURB W/ PEDESTRIAN TRAFFIC COATING WRAP - REF D30A01E6
- 050 EIGHT (8) INCHES HAND SINK - REF PLUMBING DWGS
- 051 ELEVATOR PUMP CONTROL PANEL - REF PLUMB DWGS
- 052 ALIGN GYPSUM WALL ABOVE WITH THIS FACE OF CMU



CONSTRUCTION DOCUMENTS 1
FULLY SPRINKLERED