


1
2
3
4
5
6
7
8
9

0
1
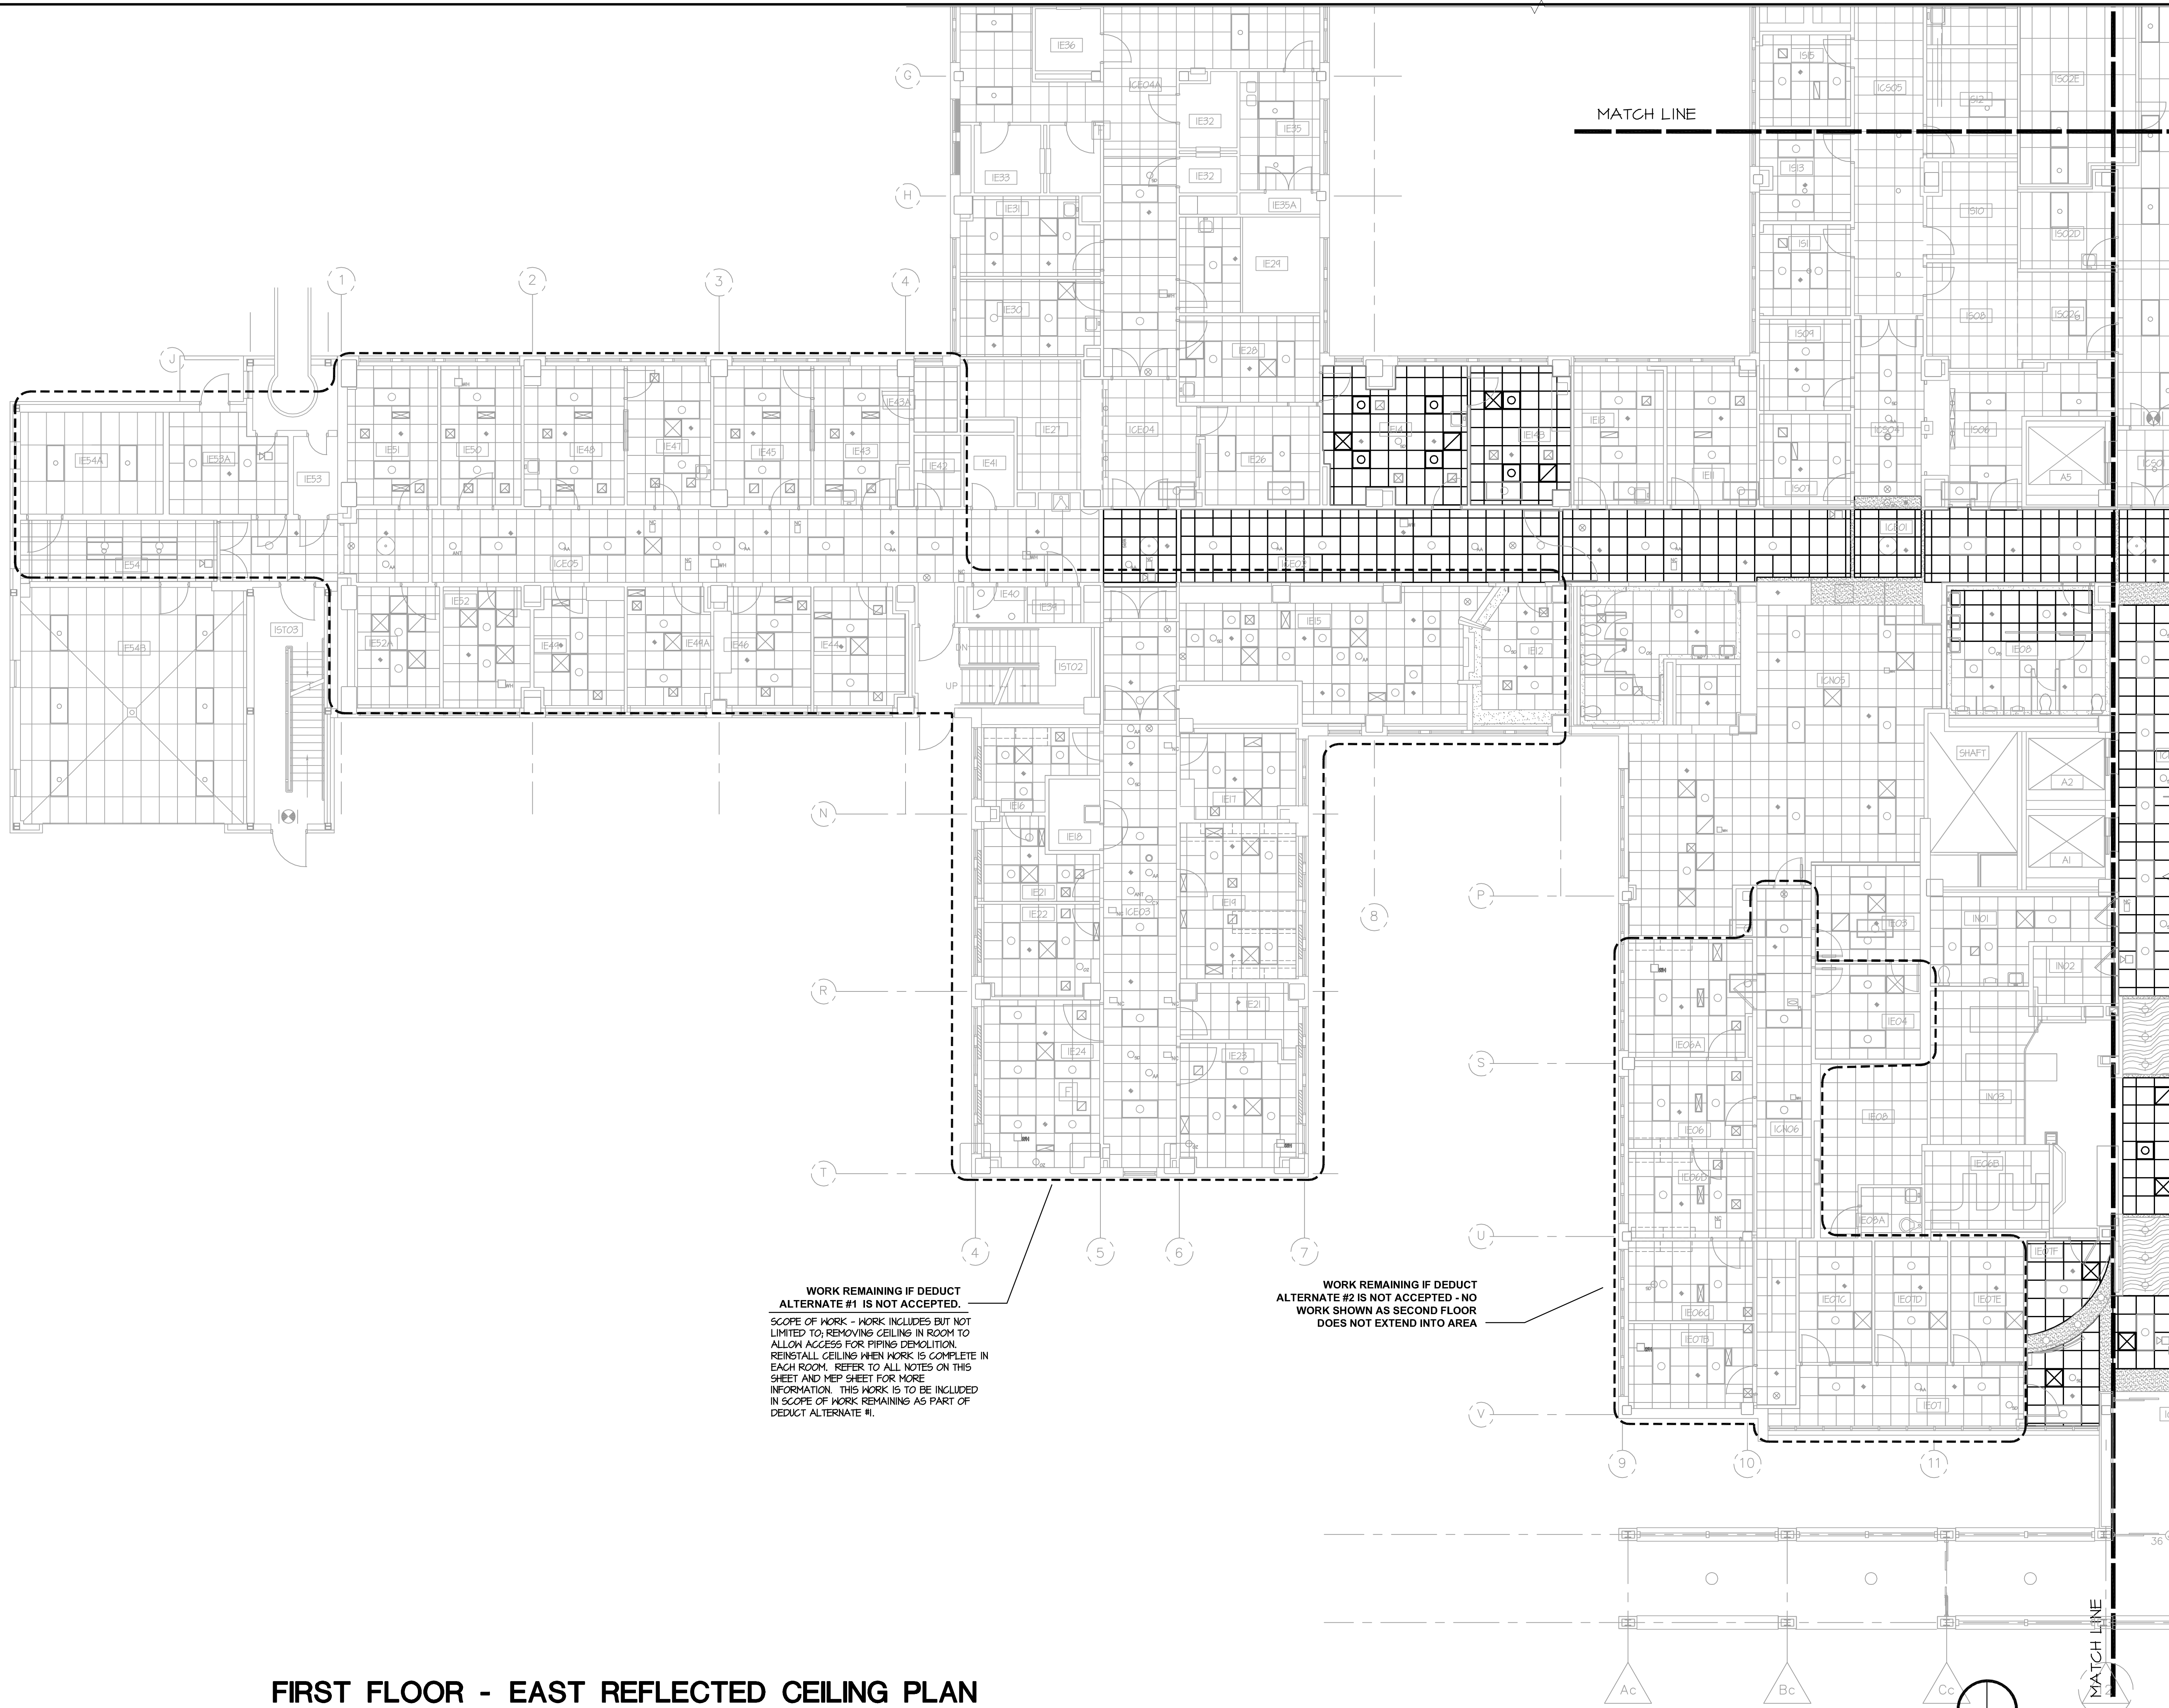

FIRST FLOOR - EAST REFLECTED CEILING PLAN

SCALE: 1/8" = 1'-0"

PLAN NORTH

GENERAL REFLECTED CEILING NOTES

- CONTRACTOR SHALL FIELD VERIFY ALL EXISTING AND NEW CONDITIONS PRIOR TO START OF CEILING FABRICATION AND INSTALLATION.
- THIS DRAWING LOCATES NEW REFLECTED CEILING TILES AND GRID. CEILING TILES AND GRID TO BE REINSTALLED IN SIMILAR LOCATION AS EXISTING. REFER TO MECHANICAL AND ELECTRICAL DRAWINGS AND SPECIFICATIONS FOR SPECIFIC TYPE AND REQUIREMENTS FOR NEW/RELOCATIONS/SALVAGED/REINSTALLATION OF EXISTING LIGHTING, DIFFUSERS, CEILING MOUNTED DEVICES AND ETC.
- NEW CEILING TILES AND GRID TO BE INSTALLED AS NOTED ON DRAWING, EITHER INSTALLED AT EXISTING HEIGHT OR LOWERED TO NEW HEIGHT AS SPECIFIED ON THE DRAWINGS.
- CONNECTION TO CEILING MOUNTED DEVICES ARE TO REMAIN. CONTRACTOR IS NOT TO DISCONNECT ANY CEILING MOUNTED DEVICES. IF A DEVICES IS REQUIRED TO BE DISCONNECTED TO COMPLETE WORK, THE CONTRACTOR IS TO NOTIFY THE OWNER. IF A DEVICE IS TO BE DISCONNECTED THE CONTRACTOR IS TO PROVIDE A QUALIFIED LOW VOLTAGE EXPERIENCED SUB TO DISCONNECT AND RECONNECT DEVICES. REFER TO THE MEP SHEETS FOR MORE INFORMATION AND INFORMATION ON QUALIFICATIONS REQUIRED.
- NEW CEILING TILE IS TO BE IDENTICAL TO THE VA STANDARD CEILING TILE AS LISTED IN SECTION 09 06 00 SCHEDULE FOR FINISHES.
- DARK SOLID LINE INDICATES NEW CONSTRUCTION.

LIGHT, SCREENED LINES INDICATES EXISTING CONSTRUCTION TO REMAIN.

PROJECT AREA - BASE BID FOR REFERENCE ONLY. SCOPE OF WORK MAY EXTEND PAST PROJECT AREA, REFER TO ALL NOTES LISTED ON DOCUMENT.

PROJECT AREA - ADD OPTION FOR REFERENCE ONLY. SCOPE OF WORK MAY EXTEND PAST PROJECT AREA, REFER TO ALL NOTES LISTED ON DOCUMENT.

REFLECTED CEILING LEGEND

- 2' x 2' LAY-IN ACOUSTICAL CEILING SYSTEM
- SOFFIT/BULKHEAD/ HARD CEILING
- 2' x 4' FLUORESCENT LIGHT FIXTURE
- 1' x 4' FLUORESCENT LIGHT FIXTURE
- 2' x 2' LED FIXTURE
- CAN LIGHTS
- SURFACE MOUNTED 2' x 2' LIGHT FIXTURE
- SMOKE DETECTOR
- SPRINKLER HEAD
- CEILING MOUNTED CAMERA
- SPEAKER
- WIRELESS HUB
- ACCESS DOOR
- AIR DIFFUSER - SUPPLY
- AIR DIFFUSER - RETURN
- AIR DIFFUSER - SUPPLY
- AIR DIFFUSER - RETURN
- VISUAL FIRE ALARM LIGHT
- ALARM AUDIO DEVICE
- ANTENNA
- NURSE CALL
- SECURITY MIRROR
- EXIT LIGHT
- OCCUPANCY SENSOR
- CENTREX WIRELESS DEVICE
- ANTI THEFT DEVICE
- EYE WASH STATION
- EMERGENCY LIGHT

FIRST REVIEW SUBMISSION (35% REVIEW)	11/1/13
SECOND REVIEW SUBMISSION (75% REVIEW)	1/6/14
FINAL REVIEW SUBMISSION (100% REVIEW)	3/20/15
CONSTRUCTION DOCUMENTS	2/12/16
Revisions:	Date

CONSULTANTS:

ODT DESIGN TEAM
1210 S. GILBERT ST. SUITE 100
IOWA CITY, IA 52240
319-338-0066
phone 319-351-0066 fax

ARCHITECT/ENGINEERS:

DESIGN ENGINEERS
MECHANICAL AND ELECTRICAL CONSULTANTS
8801 PRAIRIE VIEW LANE SW, CEDAR RAPIDS, IA 52404
designengineers.com 319.841.1944

Drawing Title

FIRST FLOOR - EAST REFLECTED CEILING PLAN

Approved: Project Director

Project Title

REPLACE FAN COILS & CONVECTORS, PHASE 2

Location

BUILDING NO. 1
VAMC IOWA CITY, IA

Date

8-21-15

Checked

Drawn

NYC

Project Number

636A8-14-002
Building Number NO. 1

Drawing Number

1-A2.1EB(R)
Dwg. 30 of 123

Office of
Construction
and Facilities
Management

VA U.S. Department of Veterans Affairs