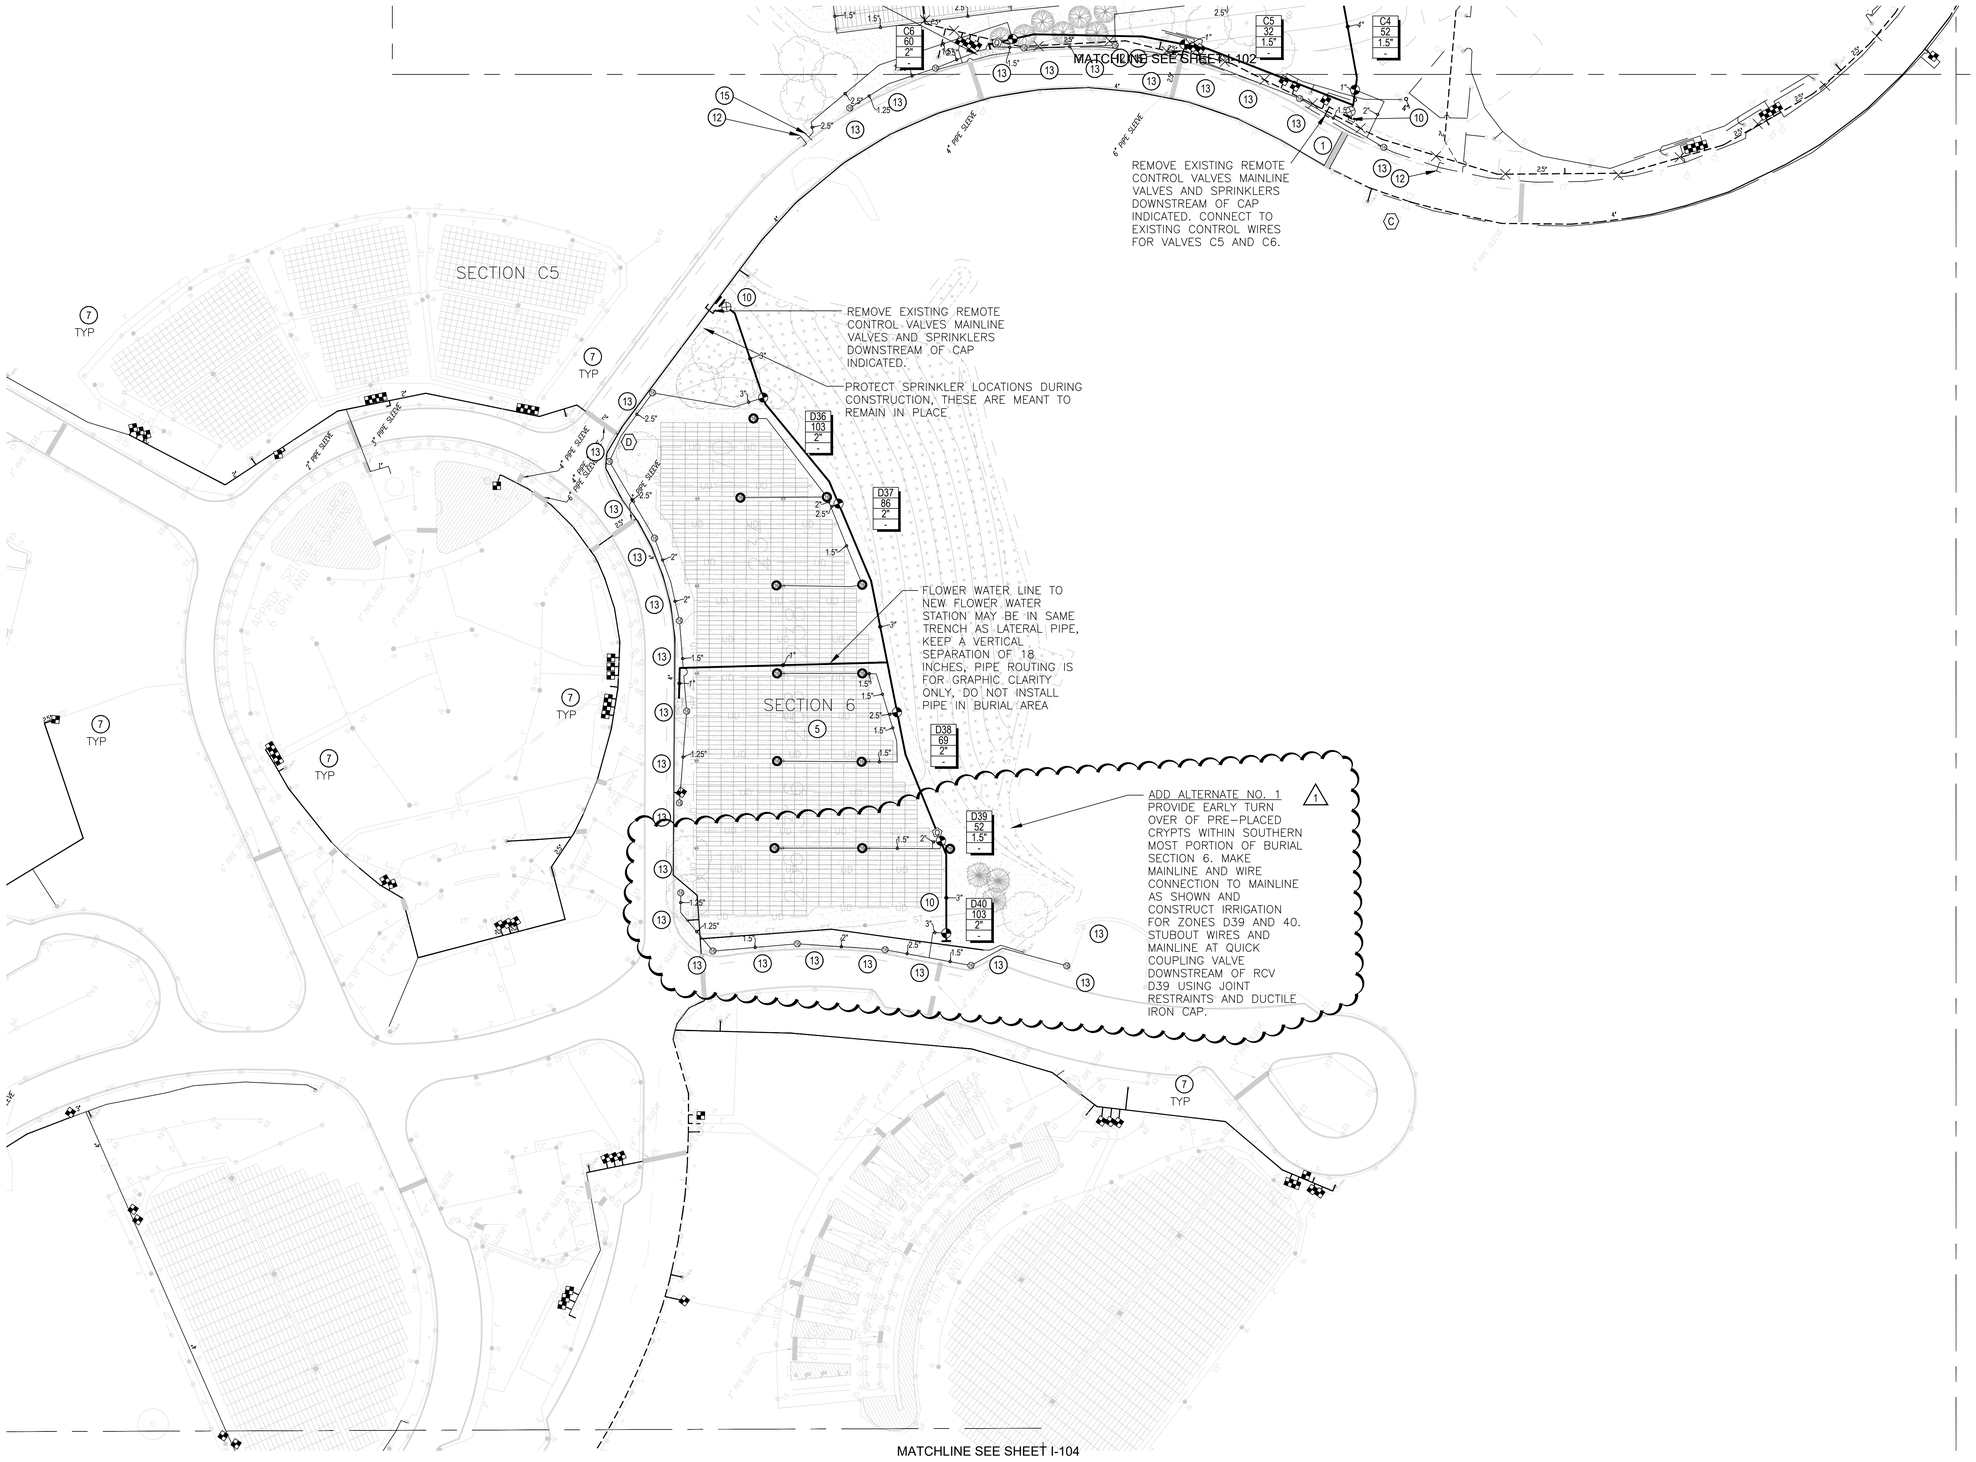

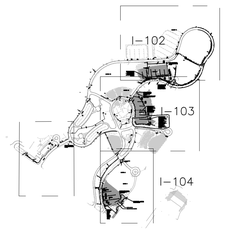

KEY MAP

40' 0' 20' 40' 80'
1" = 40'
SCALE MUST MEASURE 1 INCH OR DRAWING IS NOT TO SCALE.

Revisions:	Date
1 ADDENDUM NO.1: ADD ALT. NO. 1 ADDED	05/09/16

PREPARED BY:

CANNONDESIGN • the LA group
a joint venture
3030 Clarendon Boulevard, Suite 500, Arlington, VA 22201, (703) 907-2300
40 Long Alley, Saratoga Springs, NY 12866, (518) 587-8100
Baltimore ■ Boston ■ Buffalo ■ Calgary ■ Chicago Houston ■ Los Angeles ■ Mumbai ■ New York ■ Phoenix St. Louis ■ San Francisco ■ Shanghai ■ Toronto Vancouver ■ Victoria ■ Washington DC

CONSULTANTS:

Aqua Engineering, Inc.
Innovative Water Solutions
4803 Innovation Drive
Fort Collins, Colorado 80525
Phone (970) 229-9668
FAX (970) 226-3855

THE ROBERT B. BALTER COMPANY.
Geotechnical Engineering, Subsurface Exploration
Construction Inspection and Materials Testing

Civil & Environmental Consultants, Inc.
333 Baldwin Road
Pittsburgh, PA 15205

JOHN D. LEONARD
Certified Irrigation Designer
IRRIGATION ASSOCIATION
46102
3/29/2016

NATIONAL CEMETERY ADMINISTRATION

Drawing Title: IRRIGATION PLAN

Approved: Project Director

Project Title: NATIONAL CEMETERY OF THE ALLEGHENIES EXPAN. SECTIONS 6, 7, C6 & C7

Location: WASHINGTON COUNTY, PENNSYLVANIA

Date: 03/30/2016 | Checked: RWB | Drawn: JDL

Project Number: 925CM3005

Building Number:

Drawing Number: I-103

Dwg 52 of 56

NATIONAL CEMETERY ADMINISTRATION DESIGN AND CONSTRUCTION SERVICE

Department of Veterans Affairs

VA FORM 08-6231

BID DOCUMENTS