GENERAL NOTES:

A. SUB-BASEMENT IS A CRAWL SPACE APPROXIMATELY FOUR (4) FEET HIGH WITH LIMITED CLEARANCE AND LIGHTING. ACCESS TO SUB-BASEMENT CAN BE ACHIEVED THROUGH STAIR NUMBER EIGHT (8) AND/OR STAIR NUMBER FIVE (5). ALL PIPING SHOWN IS LOCATED BELOW THE BASEMENT IN THE SUB BASEMENT.

B. CONTRACTOR SHALL BECOME FAMILIAR WITH THE EXISTING CONDITIONS OF THE SUB BASEMENT PRIOR TO BIDDING THIS WORK. THE LARGE QUANTITY OF EXISTING PIPE AND CONDUIT WILL REQUIRE MULTIPLE OFFSETS AND CHANGES IN ELEVATION. THE CONTRACTOR SHALL INCORPORATE THESE INTO HIS BID AND COORDINATE THE EXACT ROUTING.

CODED NOTES:

1. 2" SUPPLY AND RETURN VALVES CAPPED FOR FUTURE CONNECTION.
2. 6" SUPPLY AND RETURN VALVES CAPPED FOR FUTURE CONNECTION.
3. 4" SUPPLY AND RETURN VALVES CAPPED FOR FUTURE CONNECTION.
4. REMOVE INSULATION FROM FOUR EXISTING 12" PIPES, APPROXIMATELY 60' LONG EACH, WITHIN HATCHED AREA AND REPLACE WITH 2" THICK FIBERGLASS INSULATION WITH VAPOR BARRIER.
5. PROVIDE SLEEVE AT MASONRY PENETRATION. SEAL AROUND MASONRY PENETRATION.
6. REMOVE INSULATION FROM EXISTING 8" HP STEAM PIPE, APPROXIMATELY 30' LONG, SEE HATCHED AREA FOR APPROXIMATE LOCATION, REPLACE WITH FIBERGLASS INSULATION PER SPECIFICATIONS.

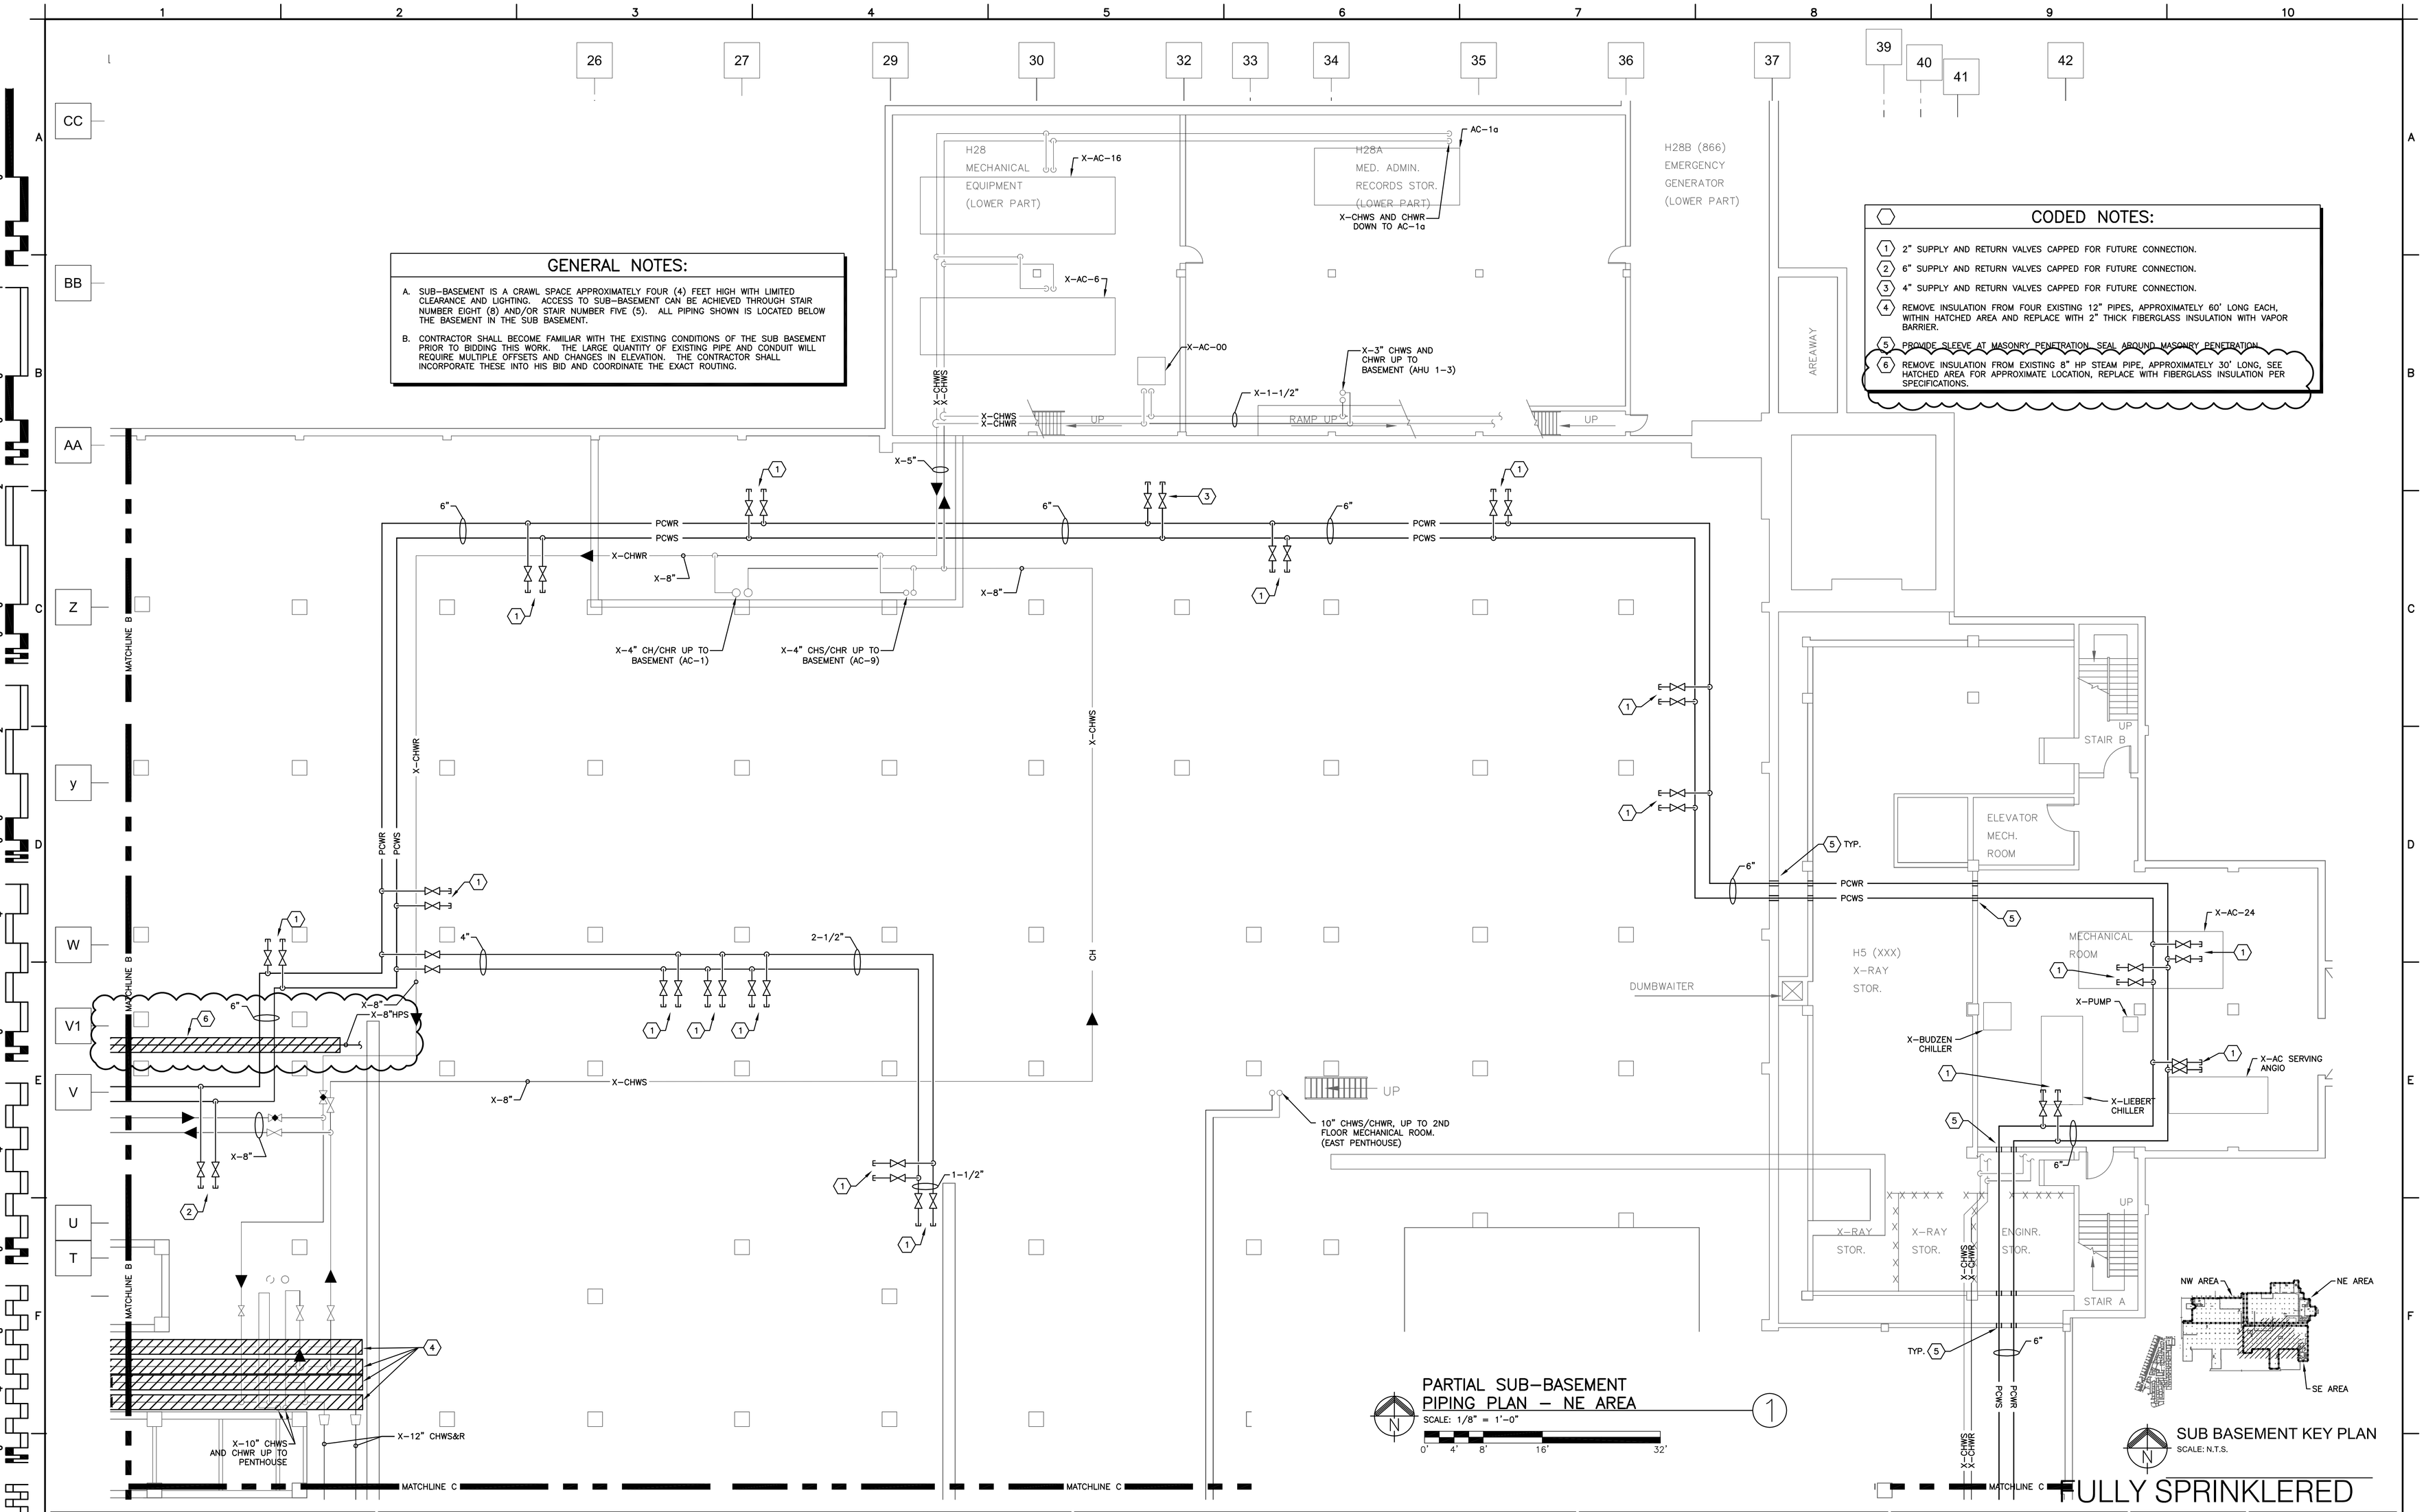

PARTIAL SUB-BASEMENT PIPING PLAN – NE AREA (1)
SCALE: 1/8" = 1'-0"

SUB BASEMENT KEY PLAN
SCALE: N.T.S.

FULLY SPRINKLERED

Revisions:	Date
Re-bid Issue	05-24-11
AMENDMENT 03	11-22-11

CONSULTANTS:

FREDRICK, FREDRICK & HELLER ENGINEERS, INC.
672 EAST ROYALTON ROAD
BROADVIEW HTS., OHIO 44147
TEL: (440) 546-9696
FAX: (440) 546-9699

STATE OF OHIO — BRIAN M. WIDOWSKI E-66625 — REGISTERED PROFESSIONAL ENGINEER
09017

ARCHITECT:

Perspectus architecture
13212 Shaker Square Suite 204 Cleveland, Ohio 44120
P. 216.752.1800 F.216.752.3833

DESIGN AND CONSTRUCTION DOCUMENTS AS INSTRUMENTS OF SERVICE ARE GIVEN IN CONFIDENCE AND REMAIN THE PROPERTY OF PERSPECTUS ARCHITECTURE. THE USE OF THIS DESIGN AND THESE CONSTRUCTION DOCUMENTS FOR PURPOSES OTHER THAN THE SPECIFIC PROJECT NAMED HEREIN IS STRICTLY PROHIBITED WITHOUT THE EXPRESSED WRITTEN CONSENT OF PERSPECTUS ARCHITECTURE.

Drawing Title: **PARTIAL SUB-BASEMENT PIPING PLAN - NE AREA**

Project Title: **ENERGY CONSERVATION UPGRADES**

Project Number: VA250-P-0396

Building Number: 1

Approved: Project Director

Location: **VAMC - WADE PARK**

Date: 05-24-11 | Checked: **BMW** | Drawn: **LDH**

Drawing Number: **5-H6** Dwg. of

Office of Facilities Management
Department of Veterans Affairs

VA FORM 08-6231, OCT 1978