


SF VA Medical Center
 Building : 002
 Ground Floor

Asbestos Material Location

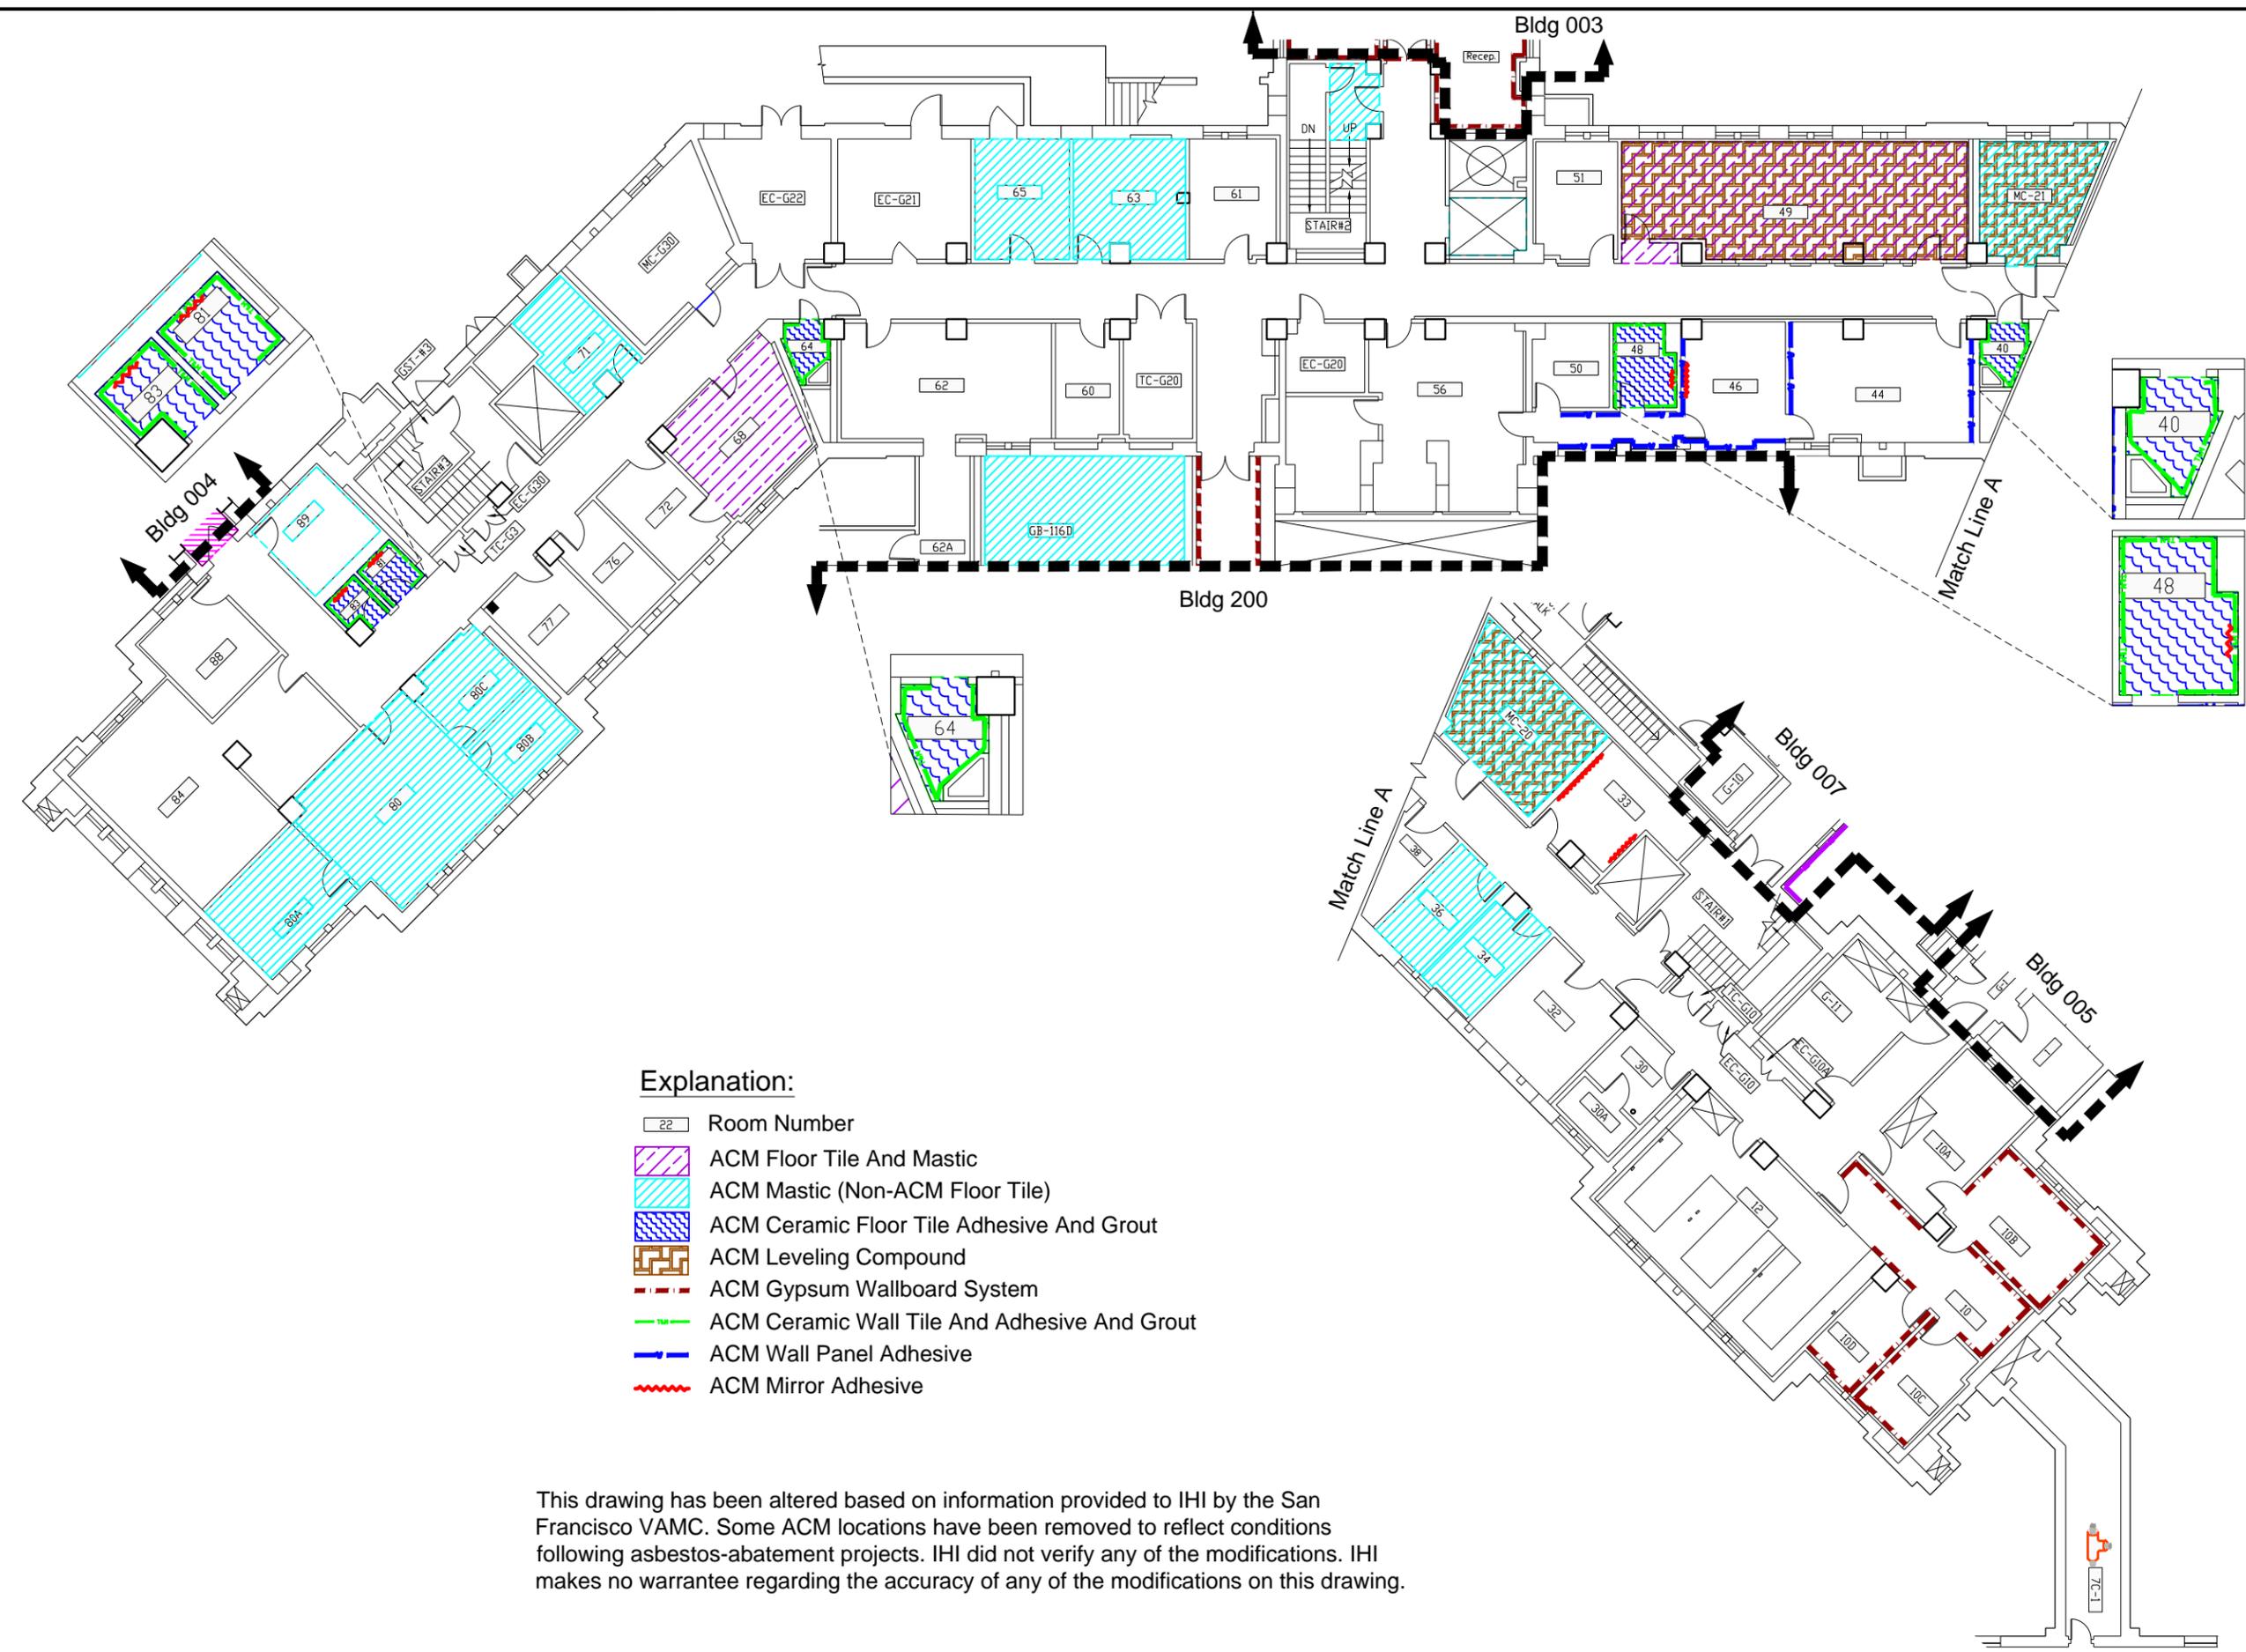

- Explanation:**
- 22 Room Number
 - ACM Floor Tile And Mastic
 - ACM Mastic (Non-ACM Floor Tile)
 - ACM Ceramic Floor Tile Adhesive And Grout
 - ACM Leveling Compound
 - ACM Gypsum Wallboard System
 - ACM Ceramic Wall Tile And Adhesive And Grout
 - ACM Wall Panel Adhesive
 - ACM Mirror Adhesive

This drawing has been altered based on information provided to IHI by the San Francisco VAMC. Some ACM locations have been removed to reflect conditions following asbestos-abatement projects. IHI did not verify any of the modifications. IHI makes no warrantee regarding the accuracy of any of the modifications on this drawing.