


three inches = one foot
 one and one half inches = one foot
 one inch = one foot
 three quarters inch = one foot
 one half inch = one foot
 three eighths inch = one foot
 one quarter inch = one foot
 one eighth inch = one foot




2 00 SUBGRADE FLOOR KEY - NEW
 1" = 40'-0"

GENERAL NOTES:
 ALL EXISTING AND NEW PENETRATIONS CREATED DURING DEMOLITION AND CONSTRUCTION MUST BE FIRE STOPPED BY THE END OF THE WORK DAY.
 PROVIDE SMOKE SEALANTS AROUND ALL PENETRATION IN MECHANICAL ROOM
 CONTRACTOR TO PROVIDE VAMC APPROVED RENOVATED AREA SIGNAGE TO MATCH FIRST FLOOR.
 REPAIR DEMOLISHED SLABS TO LIKE NEW CONDITIONS
 PROVIDE BLOCKING BEHIND ALL AREAS REQUIRING MARKER BOARDS, FILM BOXES, ETC. SEE BLOCKING SPECIFICATIONS AND DETAIL PER SHEET AS401
 CONTRACTOR TO PURCHASE AND INSTALL NEW BODY LIFT
 CONTRACTOR SHALL BE RESPONSIBLE FOR ALL PATCHWORK SEE OR UNFORSEEN IN THE SCOPE OF WORK TO INSURE PROPER COMPLETION OF THE JOB

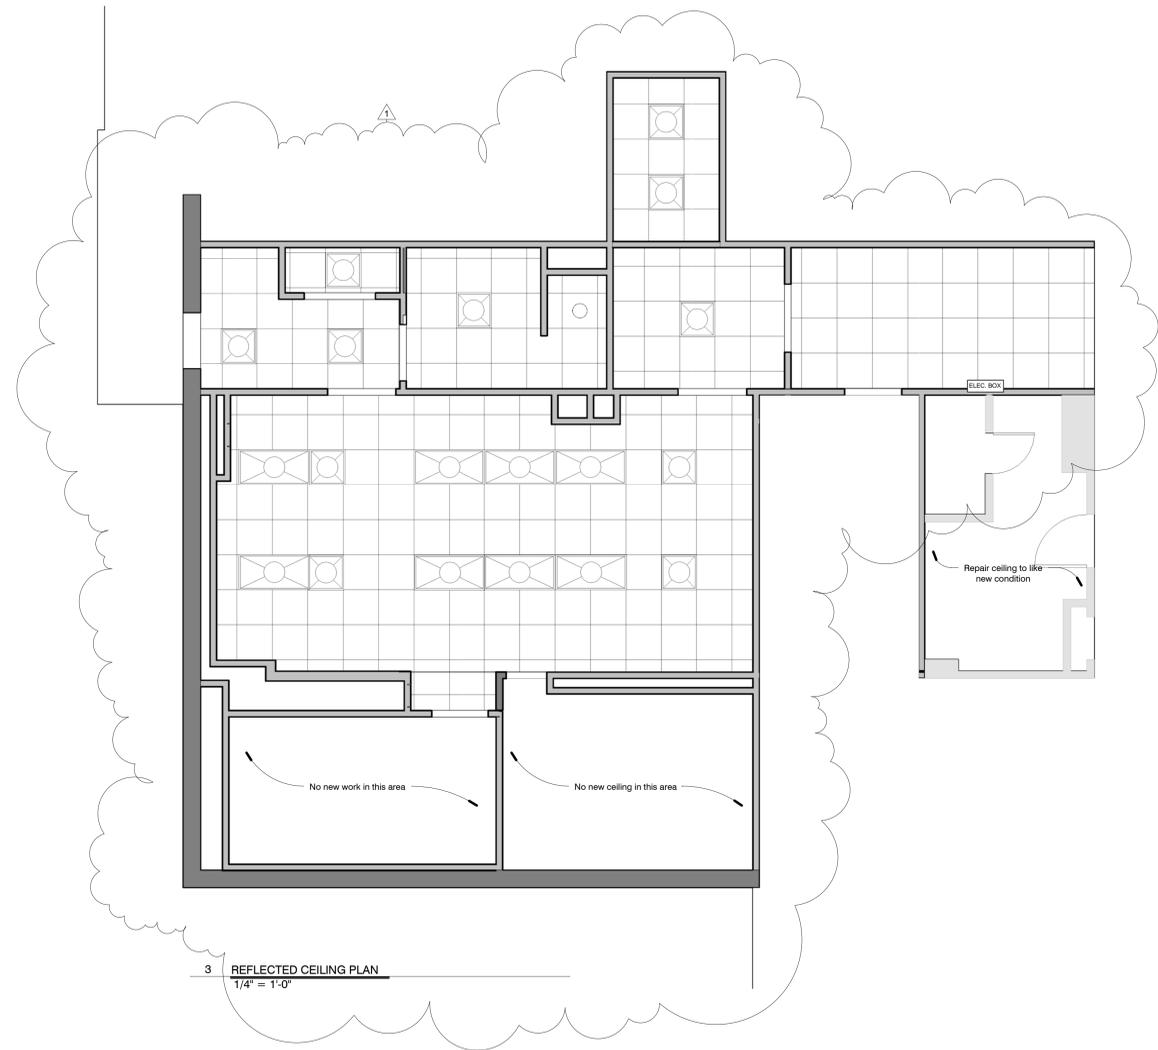

3 REFLECTED CEILING PLAN
 1/4" = 1'-0"

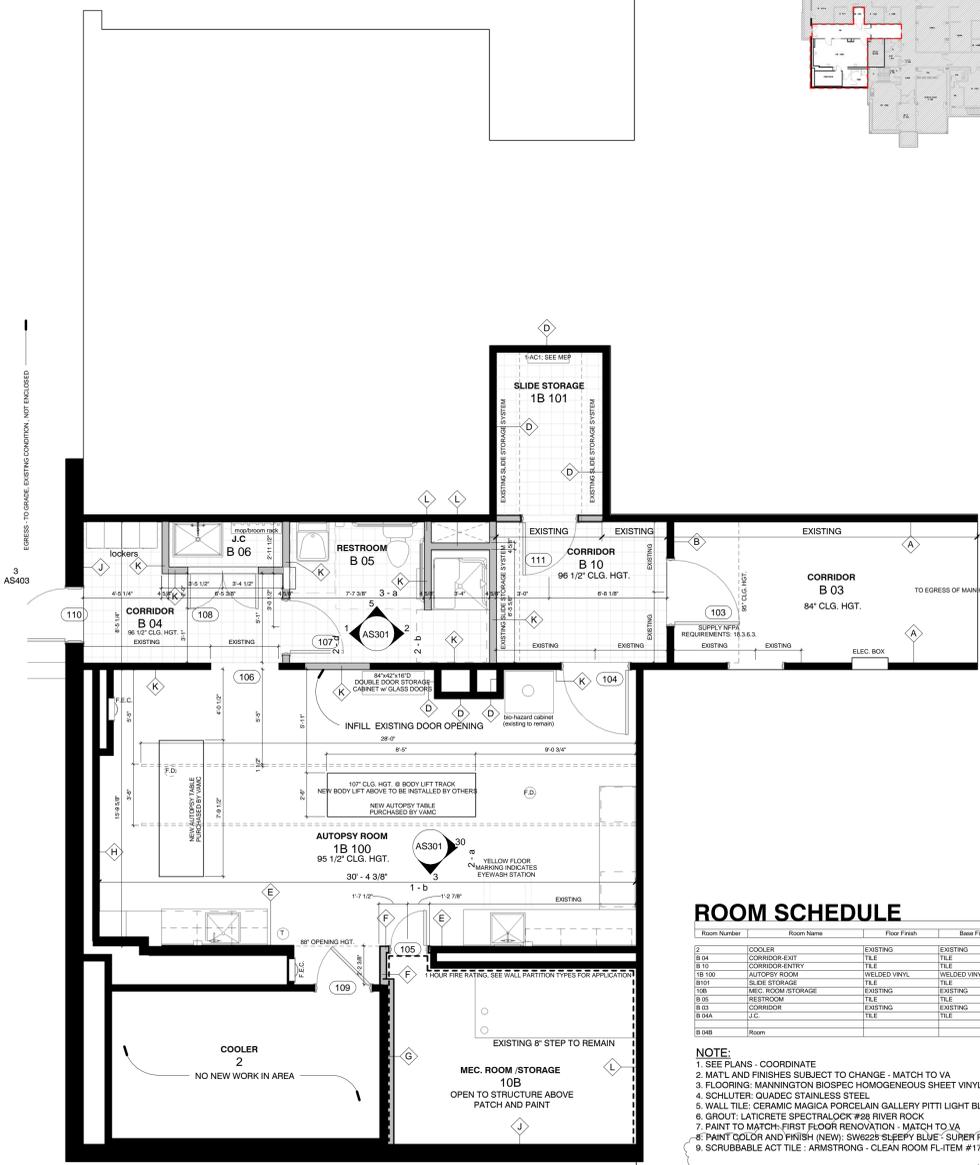

1 BASEMENT PLAN - MORGUE - NEW
 1/4" = 1'-0"

ROOM SCHEDULE

Room Number	Room Name	Floor Finish	Base Finish	Wall Finish	Ceiling Finish	Comments
02	COOLER	EXISTING	EXISTING	EXISTING	EXISTING	NO NEW WORK IN THIS AREA
B 04	CORRIDOR-EXT	TILE	TILE	TILE	SCRUBBABLE ACT TILE	TILE ALL SURFACES EXCEPT CLG. PROVIDE APPROVED SEALANTS
B 10	CORRIDOR-ENTRY	TILE	TILE	TILE	SCRUBBABLE ACT TILE	TILE ALL SURFACES EXCEPT CLG. PROVIDE APPROVED SEALANTS
1B 100	AUTOPSY ROOM	WELDED VINYL	WELDED VINYL	TILE	SCRUBBABLE ACT TILE	SEE THRESHOLD DETAILS AT ENTRY DOORS/OPENINGS. CLASS II WELDED VINYL
B 06	RESTROOM	TILE	TILE	TILE	SCRUBBABLE ACT TILE	
10B	MECH. ROOM STORAGE	EXISTING	EXISTING	PAINT	SCRUBBABLE ACT TILE	PATCH EXISTING
B 05	RESTROOM	TILE	TILE	TILE	SCRUBBABLE ACT TILE	TILE ALL SURFACES EXCEPT CLG. PROVIDE APPROVED SEALANTS
B 03	CORRIDOR	EXISTING	EXISTING	PAINT	SCRUBBABLE ACT TILE	PATCH EXISTING
B 04A	CLC	EXISTING	TILE	TILE	SCRUBBABLE ACT TILE	PROVIDE GASKET GUARDS AT INOP SINK

- NOTE:**
 1. SEE PLANS - COORDINATE
 2. MATL AND FINISHES SUBJECT TO CHANGE - MATCH TO VA
 3. FLOORING - MANNINGTON BIOSPEC HOMOGENEOUS SHEET VINYL STEEL BLUE 15149
 4. SCHLUTER QUADRO STAINLESS STEEL
 5. WALL TILE: CERAMIC MAGICA PORCELAIN GALLERY PITTI LIGHT BLUE
 6. GROUT: LATCRETE SPECTRALOCK #88 RIVER ROCK
 7. PAINT TO MATCH FIRST FLOOR RENOVATION - MATCH TO VA
 8. PAINT COLOR AND FINISH (NEW): SW628 SLEEPY BLUE - SUPER PAINT; WALLS: SATIN LATEX TRIM: SATIN ENAMEL
 9. SCRUBBABLE ACT TILE: ARMSTRONG - CLEAN ROOM FL-ITEM #1715 (WHITE)

NOTE: DO NOT SCALE DRAWING

EACH CONTRACTOR IS TO VERIFY ALL EXISTING CONDITIONS AND ALL DIMENSIONS BEFORE BEGINNING ANY WORK. EACH CONTRACTOR IS TO FULLY COORDINATE HIS WORK WITH THAT OF OTHERS. REFER TO THE CONTRACT AND SPECIFICATIONS FOR ADDITIONAL REQUIREMENTS.

FINAL SUBMISSION - FOR CONSTRUCTION
 FULLY SPRINKLERED

Revisions:	1	Date:	11.22.11
------------	---	-------	----------

CONSULTANTS:

ARCHITECT/ENGINEERS:

East Hills Engineering Associates
 MECHANICAL/ELECTRICAL SYSTEMS DESIGN
 244 MAIN STREET
 WINDBER, PENNSYLVANIA 15963
 PHONE: (814) 467-6877 FAX: (814) 467-6529

LAI incorporated architecture studio
 rt 3 box 383e
 Fairmont, WV 26554
 office: 304.288.3941

Drawing Title
AUTOPSY TABLE INSTALLATION BASEMENT PLAN

Approved: Project Director

Project Title
AUTOPSY TABLE INSTALLATION

Location
 CLARKSBURG, WV

Date
 10-21-2011

Checked
 Drawn

Project Number
 540-09-102

Building Number
 Build. 1

Drawing Number
AS101

Dwg. 6 of 35

Office of Construction and Facilities Management
 Department of Veterans Affairs