

FLOOR PLAN LEGEND


- NEW DOOR
- NEW WALL
- EXISTING DOOR
- EXISTING WALL
- KEYED NOTE
- NEW FINISHES APPLIED AT THIS LOCATION TO EXISTING WALL. SEE KEYED NOTE
- NEW HANDRAIL AND CRASHRAIL. RE: DETAIL 41-2B-500
- NEW CRASHRAIL. RE: DETAIL 51-2B-500

GENERAL NOTES - 3RD, 4TH, & 6TH FLOOR ROOF

- A. DEMOLITION & CONSTRUCTION MUST BE SEQUENCED & COORDINATED TO ENSURE THAT THE BUILDING OWNERS OPERATIONS ARE CONTINUOUSLY MAINTAINED.
- B. THIS DEMOLITION PLAN REFLECTS INFORMATION GATHERED FROM EXISTING CONDITIONS DRAWINGS & ARCHITECT'S FIELD OBSERVATIONS. CONTRACTOR TO VERIFY ACCURACY OF INFORMATION & INCLUDE ALL REQUIRED DEMOLITION IN THEIR BID & REPORT ANY DISCREPANCIES TO THE ARCHITECT.
- C. ITEMS TO BE DEMOLISHED, REMOVED, OR RELOCATED ARE SHOWN DASHED. EXISTING ITEMS TO REMAIN SHALL BE PROTECTED DURING CONSTRUCTION BY CONTRACTOR. PATCH & REPAIR RESULTING SURFACES.
- D. REFER TO OTHER DRAWINGS IN THIS SET FOR LOCATIONS OF ITEMS TO BE RELOCATED.
- E. REMOVE ALL FLOORING FINISHES & BASE WHERE NOTED. PREPARE SLAB & EXISTING WALLS TO REMAIN TO RECEIVE NEW FINISHES WHERE NOTED.
- F. REMOVE ALL CEILING TILES, GRIDS, LIGHTS, & ASSOCIATED HARDWARE WHERE INDICATED. REFER TO CONSULTANT DRAWINGS FOR ADDITIONAL INFORMATION.
- G. REMOVE ALL WALL MOUNTED WIRE MOULD & RECEPTACLES WHERE NOTED. PULL WIRE BACK TO ELECTRICAL PANEL. RE: E-SERIES DRAWINGS FOR ADDITIONAL INFORMATION.
- H. REMOVE ALL EXISTING PHONE/DATA LINES BACK TO NEAREST PATCH PANEL. RE: E-SERIES DRAWINGS FOR ADDITIONAL INFORMATION.
- I. ALL WORK SHOWN "N.I.C." (NOT IN CONTRACT) MAY BE ACCOMPLISHED BY A CONTRACTOR WHO IS NOT INCLUDED AS PART OF THE CONSTRUCTION AGREEMENT. THE GENERAL CONTRACTOR IS TO COORDINATE WITH OTHER CONTRACTORS PERFORMING N.I.C. WORK WHICH IMPACTS OR RELATES TO WORK WHICH IS PART OF THE "CONSTRUCTION AGREEMENT".
- J. ALL PARTITIONS ARE TYPE '1' UNLESS OTHERWISE NOTED.
- K. ALL DIMENSIONS ARE FROM FACE OF PARTITION TO FACE OF PARTITION U.O.N. UNDER NO CIRCUMSTANCES SHALL ANY MEASUREMENT BE SCALED FROM THE DRAWINGS. ANY MEASUREMENT NOT GIVEN AN ACTUAL NUMBER DIMENSION SHOULD BE BROUGHT TO THE ARCHITECT'S ATTENTION BEFORE PROCEEDING.
- L. REFER TO HAZARDOUS MATERIAL ABATEMENT DRAWINGS FOR REMOVAL HAZARDOUS MATERIALS.
- M. CRANES CANNOT BE PLACED AND/OR OPERATED ON MEDICAL CENTER PROPERTY BETWEEN 7:00AM - 5:00PM M-F.
- N. REFER TO ELECTRICAL FOR ALL EXIT SIGNAGE LOCATIONS.

KEYED NOTES - SIXTH FLOOR PLAN

- NOTE: EXISTING ROOF IS UNDER MAINTENANCE CONTRACT WITH TREMCO. CONTACT LARRY FORD WITH TREMCO (314-908-0517)
- 1 NEW ROOF MOUNTED HVAC EQUIPMENT (RE: MECH)
 - 2 NEW HVAC PIPING ON SUPPORT (RE: MECH)
 - 3 EXISTING ROOF EQUIPMENT TO REMAIN. RE: MECH
 - 4 EXISTING PENTHOUSE ROOF.
 - 5 EXISTING ROOF DRAIN LOCATION RE: PLUMBING
 - 6 REMOVE EXISTING ROOFING AND STRUCTURAL SYSTEM AT THIS LOCATION FOR NEW MECH PENETRATION. RE: MECH AND STRUCT FOR SIZE, LOCATION, AND INFORMATION.
 - 7 NEW ROOF MEMBRANE WITH BUILT-UP INSULATION. FINISH TO MATCH EXISTING. MAINTAIN ROOF SLOPE TO NEW ROOF DRAIN.
 - 8 NEW ROOF CRICKET WHERE NEW ROOFING. SLOPE TO NEW ROOF DRAIN AND MAINTAIN EXISTING ROOF SLOPE.
 - 9 NEW ROOF PENETRATION WITH NEW CURB. SEE DETAIL FOR MORE INFORMATION. RE: MECH AND STRUCT FOR SIZE, LOCATION, AND INFORMATION.
 - 10 NEW PIPING SUPPORT RAIL. REFER TO DETAILS ON STRUCTURAL DRAWINGS.
 - 11 NEW PREFABRICATED ALUMINUM CROSSOVER PLATFORM. REFER TO DETAILS ON STRUCTURAL DRAWINGS.
 - 12 NEW GUARDRAIL. REFER TO DETAILS ON STRUCTURAL DRAWING DETAIL ON SHEET 1-2B-S-501.

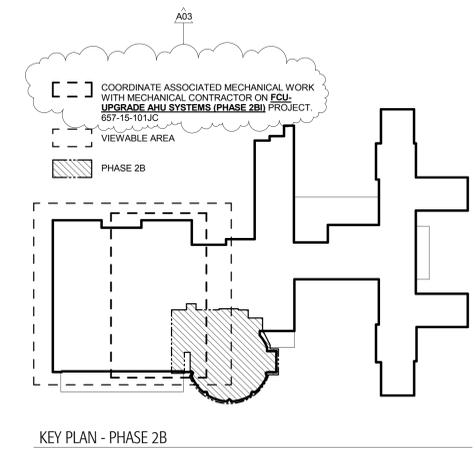

1 PARTIAL 6TH FLOOR / ROOF PLAN - PHASE 2B
1/8" = 1'-0"

Revisions:	Date
A03, Revision A00003	06/01/16

CONSULTANTS:

ARCHITECT/ENGINEERS:

FoxArchitects
One Memorial Drive
Suite 1800
Saint Louis, MO 63102
Tel 314.621.4343
Fax 314.621.0261

SSC *Swim, Schuchat, & Cornett Engineering, Inc.*
MEP & Structural Engineer
18207 Edison Avenue
Chesterfield, MO 63005
Tel 636.530.7770
Fax 636.530.7877

Drawing Title PARTIAL 6TH FLOOR / ROOF PLAN - PHASE 2B	
Approved: Associate Director	Approved: Chief Engineer
Approved: Chief of Staff	Approved: Safety Officer
Approved: Infection Control	Approved: Chief, Police & Security

Project Title PHASE 2B: Renovation of Operating Rooms, ER & Triage		
Project Number 657-13-300JC		
Building Number 01		
Drawing Number 1-2B-A-106		
Date 06/01/16	Checked AB	Drawn MP

BID DOCUMENTS

Veterans Health Administration

Department of Veterans Affairs