


three inches = one foot
one inch = one foot
three quarters inch = one foot
one half inch = one foot
three eighths inch = one foot
one quarter inch = one foot
one eighth inch = one foot
one sixteenth inch = one foot

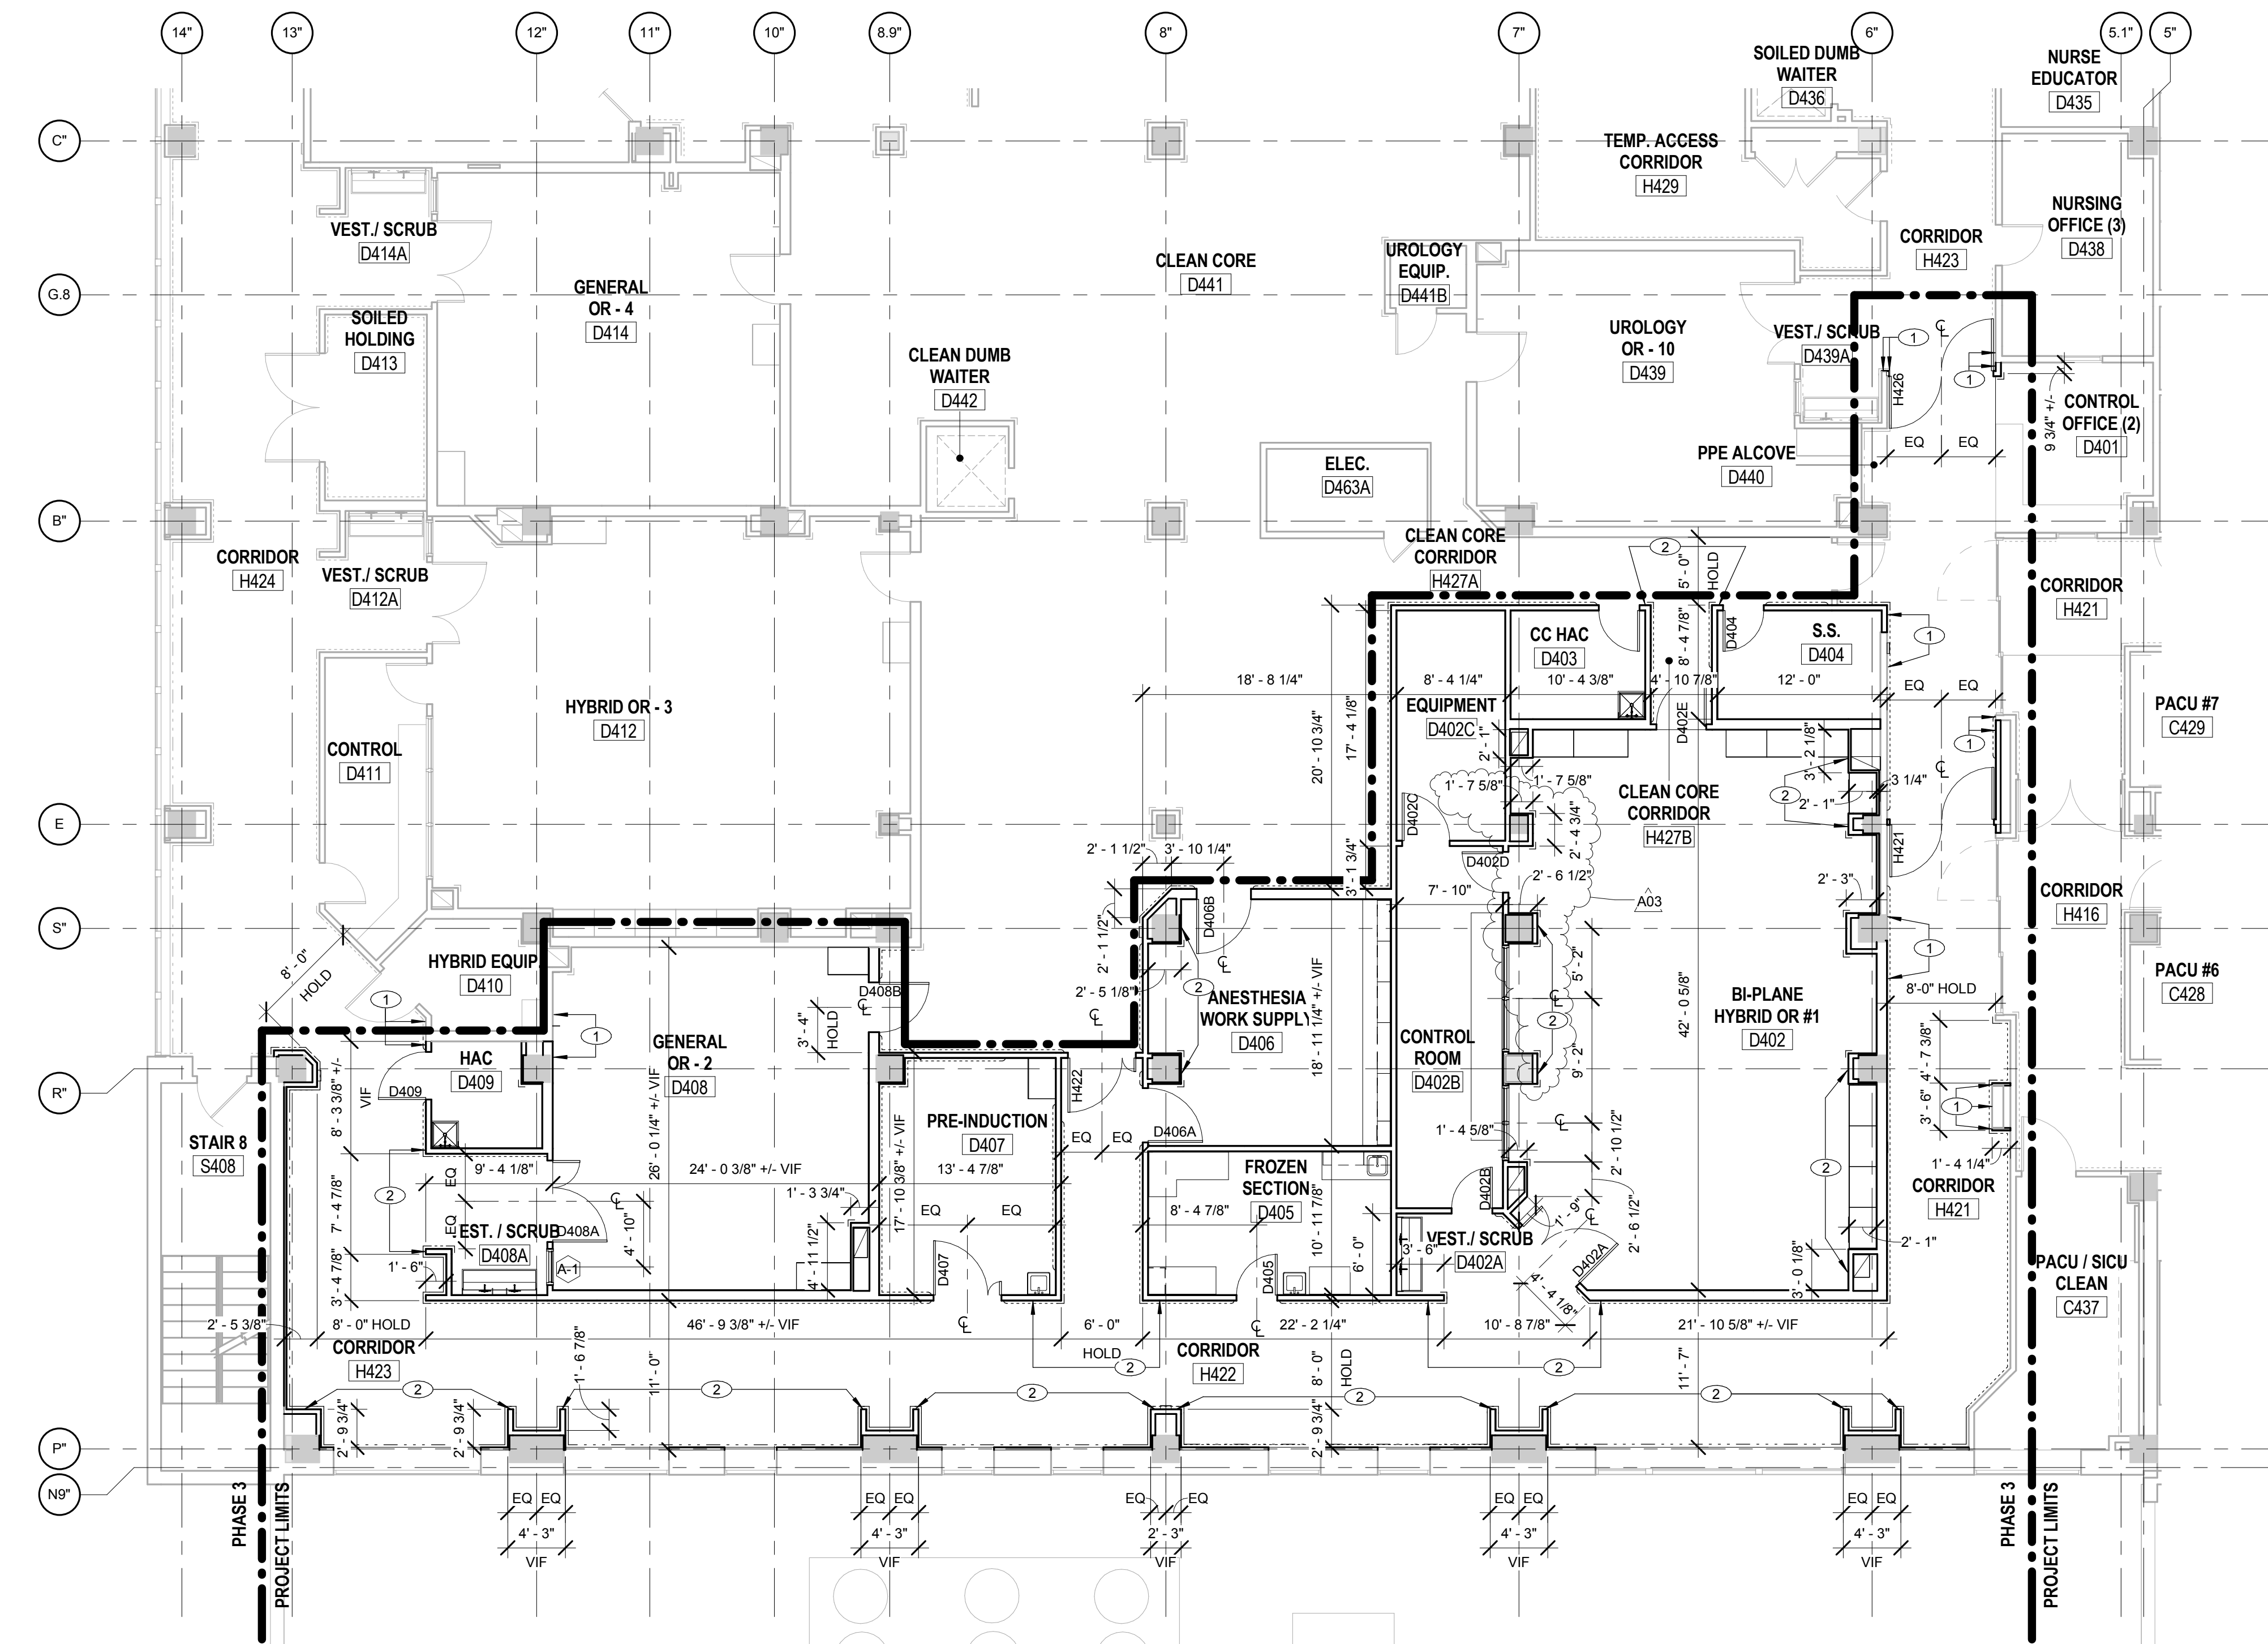


1 PARTIAL 4TH FLOOR DIMENSION PLAN - PHASE 3
1/8" = 1'-0"

FLOOR PLAN LEGEND

NEW DOOR - RE: DOOR SCHEDULE
EXISTING DOOR TO REMAIN - PROTECT DURING CONSTRUCTION
NEW PARTITION - RE: PARTITION TYPES
EXISTING PARTITION TO REMAIN
KEYED RENOVATION NOTE

- GENERAL NOTES - ARCHITECTURAL PLAN**
- A. ALL WORK SHOWN "N.C." NOT IN CONTRACT MAY BE ACCOMPLISHED BY A CONTRACTOR WHO IS NOT INCLUDED AS PART OF THE CONSTRUCTION AGREEMENT. THE GENERAL CONTRACTOR IS TO COORDINATE WITH "OTHER" CONTRACTORS PERFORMING N.C. WORK WHICH IMPACTS OR RELATES TO WORK WHICH IS PART OF THE "CONSTRUCTION AGREEMENT".
- B. ALL PARTITIONS ARE TYPE "T" UNLESS OTHERWISE NOTED.
- C. ALL DIMENSIONS ARE FROM COLUMN CENTER LINE TO FACE OF PARTITION U.O.N. UNDER NO CIRCUMSTANCES SHALL ANY MEASUREMENT BE SCALED FROM THE DRAWINGS. ANY MEASUREMENT NOT GIVEN AN ACTUAL NUMBER DIMENSION SHOULD BE BROUGHT TO THE ARCHITECT'S ATTENTION BEFORE PROCEEDING.
- D. PROJECT LIMIT LINES INDICATES THE AREA OF A MAJORITY OF THE PROJECT WORK. BUT SOME WORK WILL BE REQUIRED OUTSIDE OF THE PROJECT LIMITS. REFER TO DRAWINGS AND SPECIFICATIONS FOR INFORMATION.
- E. ALL DEMOLITION & CONSTRUCTION AREAS MUST HAVE ANTE ROOMS AS REQUIRED AND DESCRIBED IN THE SPECIFICATIONS. VERIFY EXACT LOCATIONS OF ANTE ROOMS WITH C.O.R.
- F. REFER TO HOLLOW METAL DOOR JAMB DETAIL FOR INFORMATION ON LOCATION OF THE DOORS U.N.O.
- G. CONTRACTOR TO INSTALL (3) ROWS OF CONT. 12" WIDE 20 GA. BACKING PLATE AROUND ENTIRE PERIMETER OF OPERATION ROOMS, EQUIPMENT STORAGE ROOMS, EQUIPMENT ALCOVES, R.M.E. NEURO ORTHO ROOM, AND PRE-INDUCTION ROOMS. (TOP OF THE FIRST BACKING PLATE TO BE AT 4'-0" AFF; TOP OF THE SECOND BACKING PLATE TO BE AT 6'-0" AFF; TOP OF THE THIRD BACKING PLATE TO BE AT 8'-0" AFF)

- KEYED NOTES - 4TH FLOOR PLAN - PHASE 3**
- 1 ALIGN PROPOSED PARTITION WITH EXISTING PARTITION AS INDICATED ON THE PLAN.
- 2 ALIGN NEW PARTITIONS WITH EACH OTHER AS INDICATED ON THE PLAN.

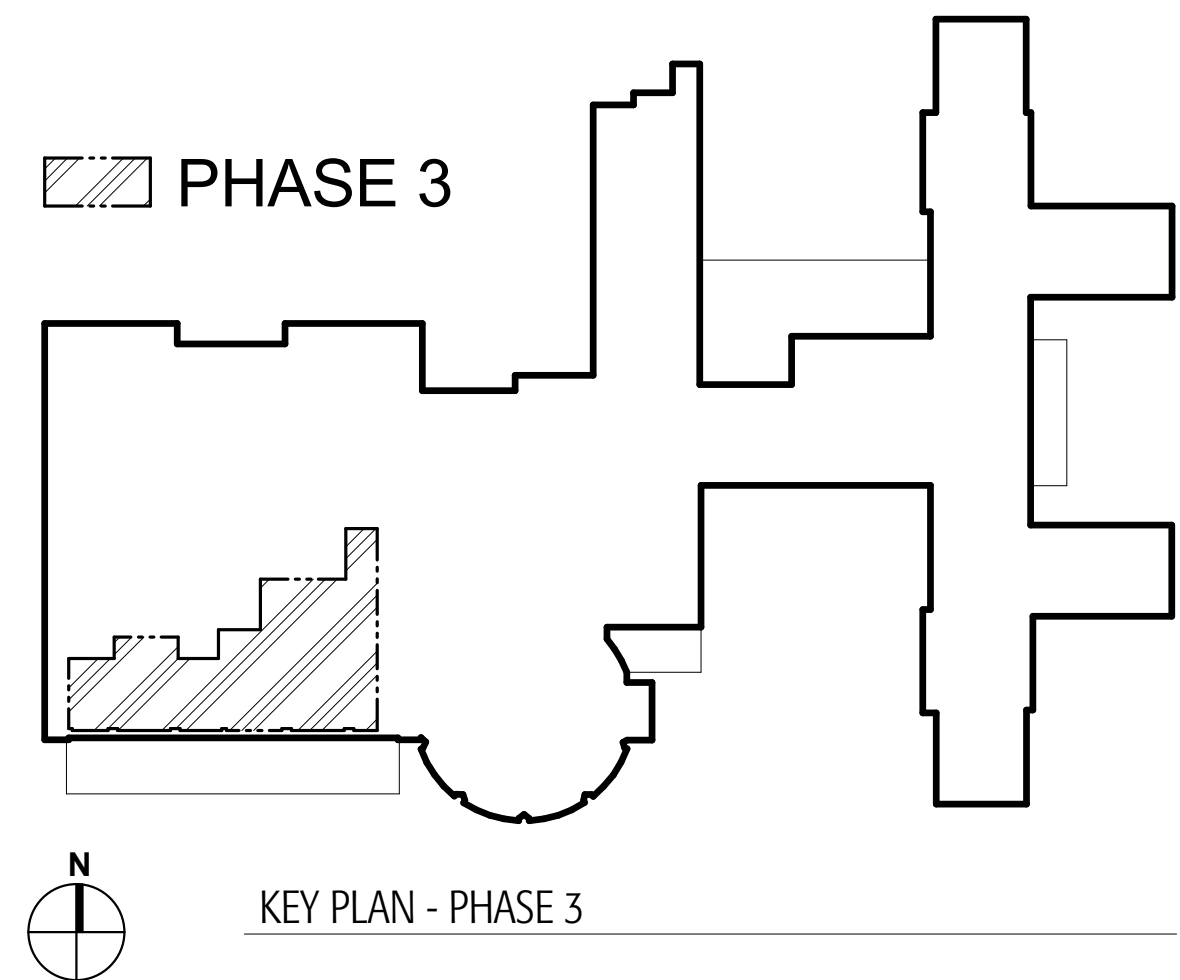

BID DOCUMENTS

Revisions:		Date	CONSULTANTS:		ARCHITECT/ENGINEERS:		Drawing Title		Project Title		Project Number		Veterans Health Administration			
A03, Revision A00003		06/01/16			<div>FoxArchitects</div> <div>One Memorial Drive Suite 1800 Saint Louis, MO 63102</div> <div>Tel 314.621.4343 Fax 314.621.0261</div>		<div>PARTIAL 4TH FLOOR DIMENSION PLAN - PHASE 3</div> <div>Approved: Associate Director</div> <div>Approved: Chief of Staff</div> <div>Approved: Infection Control</div>		657-13-300JC		<div>PHASE 3: Renovation of Operating Rooms, ER & Triage</div> <div>Location V.A.M.C. ST. LOUIS, MO JOHN COCHRAN DIVISION</div> <div>Date 06/01/16</div>				<div>Building Number 01</div> <div>Drawing Number 1-3-A-102</div>	
					<div><div>VOSB</div><div>Swim, Schuchat, & Cornett Engineering, Inc.</div><div>MEP & Structural Engineer 18207 Edison Avenue Chesterfield, MO 63005</div><div>Tel 636.530.7770 Fax 636.530.7877</div></div>				<div>Checked JB</div> <div>Drawn MP</div>							
													<div><div>V</div><div>Department of Veterans Affairs</div></div>			