NE 15th STREET

N. McMECHAN STREET

N. KELLY STREET

NE 13th STREET

SEE DETAIL 'A'

AUXILIARY OXYGEN TANK

AUX OXY 1

MAIN OXYGEN TANK

OXY 1

BLDG. 21

HEALTH WING

ARF BLDG.

STAIR

BLDG. 3

BLDG. 19

NO PARKING

EMERGENCY GENERATOR

BOILER ROOM BLDG. 5

CHILLER PLANT BLDG. 18

TUNNEL

MECHANICAL ROOM FIRE BASEMENT BLDG 1

STAIR #3

STAIR #4

GEN. RM BLDG. 20

OX

EMERGENCY TIE IN FOR OXYGEN

BLDG. 1

STAIR #7

STAIR #2

STAIR #1

STAIR #5

MAIN SHUT OFF LOCATION FOR OXYGEN, NITROGEN & NITROUS OXIDE MED GAS ROOM BA125

MECHANICAL ROOM

SECURITY

BUS SHELTER

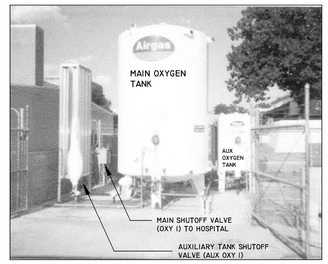

DETAIL "A"
NO SCALE

SET CONTAINS LAYOUT OF:

- OXYGEN
- MEDICAL AIR
- MEDICAL VACUUM
- NITROUS OXIDE
- NITROGEN
- LABORATORY AIR
- LABORATORY VACUUM

1"=30'

Drawing Title: MEDICAL GASES SITE PLAN	Project Title: UTILITY ASBUILTS		Date: JUL 2004
			Project No.
Approved: Divison Chief	Building Number	Checked: TD / Drawn: DRE	DRAWING NO. Dwg. 1 Of 12
Approved: Service Director	Location: VA MEDICAL CENTER OKLAHOMA CITY, OKLAHOMA		

DEPARTMENT of VETERANS AFFAIRS

F:\MEDGAS\UTILITY\MEDGAS.DGN 09-Nov-04