

REFER TO SKETCH:  
SK-8-4-RW 6A1101

1 BLDG 6 OVERALL FIRST FLOOR PLAN  
SCALE: 1/16" = 1'-0"




GENERAL FLOOR PLAN NOTES

- REFER TO SHEET 0A1002 FOR PARTITION SCHEDULE AND GENERAL PARTITION TYPE NOTES.
- REFER TO A1400 SERIES FOR ENLARGED FLOOR PLAN VIEWS INCLUDING MEDICAL EQUIPMENT NOT SHOWN IN A1100 SERIES PLANS.
- REFER TO LIFESAFETY DRAWINGS (LS SERIES) FOR CAMPUS-WIDE SCOPE OF RATED WALL CONSTRUCTION, SMOKE PARTITIONS, SUITE DESIGNATIONS AND EXIT DISCHARGE INFORMATION.
- PARTITION TYPES AS NOTED BY THE SYMBOL CONTINUE BETWEEN ROOM/SPACE CORNERS OR ANY INTERSECTING PARTITION.
- DIFFERING PARTITION TYPES SHALL ALIGN SO THAT WALL PLANES CONTINUE UNBROKEN WITHIN CROSS ROOMS AND/OR SPACES. UNLESS OTHERWISE NOTED, DIMENSIONS ARE TO FINISH FACE.
- REFER TO A1000 SERIES DRAWINGS FOR DOOR & RELITE SCHEDULES.
- DISTANCE FROM HINGE SIDE OF DOOR TO INTERSECTING STUD WALL SHALL BE 4" UNLESS NOTED OR DETAILED OTHERWISE (MEASURED FROM OUTSIDE OF FRAME).
- CONTRACTOR SHALL VERIFY ALL DIMENSIONS NOTED AS "CLEAR" OR "MIN." DIMENSIONS NOTED AS "HOLD" ARE CRITICAL TO COORDINATE OTHER WORK (E.G. CEILING GRIDS, LIGHTING, FINISHES).
- CONTRACTOR SHALL VERIFY ALL DIMENSIONS PRIOR TO INITIATING CONSTRUCTION AND REPORT DISCREPANCIES TO ARCHITECT PRIOR TO COMMENCING WORK.
- CONTRACTOR SHALL PROVIDE ALL BLOCKING REQUIRED TO ANCHOR ALL WALL AND CEILING MOUNTED ITEMS, INCLUDING BUT NOT LIMITED TO TOILET ROOM ACCESSORIES, MILLWORK, CASEWORK, HANDRAILS, DOOR STOPS ETC.
- FIRE STOPPING SYSTEMS - REFER TO SPEC SECTION 07 54 00 FOR INFO REGARDING PENETRATIONS OF ALL FIRE RATED ASSEMBLIES.
- UP-SWING GRAB BAR IN-WALL SUPPORT - SEE DTLS C3 AND A3 SHEET 0A505 FOR TUBE STEEL BACKING AT ALL UP-SWING GRAB BARS.
- SEE DETAIL A30A1616 FOR COLUMN BASE WATERPROOFING AT EXPOSED COLUMNS IN SERVICE BAYS & MECHANICAL ROOMS.
- SHIELDING REQUIREMENTS - VERIFY ALL SHIELDING REQUIREMENTS WITH FINAL EQUIPMENT SELECTIONS AND A VA APPROVED REGISTERED PHYSICIST PRIOR TO COMMENCING WORK IN SHIELDED-ROOM AREAS. HOUSEKEEPING AND COPY ROOMS - ALL PARTITIONS TO BE FULL HEIGHT TO UNDERSIDE OF DECK/INTERSTITIAL ABOVE. SEE PARTITION TYPE NOTES SHEET 0A1002.

FLOOR PLAN SHEET NOTES

- FLOOR PLAN SHEET NOTE SERIES BEGINS WITH NOTE 100 NOT ALL SHEET NOTES APPEAR ON EVERY SHEET
- SLAB OPENING - REF STRUCTURAL DWGS
  - ALIGN PARTITIONS
  - LINE OF CURTAIN WALL SILL - REF EXTERIOR SERIES DWGS.
  - LINE OF HOISTWAY BELOW
  - AIR HANDLER UNIT - REF MECHANICAL DWGS
  - STEEL BRACING - REF STRUCTURAL DWGS
  - CONCRETE HOUSEKEEPING PAD - REF STRUCTURAL DWGS
  - ACCORDIAN FIRE DOOR - REF DOOR SCHEDULE
  - ADD ALT 8.01: 14 92 00 PNEUMATIC TUBE STATION - REF DETAILS C4 & C50A507.
  - 08 31 13 FLOOR VAULT DOOR - 36" X 36" - REF DTL E10A516
  - ROOF/OVERFLOW DRAIN LEADER - REF PLUMBING DWGS
  - ELECTRICAL PANEL - REF ELECTRICAL DWGS
  - MEDICAL GAS ZONE VALVE BOX/MEDICAL GAS ALARM PANEL - REF MED GAS DWGS
  - SLOPE FLOORING IN SHOWER/TOILET ROOM TO FLOOR DRAIN
  - SLAB RECESS FOR HIGH DENSITY SHELVING TRACK. VFY RECESS DIMENSION W/ SHELVING MANUFACTURER.
  - 14 91 34 TRASHLINEN CHUTE & STATION - SEE DETAILS E60A507
  - 14 91 34 TRASHLINEN CHUTE: NO LOADING STATION
  - 14 91 34 TRASHLINEN CHUTE: PROVIDE SLEEVES @ LEVEL 01 FLOOR SLAB PENETRATION - SEE DETAILS E60A507
  - 08 31 13 3-HOUR FIRE RATED ACCESS PANEL - 24" X 48"
  - ELECTRICAL RISERS - SEE PLAN DETS ON F50A512 - REF ELEC DWGS
  - CONCRETE ENCASED ELECTRICAL FEEDERS ABOVE - REF STRUCTURAL & ELEC DWGS
  - 09 27 02 GLASS FIBER REINFORCED GYPSUM COLUMN COVER - 36" O.D. LUN.
  - BOLD DASHED LINE INDICATES ROUTE OF STRUCTURAL EXPANSION JOINT - REF STRUCTURAL DWGS. REFERENCE FLOOR PLAN LEGEND FOR INTERIOR EXPANSION JOINT COVER ASSEMBLY INFORMATION.
  - 10 11 00 MARKER BOARD REF INTERIOR ELEV SHEET NOTE 207.
  - 10 11 00 TACK BOARD REF INTERIOR ELEV SHEET NOTE 208.
  - 10 28 00 FOLD-DOWN BENCH
  - 10 28 00 FOLD-DOWN SHOWER SEAT
  - SLAB RECESS FOR WALK-OFF GRILLE. VFY RECESS DIMENSION W/ GRILLE MANUFACTURER. SEE FLOOR FINISH PLANS FOR EXTENTS.
  - PLUMBING ROUGH-IN FOR FUTURE SINK - REF PLUMBING DWGS.
  - BENT PLATE W/ TRAFFIC COATING WRAP @ WALL BASE - REF B30A516
  - LINE OF 2-HR RATED SHAFT ABOVE. REF DETAILS E1 & E3 SH1 0A507
  - 05 05 00 ACCESS LADDER
  - 10 33 13 WIRE MESH PARTITION
  - 05 52 13 PIPE AND TUBE RAILING
  - 11 13 00 MANUAL DOCK LEVELER AND BUMPERS
  - 13 44 00 MODULAR MEZZANINES INCL. STAIRS & WIRE MESH PTNS.
  - 05 50 00 METAL GRATE CATWALK
  - WALL MOUNTED HAND SINK - REF PLUMBING DWGS
  - RECESSED EMERGENCY SHOWER AND EXPOSED STAINLESS STEEL SHOWER HEAD - REF PLUMBING DWGS
  - 08 39 19 FLOOD BARRIERS: FLOOD PLANK SYSTEM - REF D50A511
  - CONC. WALLS @ L 01 ELEV SHAFTS - REF STRUCT DWGS & DTL D20A507
  - BENT PLATE W/ PEDESTRIAN TRAFFIC COATING WRAP - REF C30A516
  - PLENUM SYSTEM - SEE EXTERIOR DRAWINGS
  - CENTER PARTITION ON GRIDLINE
  - CENTER PARTITION ON MULLION
  - 10 21 13 TOILET PARTITIONS
  - TOP OF SHAFT LID ASSEMBLY - REF DETAIL B40A507
  - CONC CURB W/ PEDESTRIAN TRAFFIC COATING WRAP - REF D30A516
  - LIGHTING INVERTER CABINET - REF ELEC DWGS
  - ELEVATOR SUMP PUMP CONTROL PANEL - REF PLUMB DWGS

KEY PLAN

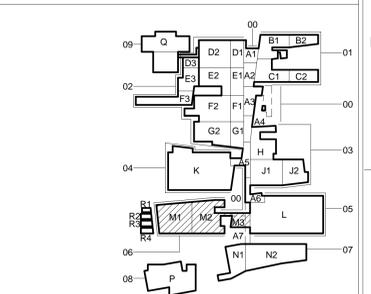

CONSTRUCTION DOCUMENTS 1  
FULLY SPRINKLERED

REVISIONS:	DATE	CONSULTANTS:
		DESMAN ASSOCIATES / PARKING
		CODE CONSULTANTS, INC. / CODE CONSULTANT
		THE SEXTANT GROUP / AV & ACOUSTICAL
		HAMMER DESIGN ASSOCIATES / FOOD SERVICE
		PYBURN & ODOM / ABATEMENT
		TATA & HOWARD / TANK CONSULTANT
		I.S.C. GROUP, INC. / IRRIGATION
		DAN EUSER WATER ARCHITECTURE, INC. / WATER FEATURE

**ARCHITECT/ENGINEERS:**  
 studio **NOVA**  
 SCHRENK & PETERSON CONSULTING ENGINEERS / CIVIL  
 KORDA / NEMETH ENGINEERING / STRUCTURAL  
 BR+A CONSULTING ENGINEERS / MECH. ELECT. PLUMBING, LOW VOLTAGE  
 ARCHITECTURAL ENGINEERING / PLUMBING  
 SCALES ASSOCIATES / FIRE PROTECTION  
 COMMUNICATIONS DESIGN GROUP / LOW VOLTAGE

DRAWING TITLE  
BLDG 6 OVERALL FIRST FLOOR PLAN

APPROVED: PROJECT DIRECTOR  
*Judd Sanders*

PROJECT TITLE  
SLV/HCS REPLACEMENT MEDICAL CENTER PROJECT

LOCATION  
NEW ORLEANS, LOUISIANA

DATE  
February 29, 2012

CHECKED  
MD

DRAWN  
AD

PROJECT NUMBER  
629-HS2-401

BUILDING NUMBER  
06

DOCUMENT SET PACKAGE  
WP\_08

DRAWING NUMBER  
**6A1101**

OFFICE OF CONSTRUCTION AND FACILITIES MANAGEMENT