



GENERAL NOTES - INTERIOR ELEVATIONS


- A. ALL WORK SHOWN "N.I.C." (NOT IN CONTRACT) MAY BE ACCOMPLISHED BY A CONTRACTOR WHO IS NOT INCLUDED AS PART OF THE COORDINATE WITH "OTHER" CONTRACTORS PERFORMING N.I.C. WORK WHICH IMPACTS OR RELATES TO WORK WHICH IS PART OF THE "CONSTRUCTION AGREEMENT".
- B. ALL PARTITIONS ARE TYPE "1" UNLESS OTHERWISE NOTED.
- C. ALL DIMENSIONS ARE FROM FACE OF PARTITION TO FACE OF PARTITION UNLESS OTHERWISE NOTED. UNDER NO CIRCUMSTANCES SHALL ANY MEASUREMENT BE SCALED FROM THE DRAWINGS. ANY MEASUREMENT NOT GIVEN AN ACTUAL NUMBER DIMENSION SHOULD BE BROUGHT TO THE ARCHITECT'S ATTENTION BEFORE PROCEEDING.
- D. PROVIDE WATER RESISTANT GWB AT WALLS WHERE PLUMBING FIXTURES ARE LOCATED.
- E. ALL CABINETS TO HAVE LOCKING HARDWARE AND KEY. FURNISH KEY TO OWNER UPON COMPLETION.
- F. HOT WATER AND DRAIN PIPES UNDER LAVATORIES SHALL BE INSULATED OR OTHERWISE CONFIGURED TO PROTECT AGAINST CONTACT.
- G. PROVIDE FIRE TREATED WOOD BLOCKING AS REQUIRED FOR INSTALLATION OF ACCESSORIES.
- H. MOUNTING AND LOCATION OF ACCESSORIES IN ACCORDANCE WITH ADA ACCESSIBILITY GUIDELINES.
- I. COORDINATE SPECIFIC FIXTURE MANUFACTURER AND MODEL WITH P-SERIES DRAWINGS.

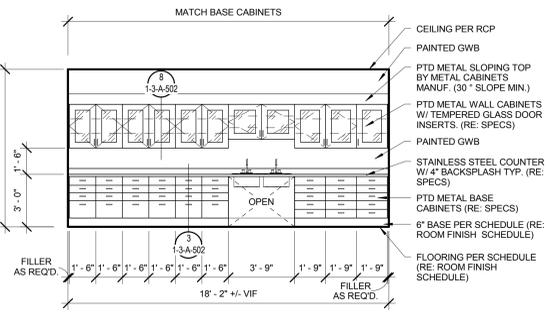


1 ELEVATION - ANESTHESIA WORK SUPPLY D406 - EAST
1/4" = 1'-0"

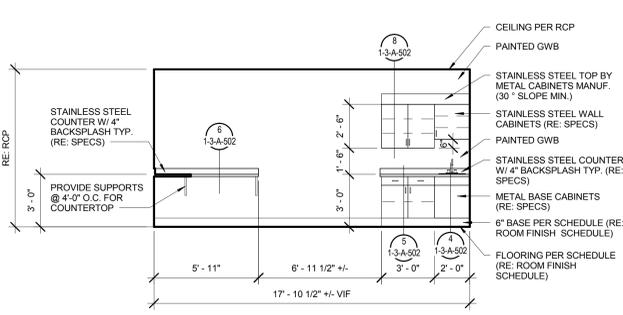


2 ELEVATION - FROZEN SECTION D405 - NORTH
1/4" = 1'-0"

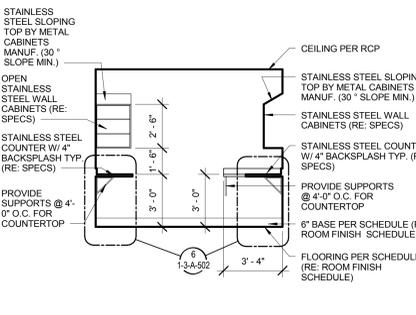


3 ELEVATION - FROZEN SECTION D405 - WEST
1/4" = 1'-0"

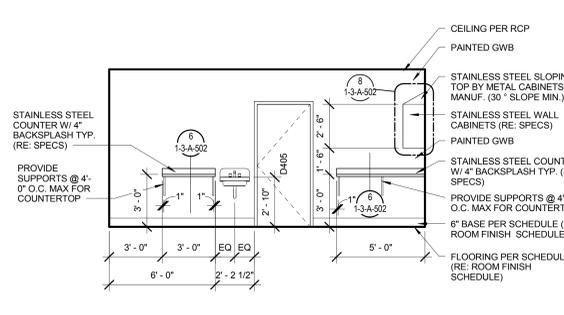


4 ELEVATION - FROZEN SECTION D405 - SOUTH
1/4" = 1'-0"

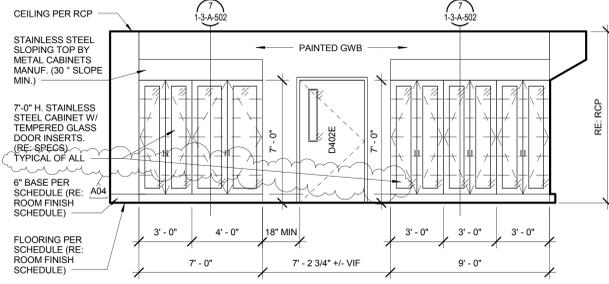


5 ELEVATION - BI-PLANE HYBRID OR #1 D402 - NORTH
1/4" = 1'-0"

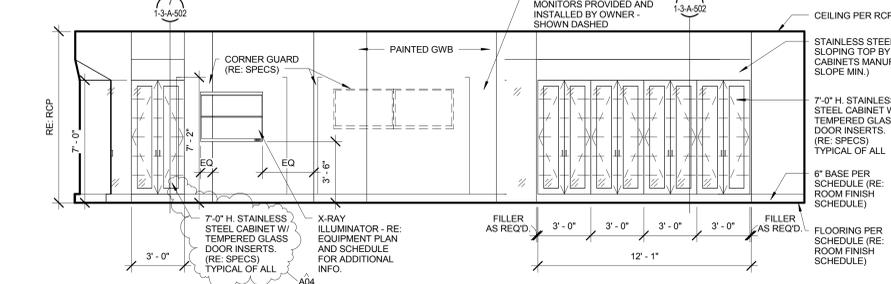


6 ELEVATION - BI-PLANE HYBRID OR #1 D402 - EAST
1/4" = 1'-0"

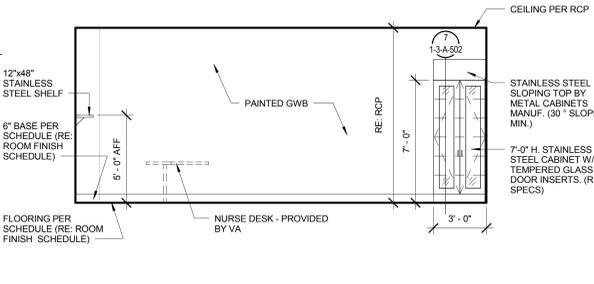


7 ELEVATION - GENERAL OR #2 D408 - NORTH
1/4" = 1'-0"

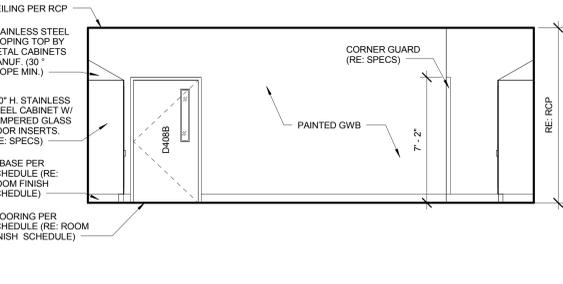


8 ELEVATION - GENERAL OR #2 D408 - EAST
1/4" = 1'-0"

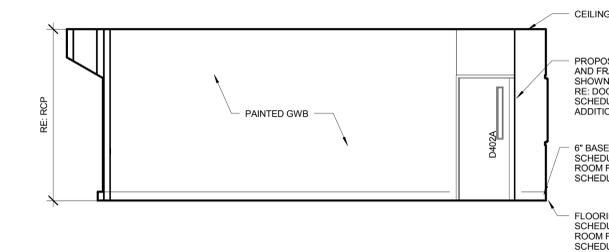


9 ELEVATION - BI-PLANE HYBRID OR #1 D402 - SOUTH
1/4" = 1'-0"

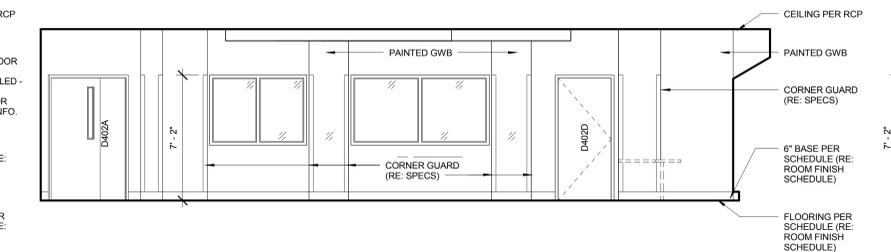


10 ELEVATION - BI-PLANE HYBRID OR #1 D402 - WEST
1/4" = 1'-0"

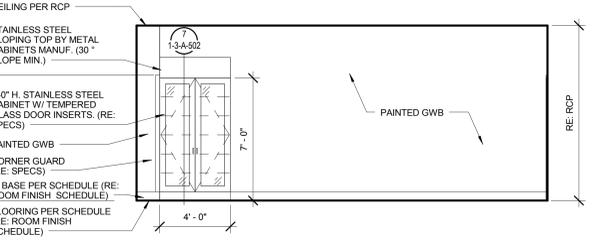


11 ELEVATION - GENERAL OR #2 D408 - SOUTH
1/4" = 1'-0"

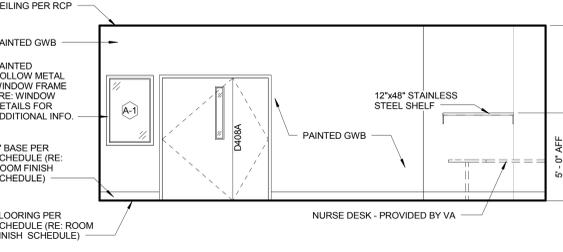


12 ELEVATION - GENERAL OR #2 D408 - WEST
1/4" = 1'-0"

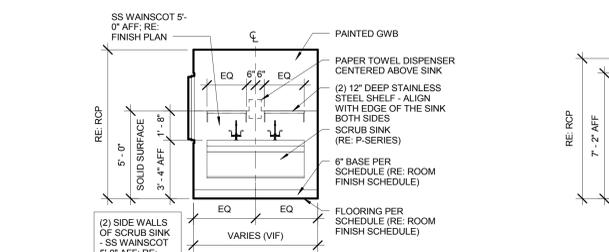


13 ELEVATION - TYPICAL SCRUB AREA - PHASE 3
1/4" = 1'-0"

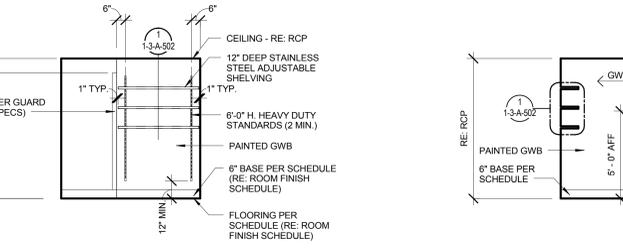


14 ELEVATION - HAC D409 - EAST
1/4" = 1'-0"

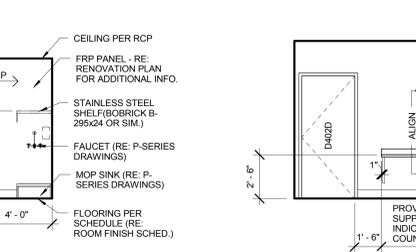


15 ELEVATION - HAC D409 - SOUTH
1/4" = 1'-0"

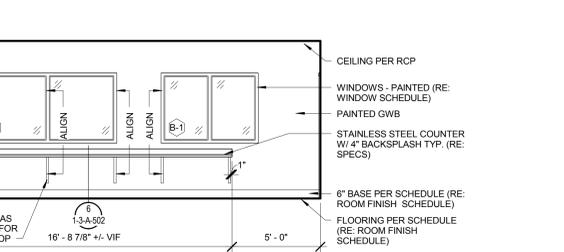


17 ELEVATION - CONTROL ROOM D402B - EAST
1/4" = 1'-0"

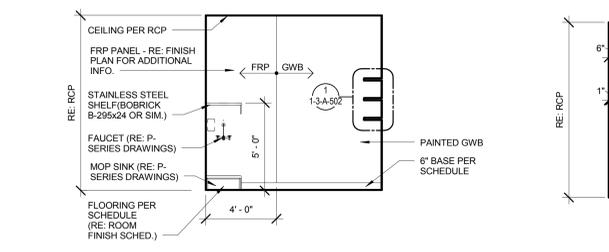


18 ELEVATION - CC HAC D403 - SOUTH
1/4" = 1'-0"

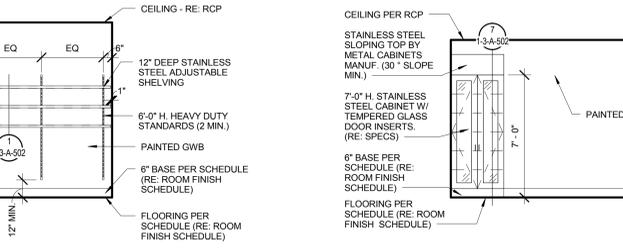

19 ELEVATION - CC HAC D403 - WEST
1/4" = 1'-0"

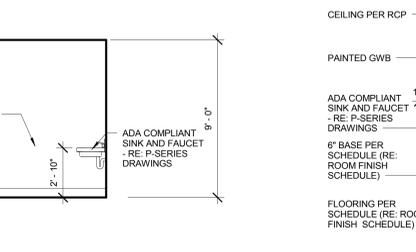

20 ELEVATION - PRE-INDUCTION D407 - EAST
1/4" = 1'-0"

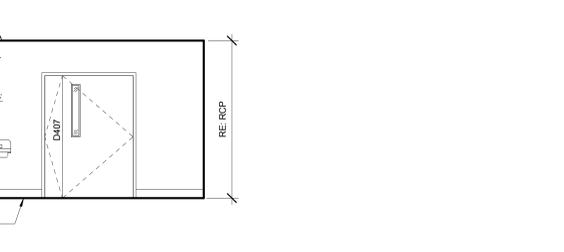

21 ELEVATION - PRE-INDUCTION D407 - SOUTH
1/4" = 1'-0"

Revisions:	Date
A04 Revision A00004	06/06/16

CONSULTANTS:

ARCHITECT/ENGINEERS:

FoxArchitects
One Memorial Drive Suite 1800 Saint Louis, MO 63102
Tel 314.621.4343 Fax 314.621.0261

SSC Swirn, Schuchat, & Cornett Engineering, Inc.
MEP & Structural Engineer
18207 Edison Avenue Chesterfield, MO 63005
Tel 636.530.7770 Fax 636.530.7877

Drawing Title	
INTERIOR ELEVATIONS	
Approved: Associate Director	Approved: Chief Engineer
Approved: Chief of Staff	Approved: Safety Officer
Approved: Infection Control	Approved: Chief, Police & Security

Project Title	
PHASE 3: Renovation of Operating Rooms, ER & Triage	
Location	V.A.M.C. ST. LOUIS, MO JOHN COCHRAN DIVISION
Date	06/06/16
Checked	JB
Drawn	AO
Project Number	657-13-300JC
Building Number	01
Drawing Number	1-3-A-200

BID DOCUMENTS

Veterans Health Administration

Department of Veterans Affairs