


- KEY NOTES:**
1. PATCH EXISTING FLOOR PER DETAIL 1/1-3-S-501.
 2. DEMO EXISTING CONCRETE CURB PER 2/1-3-S-501 & PATCH EXISTING FLOOR PENETRATION PER DETAIL 1/1-3-S-501.
 3. NEW OPENING AND CURB IN EXISTING SLAB PER DETAIL 5/1-3-S-501. VERIFY EXACT LOCATION WITH MECH AND ARCH DRAWINGS.
 4. NEW SUPPLEMENTAL STEEL FRAMING PER TYPICAL DETAILS ON 1-3-S501.
 5. PATCH EXISTING ROOF PER DETAIL 2/1-3-S-501.
 6. NEW ROOF PENETRATION PER DETAIL 2/1-3-S-501.
 7. PATCH EXISTING PENETRATION THRU CMU WALL PER DETAIL 3/1-3-S-501.
 8. NEW PENETRATION THRU EXISTING WALL PER DETAIL 4/1-3-S-501.
 9. NEW MEDICAL BOOM SUPPORT SEE DETAIL 7 & 8/1-3-S-501.
 10. NEW MEDICAL FLOOR MOUNT TABLE SUPPORT.
 11. NEW DUCTWORK IN EXISTING FLOOR PENETRATION. G.C. RESPONSIBLE FOR TEMPORARY PATCHING WHEN OPENING IS EXPOSED AND POSES SAFETY HAZARD.
 12. NEW DUCTWORK IN EXISTING FLOOR PENETRATION. G.C. RESPONSIBLE FOR RESIZING EXISTING OPENING TO MATCH MECHANICAL OPENING REQUIREMENTS. TEMPORARY PATCHING WHEN OPENING IS EXPOSED AND POSES SAFETY HAZARD.

PHASE 3 - 1-3S-101 EXIST-7TH FLR (1983)
SCALE: 1/8" = 1'-0"

INTEGRATED CEILING SYSTEM TO BE SUPPORTED BY UNISTRUT SYSTEM ABOVE. REF MECHANICAL DRAWINGS AND SPECIFICATION FOR REQUIREMENTS

UNISTRUT SYSTEM BETWEEN STRUCTURAL STEEL AND PHILIPS RAILS. G.C. RESPONSIBLE FOR SUBMITTING DRAWINGS AND CALCULATIONS SIGNED AND SEALED BY A LICENSED STRUCTURAL ENGINEER TO COR FOR REVIEW

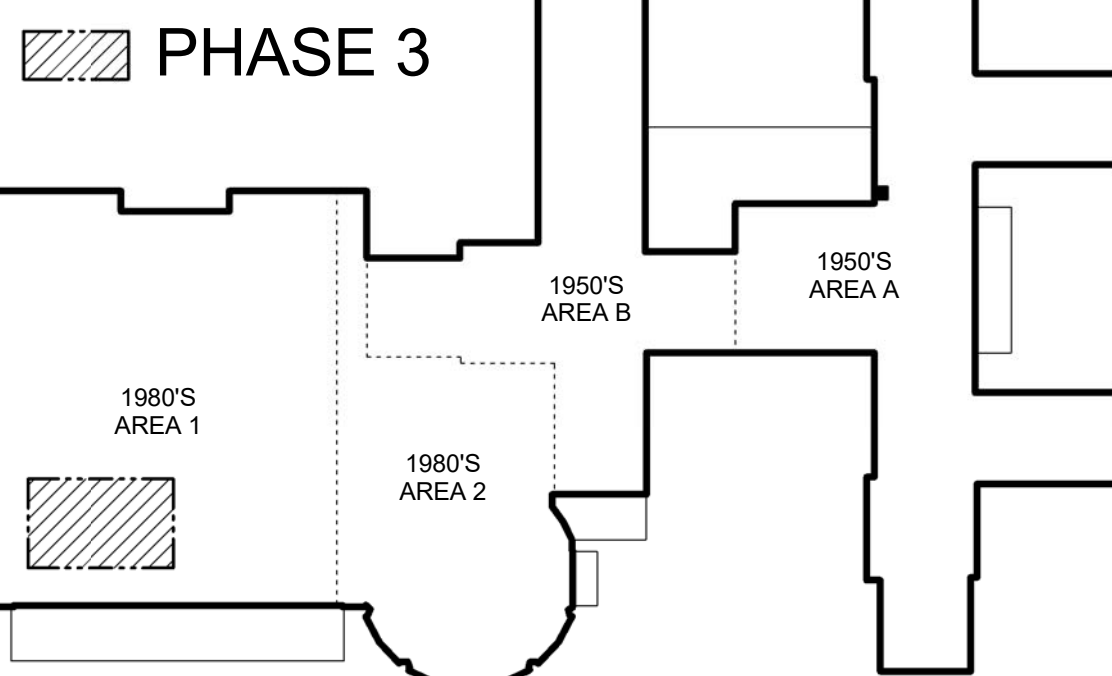

KEY PLAN - PHASE 3
SCALE: 1" = 80'-0"

Revisions:	Date
AMENDMENT A00004	06-06-16

CONSULTANTS:

ARCHITECT/ENGINEERS:

FoxArchitects

One Memorial Drive
Suite 1800
Saint Louis, MO 63102

Tel 314.621.4343
Fax 314.621.0261



SSC

Swim, Schuchat, & Cornett
Engineering, Inc.
1801 Cedar Avenue
Chesterfield, Missouri 63005
Phone 636.330.7770 Fax 636.330.7877
Missouri Certificate of Authority #NC 001244

Drawing Title
STRUCTURAL 4TH AND 5TH FLOOR FRAMING PLANS

Approved: Associate Director

Approved: Chief of Staff

Approved: Infection Control

Approved: Chief Engineer

Approved: Safety Officer

Approved: Chief, Police & Security

Project Title
Phase 3: Renovation of
Operating Rooms, ER & Triage

Location
V.A.M.C. ST. LOUIS, MO
JOHN COCHRAN DIVISION

Date
02/24/16

Checked
Designer

Drawn
Author

Project Number
657-13-300JC

Building Number
01

Drawing Number
1-3-S-101

**Veterans
Health
Administration**

