


NOTE: THIS SECTION OF ELEVATOR & STAIR TOWER MUST BE CONSTRUCTED ABOVE THE LAST FLOOR OF RENOVATED & NEW CONSTRUCTION ACCEPTED BY DEDUCTIVE BID OPTIONS. COORDINATE HEIGHTS WITH A201.

1 A303 SECTION @ STAIR TOWER
1/8" = 1'-0"

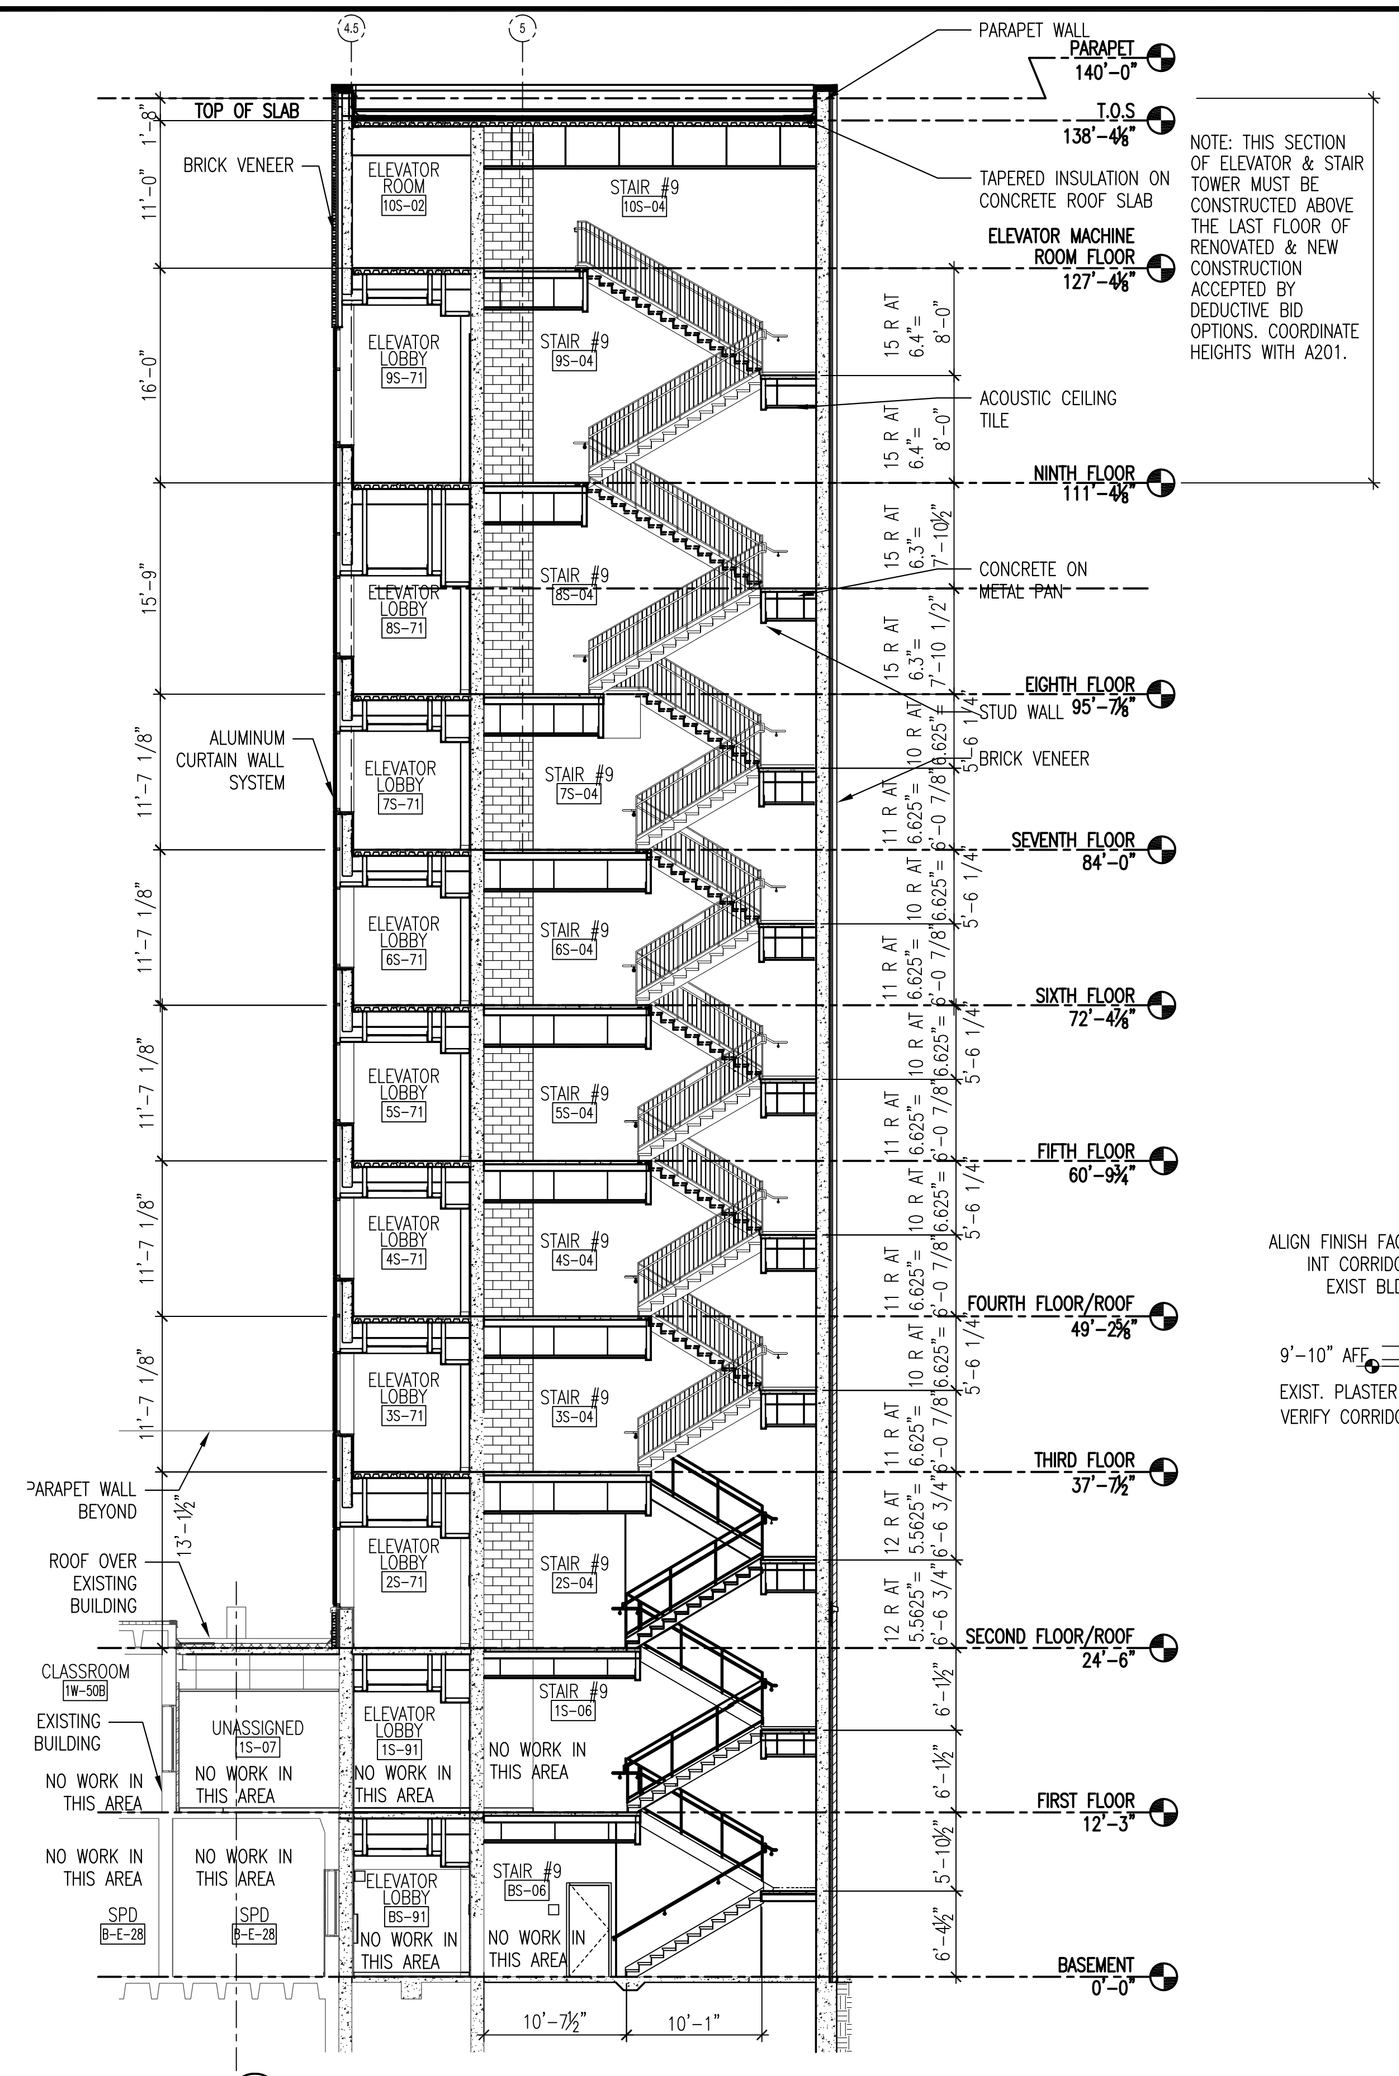


1 A303 ENLARGED REFLECTED CEILING PLAN @ 2ND FLOOR ELEVATOR LOBBY
1/4" = 1'-0"




4 A303 BULKHEAD DETAIL
1 1/2" = 1'-0"

NOTE:
BULKHEAD DETAIL APPLIES @ TRANSITION FROM NEW LOBBIES TO EXIST BLDG & AT ALL HEADERS IN EXISTING BLDG COORIDORS.

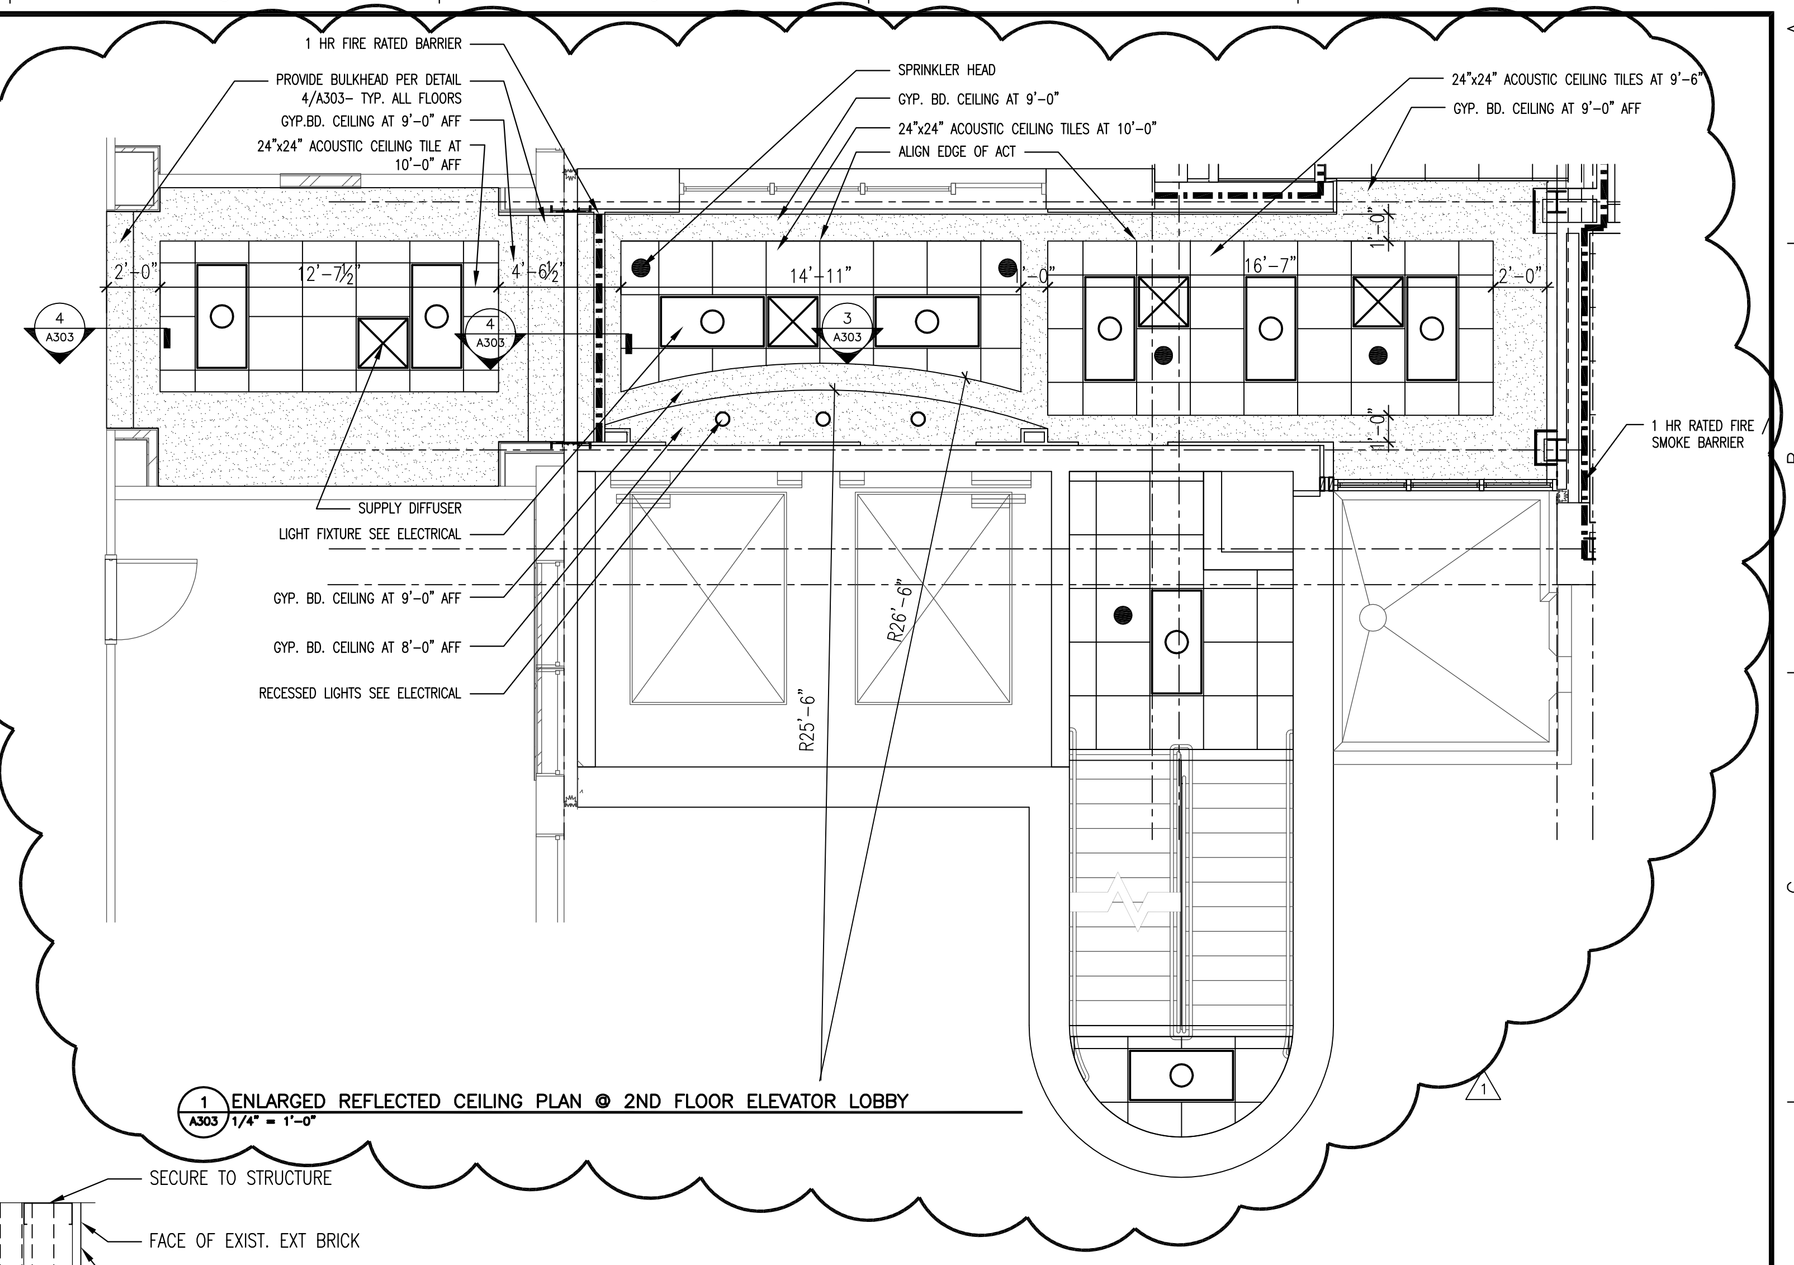


3 A303 ELEVATION @ 2ND FLOOR ELEVATOR LOBBY (TYP. 3RD–9TH FLOORS)
1/4" = 1'-0"

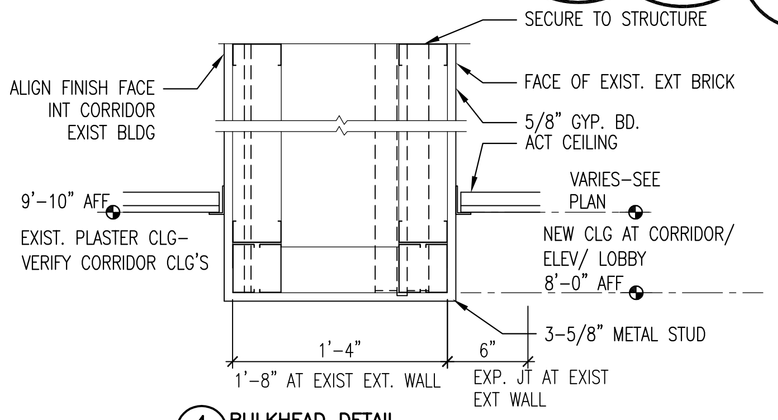NOTE:
ELEVATION AT ELEVATOR LOBBY TYPICAL THROUGHOUT ALL FLOORS

NORTH

100% REVIEW SUBMITTAL
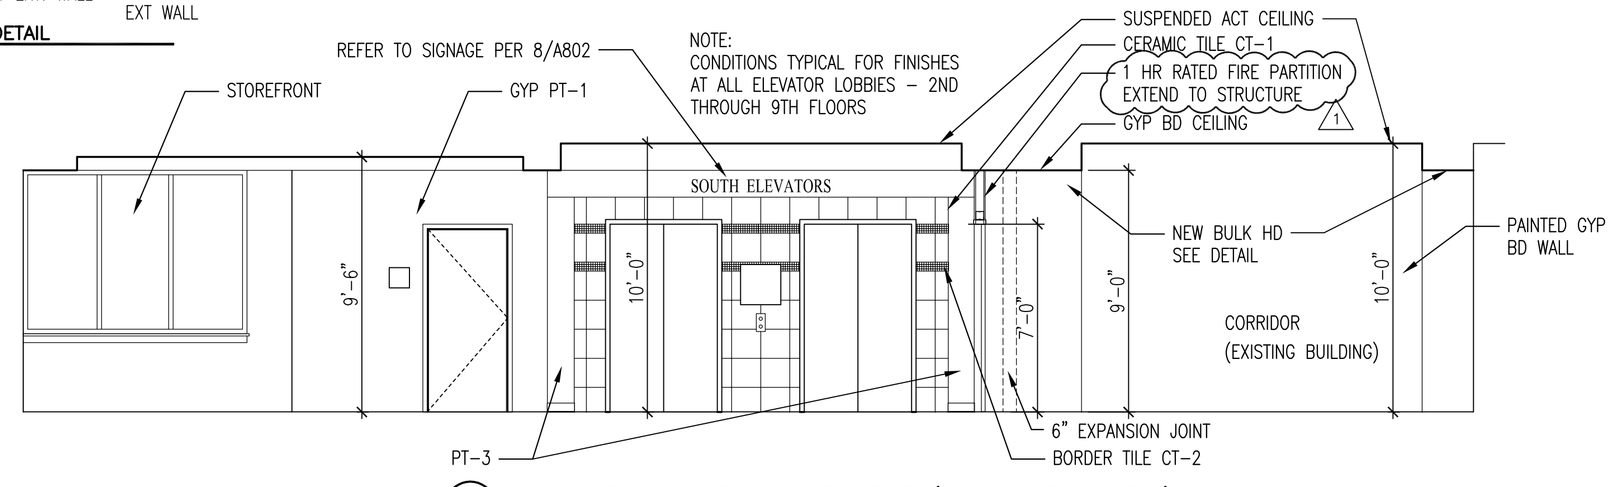
| | | |
|---|---|---|
| 1 | ADD 1HR DOOR AT ELEVATOR BRIDGE | 09/23/2011 |
| | Revisions | Date |


Toland◆Mizell◆Molnar, LLC
590 MEANS STREET NW,
SUITE 200
ATLANTA, GA, 30318
404-214-9774


ALAN J. TOLAND REG. NO. 6788 STATE OF LOUISIANA REGISTERED ARCHITECT

Drawing Title: STAIR TOWER SECTION

Approved Project Engineer:

Project Title: 2ND FLOOR OUTPATIENT MENTAL HEALTH
----

Building Number: BLDG 1 SOUTH WING | Checked: – | Drawn: –

Location: VA MEDICAL CENTER SHREVEPORT, LOUISIANA

Date: 05-25-2011

Project No.: VA256-C-1047

DRAWING NO.: A303
Dwg. – Of –

Veterans Administration

VA FORM 08-6231a, MAR 1984

U.S. GOVERNMENT PRINTING OFFICE:1984–440–467