

A

1

2

3

4

5

6

7


8

**NEW WORK NOTES:**

(THIS SHEET ONLY)


- 1 EXTEND NEW 6" STANDPIPE RISER FROM FLOOR BELOW AND EXTEND AS INDICATED. PROVIDE NEW ZONE VALVE WITH TAMPER SWITCH IN ACCORDANCE WITH NFPA 13. COORDINATE WITH ELECTRICAL DOCUMENTS.
- 2 EXTEND NEW SPRINKLER DRAIN PIPING UP FROM FLOOR BELOW PIPE SIZE SHALL BE SAME AS EXISTING DRAIN PIPING. PROVIDE NEW LINE SIZE ANGLE VALVE IN DRAIN PIPING.
- 3 PROVIDE FIRE HOSE CONNECTION IN ACCORDANCE WITH NFPA 13. REFER TO SPECIFICATIONS AND DETAIL ON SHEET 1-FP501.
- 4 MODIFY EXISTING SPRINKLER HEAD LOCATIONS AND SUPPLY PIPING IN THIS SPACE TO ACCOMMODATE NEW CEILING LAYOUT. SEE ARCHITECTURAL PLANS FOR REFLECTED CEILING PLAN AND HEAD LOCATIONS. NEW SPRINKLER HEAD LOCATIONS ARE NOT SHOWN. COORDINATE NEW HEAD LOCATIONS WITH NEW REFLECTED CEILING PLANS AND OTHER TRADES DESIGN AND INSTALL IN ACCORDANCE WITH NFPA 13 AND SPECIFICATIONS SECTION 21 13 13.
- 5 PROVIDE SPRINKLER HEADS WITH GUARDS IN ELEVATOR MACHINE ROOM.

one inch = one foot

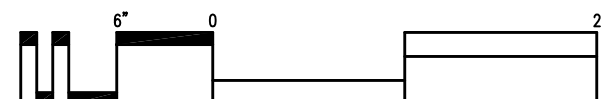

B


three-quarters inch = one foot

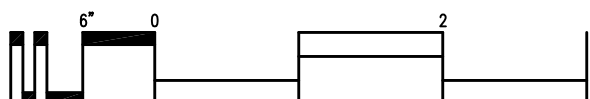

C


**ENLARGED FLOOR PLAN  
3RD FLOOR STAIRS – FIRE PROTECTION**

SCALE: 1/8" = 1'-0"

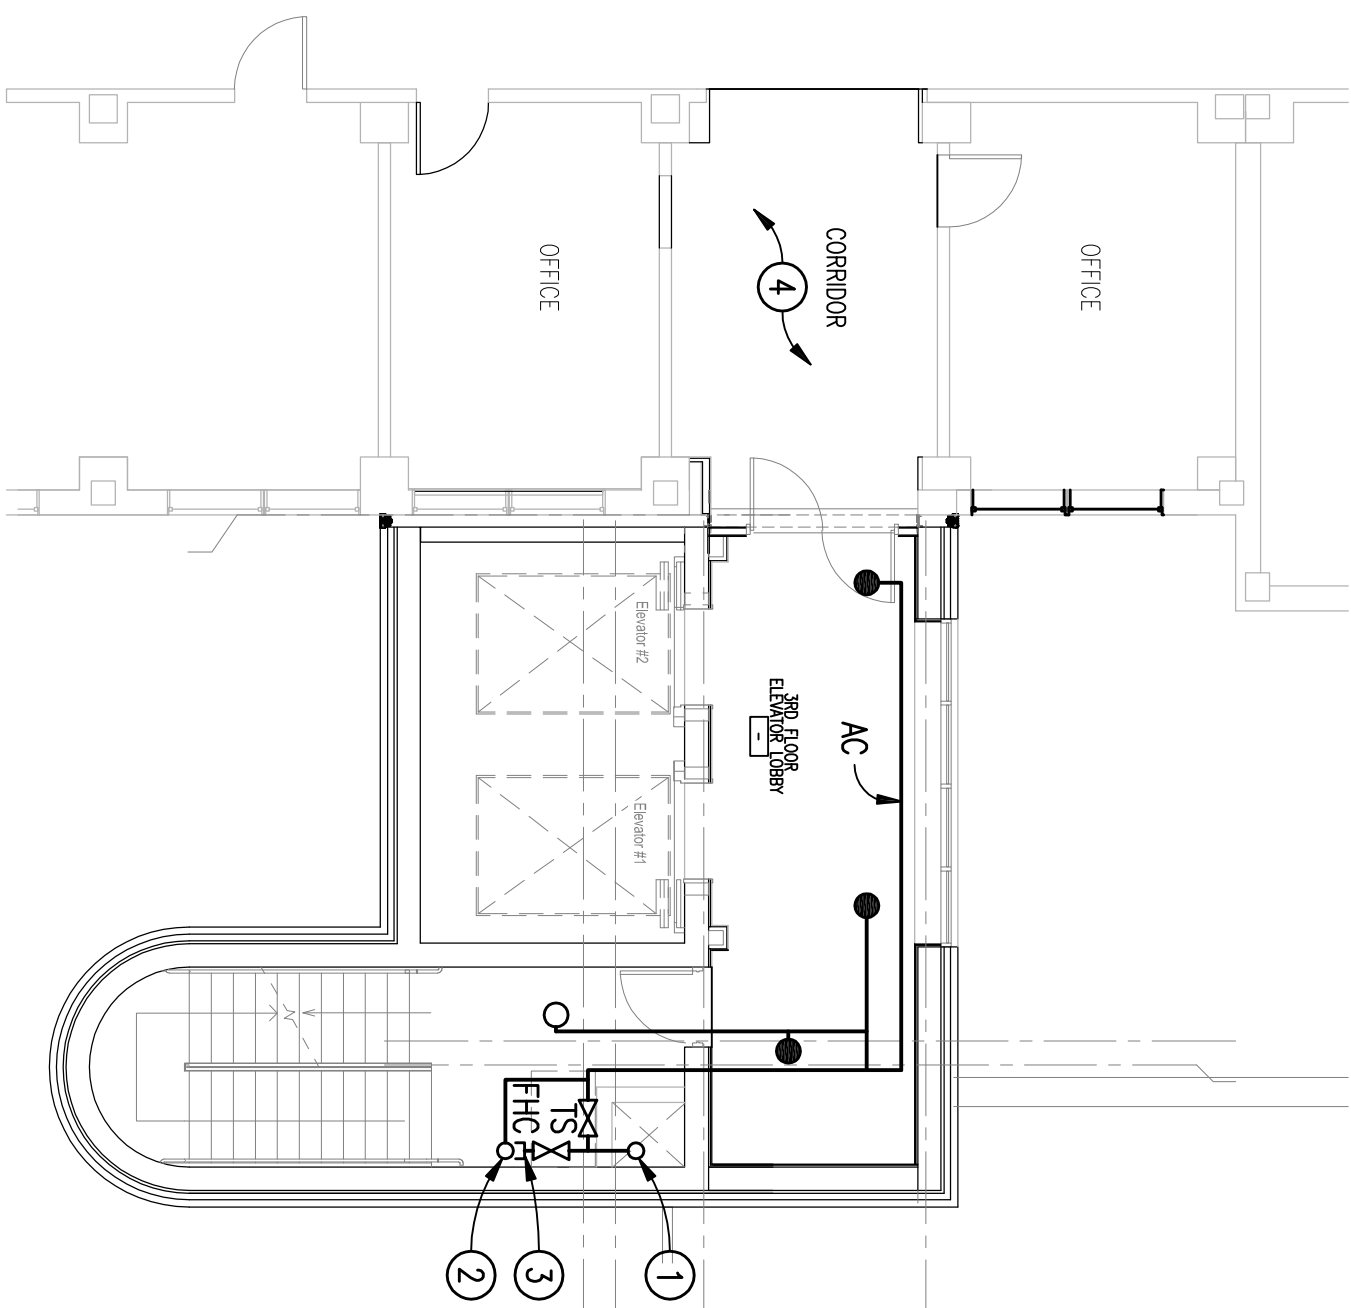


**ENLARGED FLOOR PLAN  
4TH FLOOR STAIRS – FIRE PROTECTION**

SCALE: 1/8" = 1'-0"

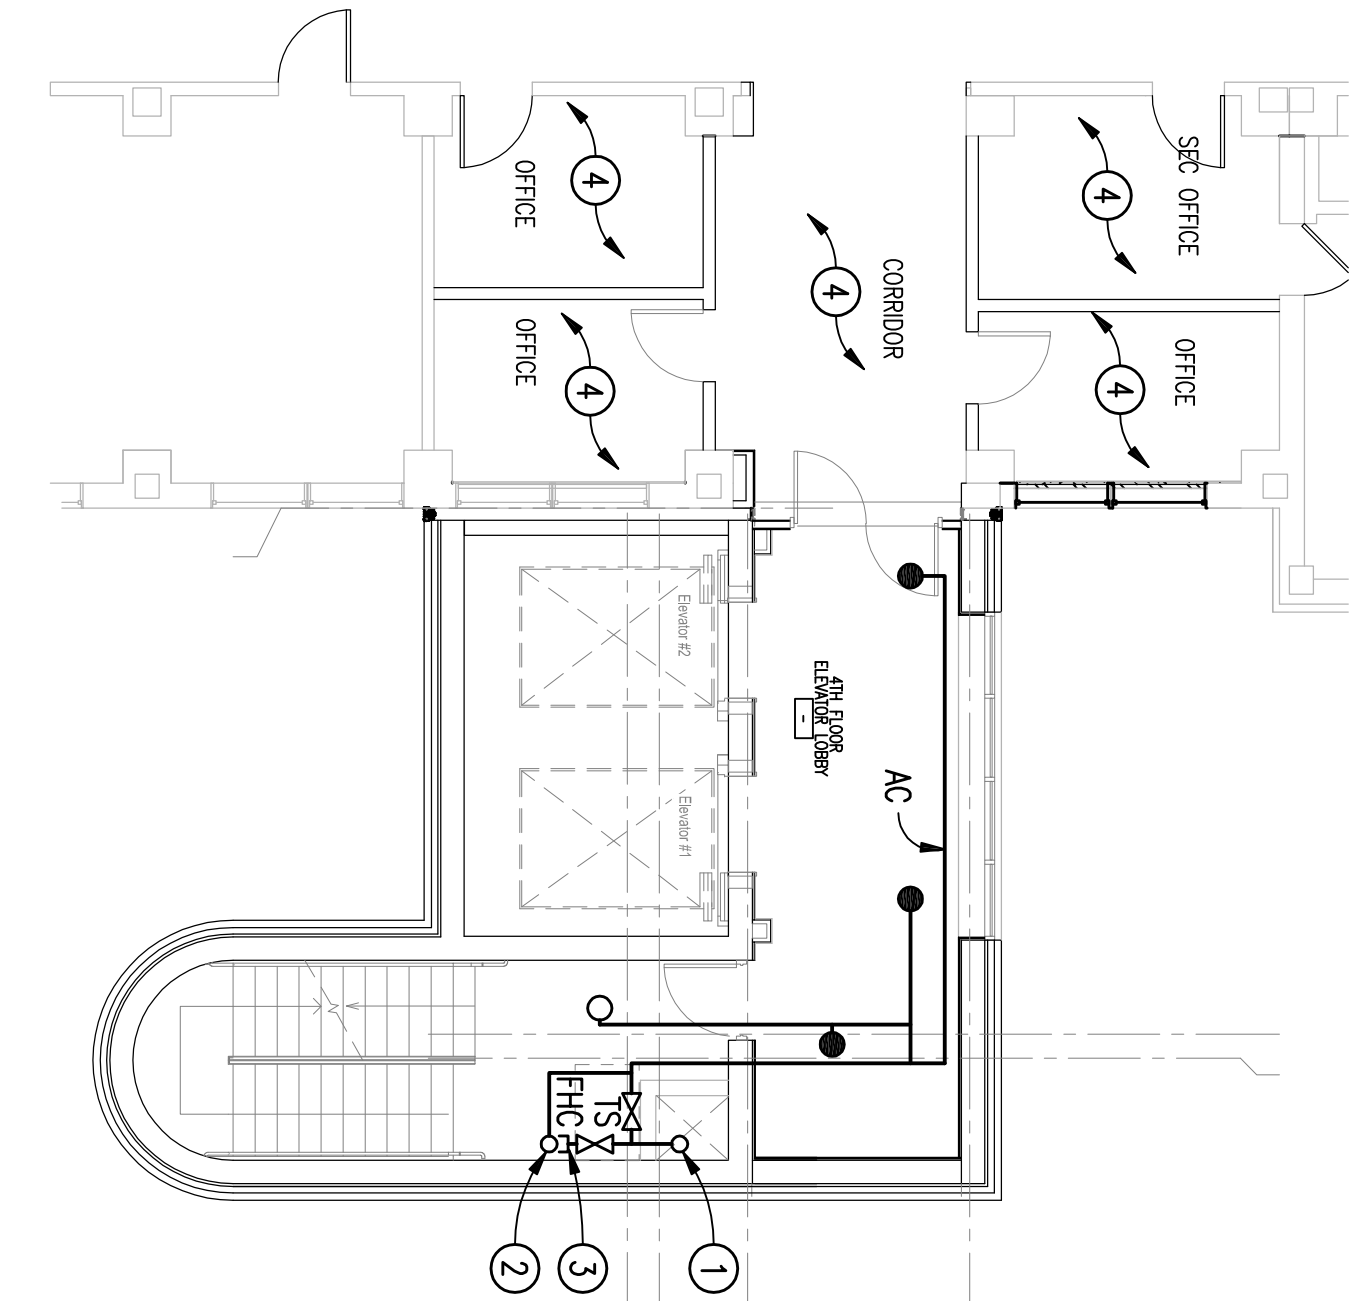


**ENLARGED FLOOR PLAN  
5TH FLOOR STAIRS – FIRE PROTECTION**

SCALE: 1/8" = 1'-0"

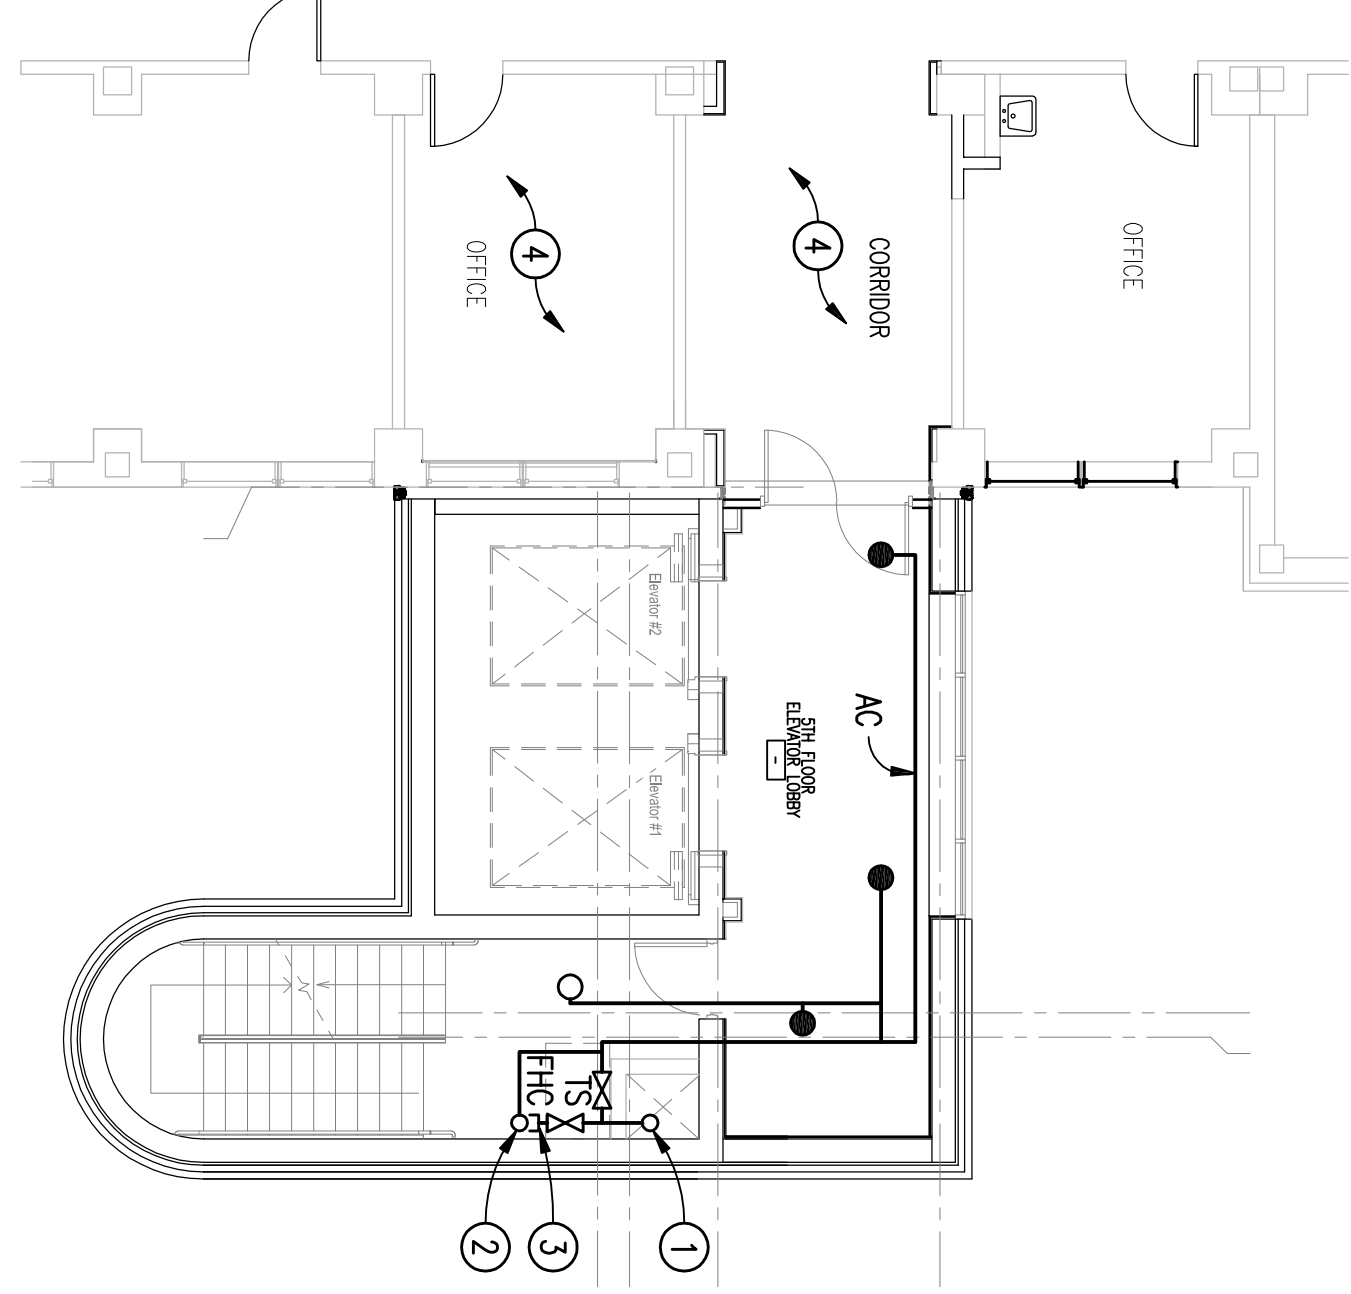


one-half inch = one foot

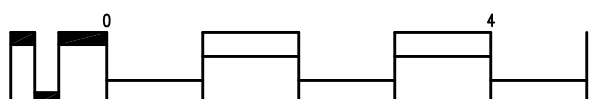

D


three-eighths inch = one foot

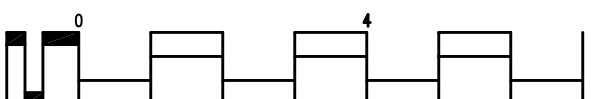

E


**ENLARGED FLOOR PLANS  
6TH & 7TH FLOOR STAIRS – FIRE PROTECTION**

SCALE: 1/8" = 1'-0"

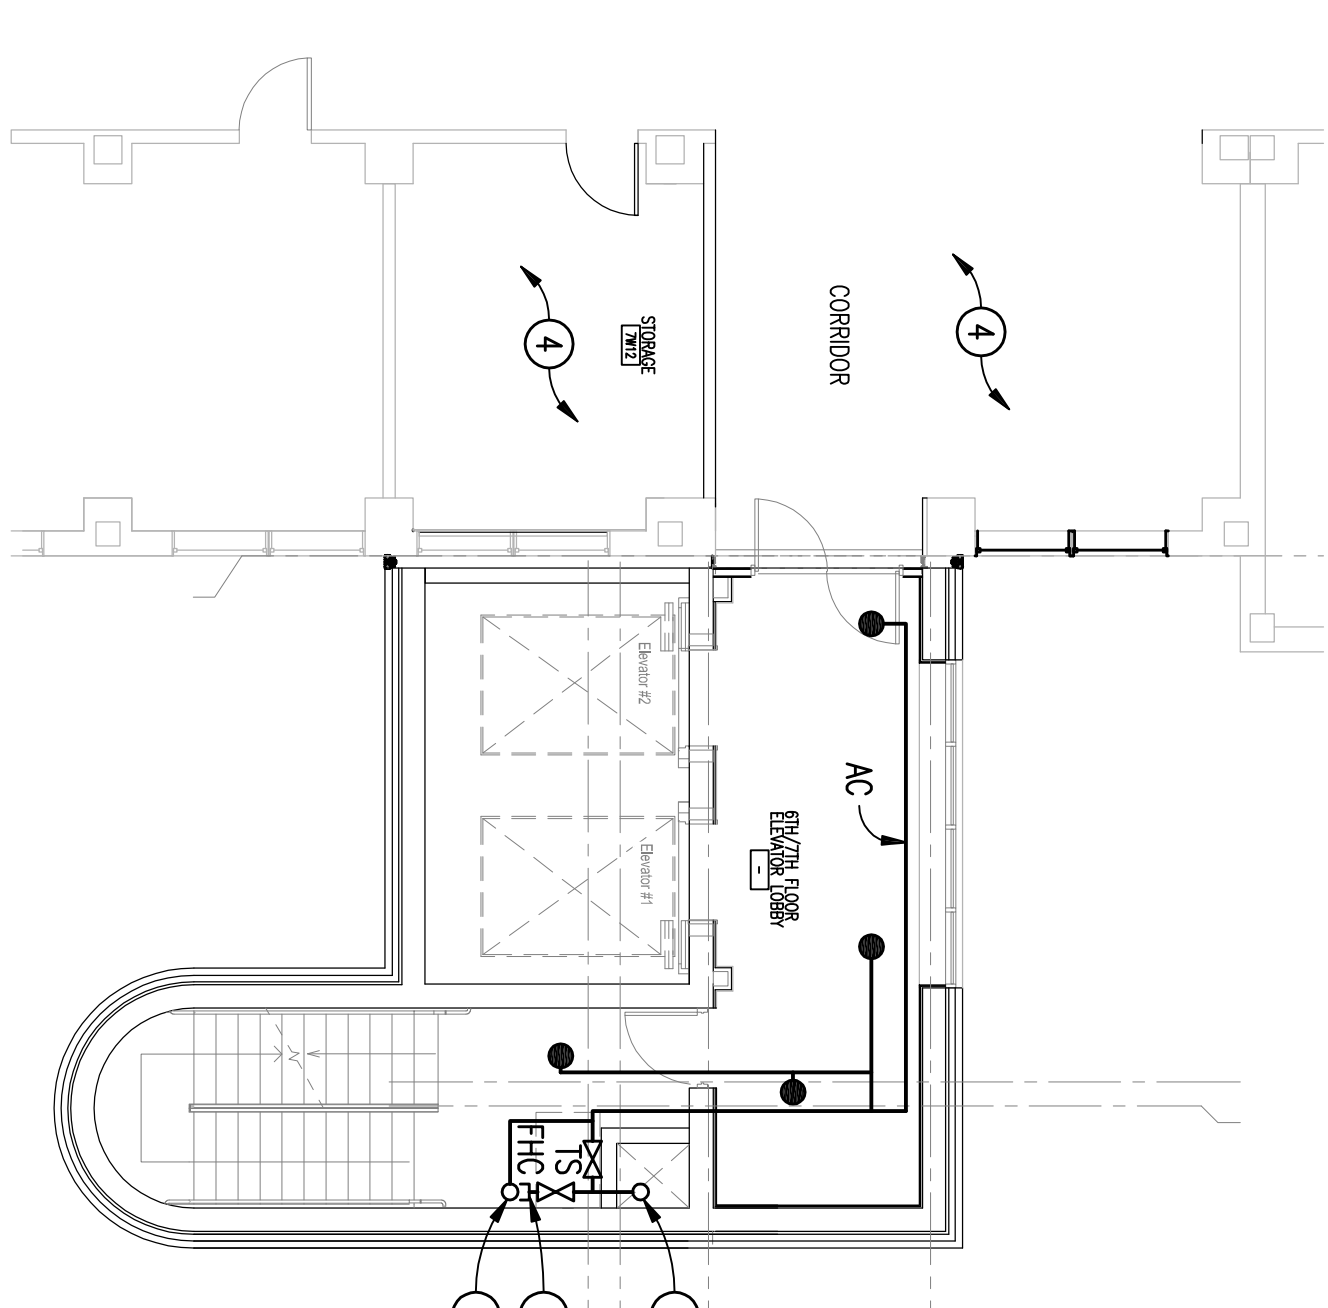


**ENLARGED FLOOR PLAN  
8TH FLOOR STAIRS – FIRE PROTECTION**

SCALE: 1/8" = 1'-0"

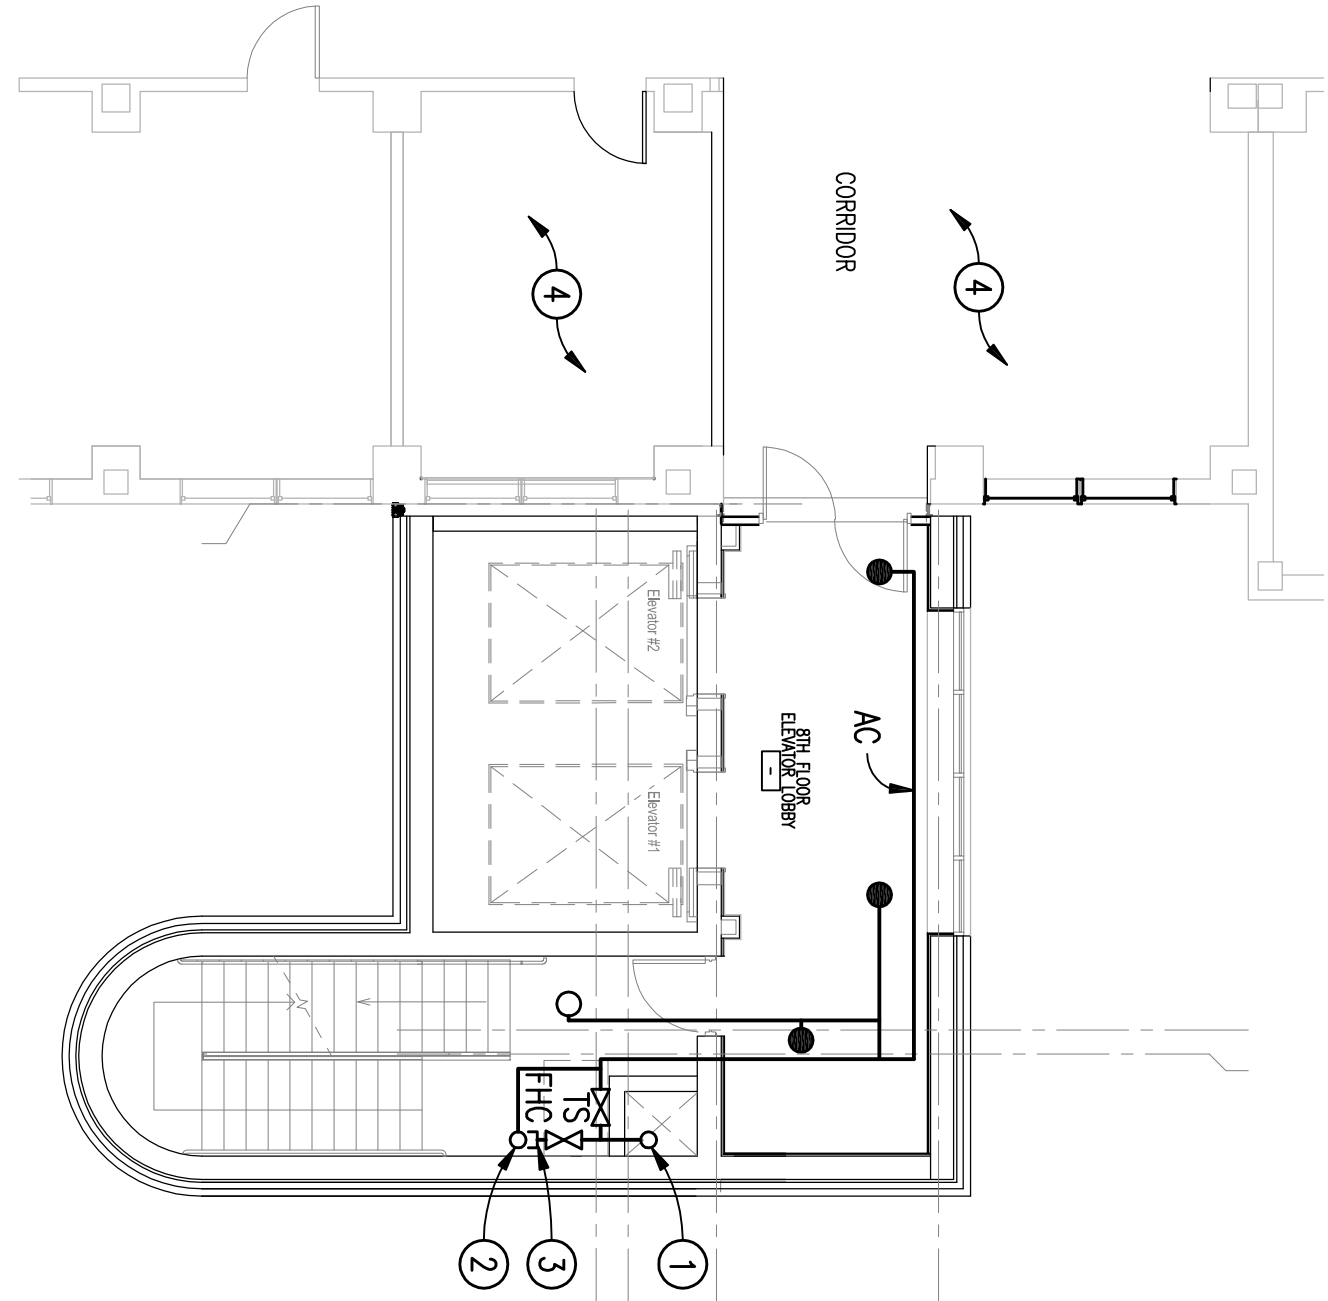


**ENLARGED FLOOR PLAN  
9TH FLOOR STAIRS – FIRE PROTECTION**

SCALE: 1/8" = 1'-0"

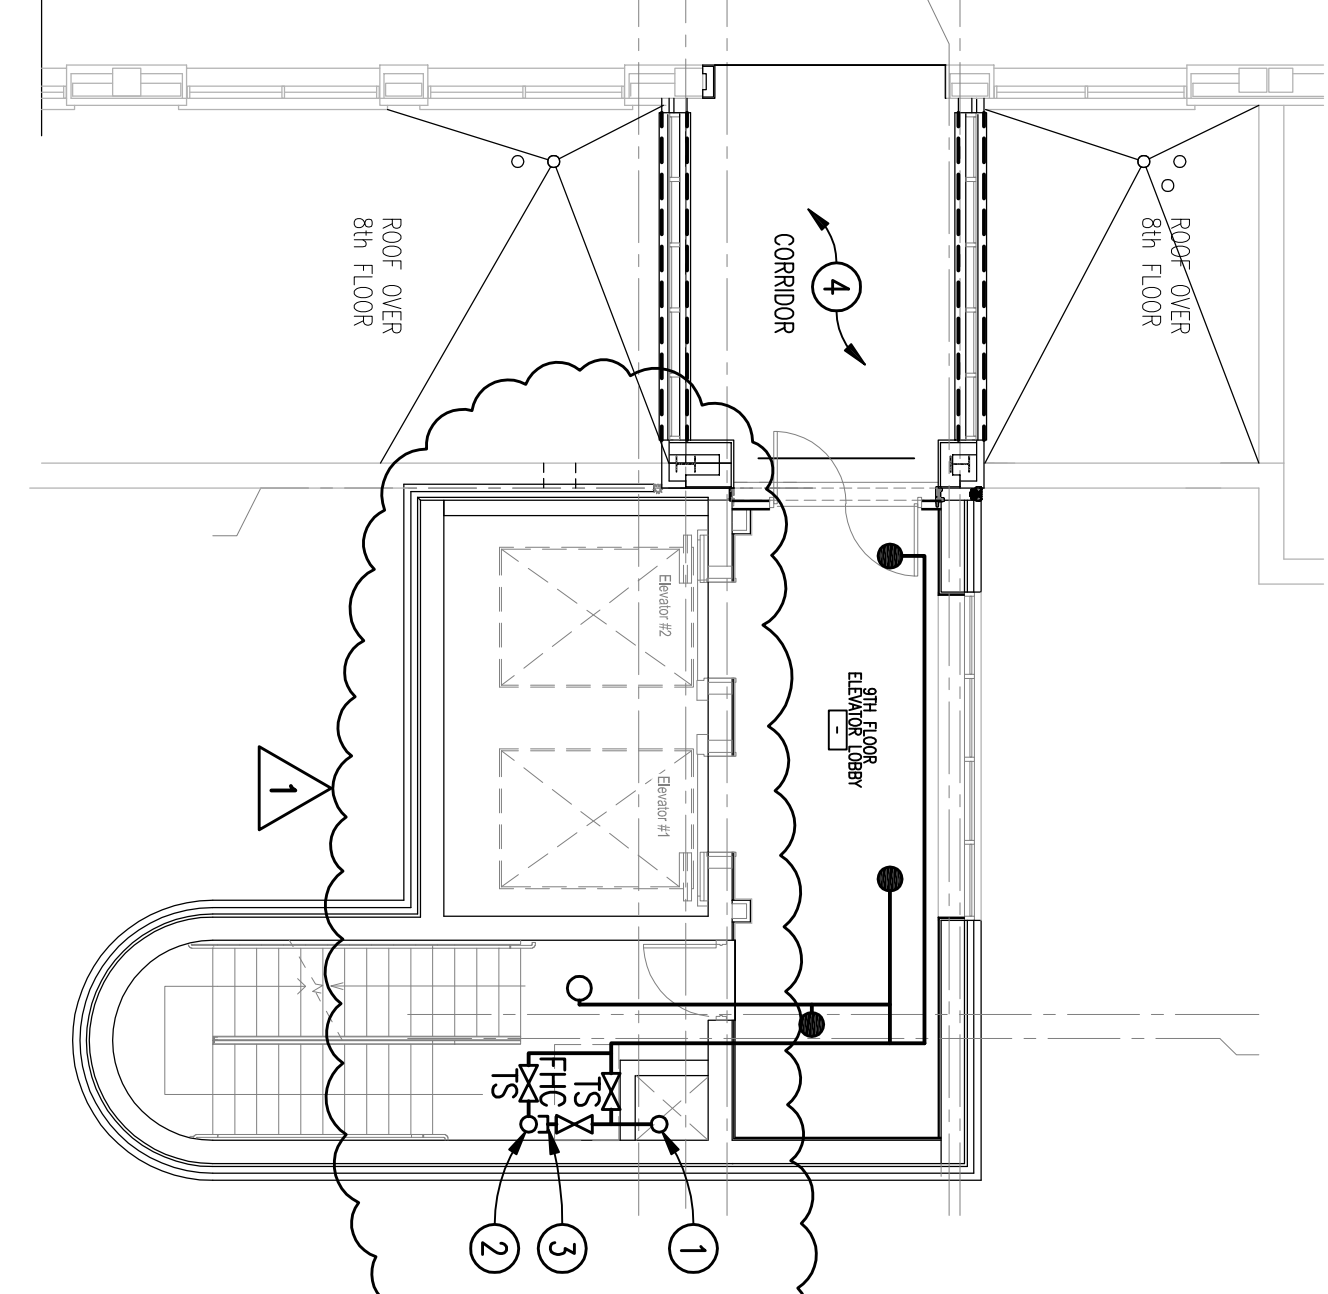




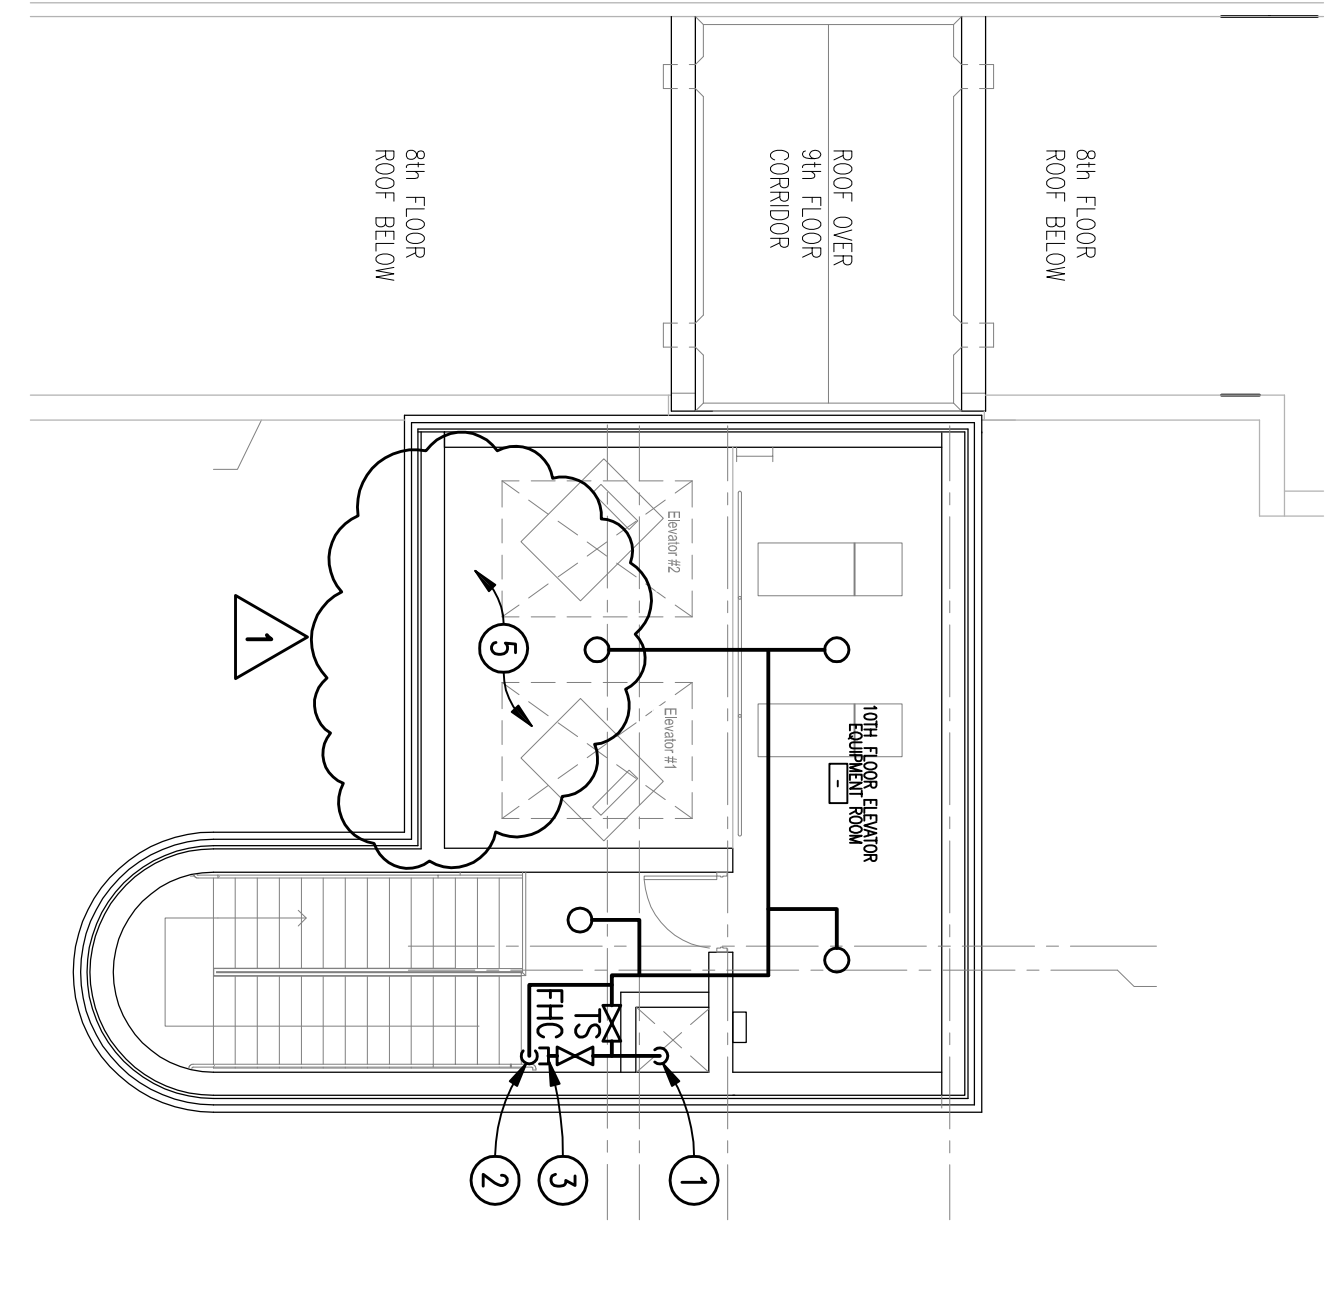


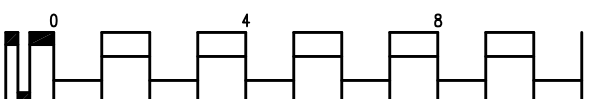

F


one-eighth inch = one foot



F


**ENLARGED FLOOR PLANS  
6TH & 7TH FLOOR STAIRS – FIRE PROTECTION**

SCALE: 1/8" = 1'-0"

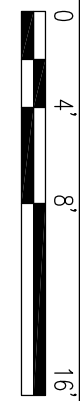


**ENLARGED FLOOR PLAN  
8TH FLOOR STAIRS – FIRE PROTECTION**

SCALE: 1/8" = 1'-0"

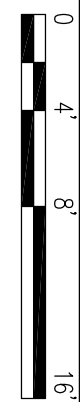


**ENLARGED FLOOR PLAN  
9TH FLOOR STAIRS – FIRE PROTECTION**

SCALE: 1/8" = 1'-0"

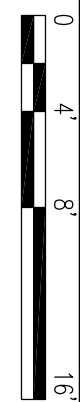

**ENLARGED FLOOR PLAN  
ELEVATOR MACHINE ROOM – FIRE PROTECTION**

SCALE: 1/8" = 1'-0"

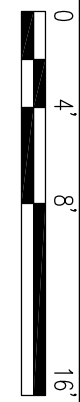

NOTE: CONTRACTOR SHALL PROVIDE HYDRAULIC CALCULATIONS AND SIZE PIPING. REFER TO SPECIFICATIONS SECTION 21 13 13.

**100% REVIEW**  
NORTH  
SUBMITTAL


**Toland ♦ Mizell ♦ Molnar, LLC**

590 MEANS STREET NW,

SUITE 200

ATLANTA, GA, 30318

404-214-9774

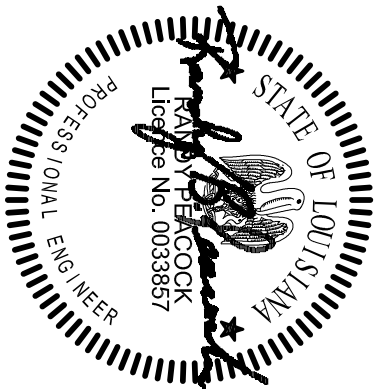

**ENLARGED FLOOR PLANS  
ELEVATOR TOWER  
FIRE PROTECTION**

Approved Project Engineer

**2ND FLOOR OUTPATIENT  
MENTAL HEALTH**

Date: 05-25-2011  
Project No. VA256-C-1047

Building Number

BLDG 1 SOUTH WING

Checked

Drawn

DRAWING NO.

FP102

Day

of

**Veterans Administration**