


Building 22
Construction Site

4150 Clement Street • San Francisco, CA 94121 • 415 221-4810

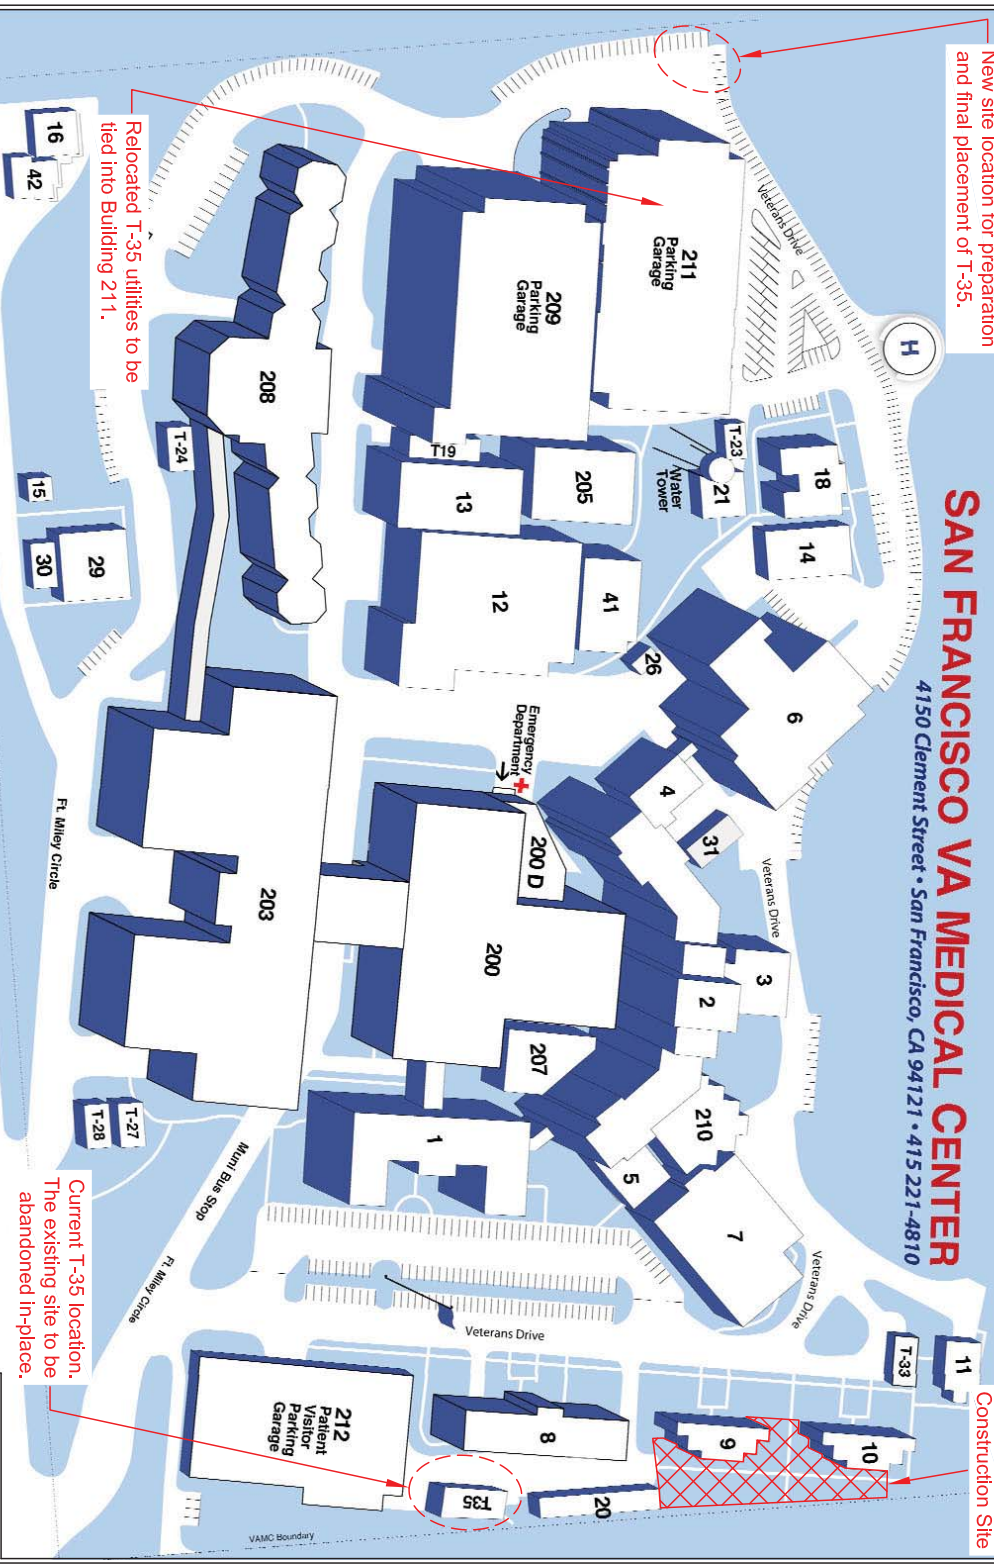

NORTH

DRAWING
A