



EXISTING T-35 TRAILER LAYOUT

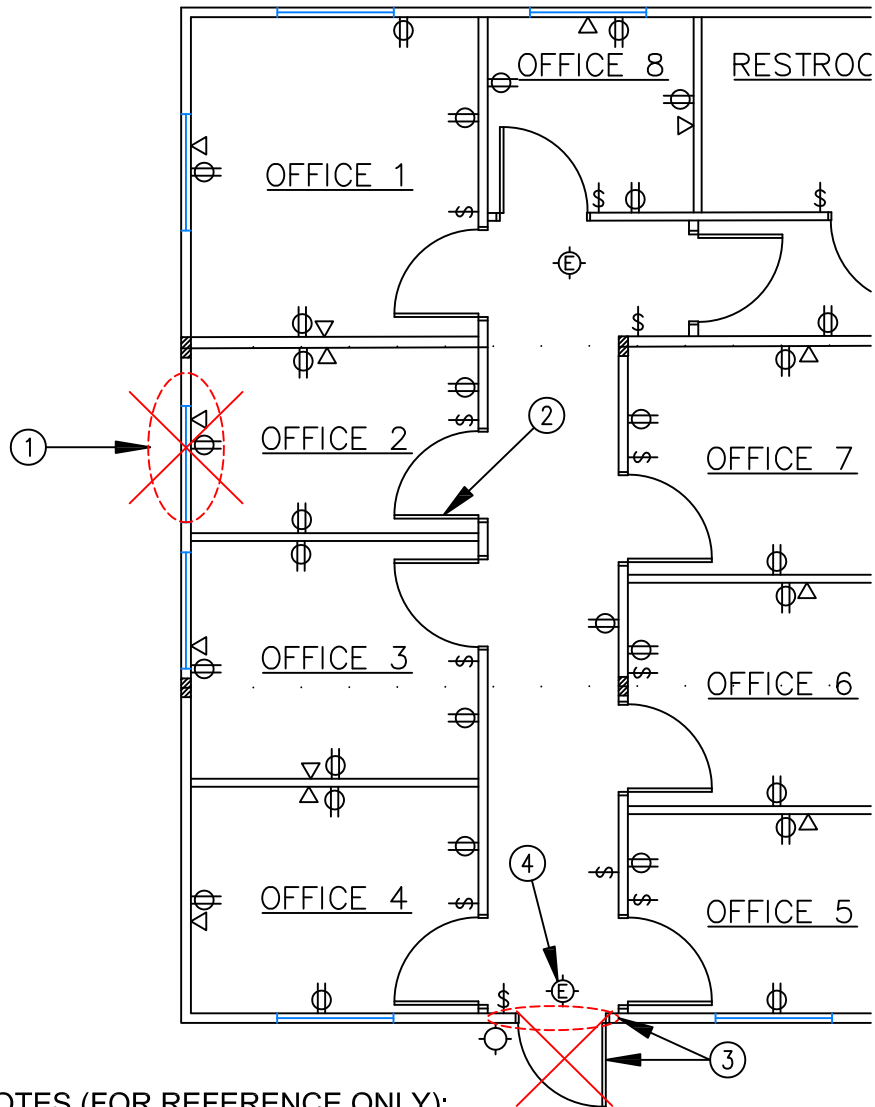

NOTES (FOR REFERENCE ONLY):

- ① DEMO EXISTING WINDOW, ELECTRICAL & DATA RECEPTACLES. SELECTIVE DEMO OF WALL FOR NEW EXTERIOR DOOR & FRAME.
- ② REMOVE & DISPOSE OF EXISTING INTERIOR DOOR AND HINGES. EXISTING DOOR FRAME TO REMAIN, PROTECTED IN-PLACE AND REPAINTED TO MATCH EXISTING.
- ③ DEMO EXISTING EXTERIOR DOOR & FRAME, EXTERIOR DOOR TRIM, WEATHER STRIPPING, THRESHOLD & ELECTRICAL FOR AUTOMATIC DOOR OPENER. SELECTIVE DEMO OF INTERIOR & EXTERIOR WALLS.
- ④ REMOVE & RELOCATE (R) EXISTING CEILING MOUNTED EXIT SIGN.
- ⑤ INSTALL NEW (N) COMBINATION EXIT SIGN & FLOOD LIGHTS WITH BACKUP BATTERY.
- ⑥ INSTALL NEW (N) EXTERIOR PORCH LIGHT & NEW (N) INTERIOR SINGLE POLE LIGHT SWITCH.

NEW T-35 TRAILER LAYOUT

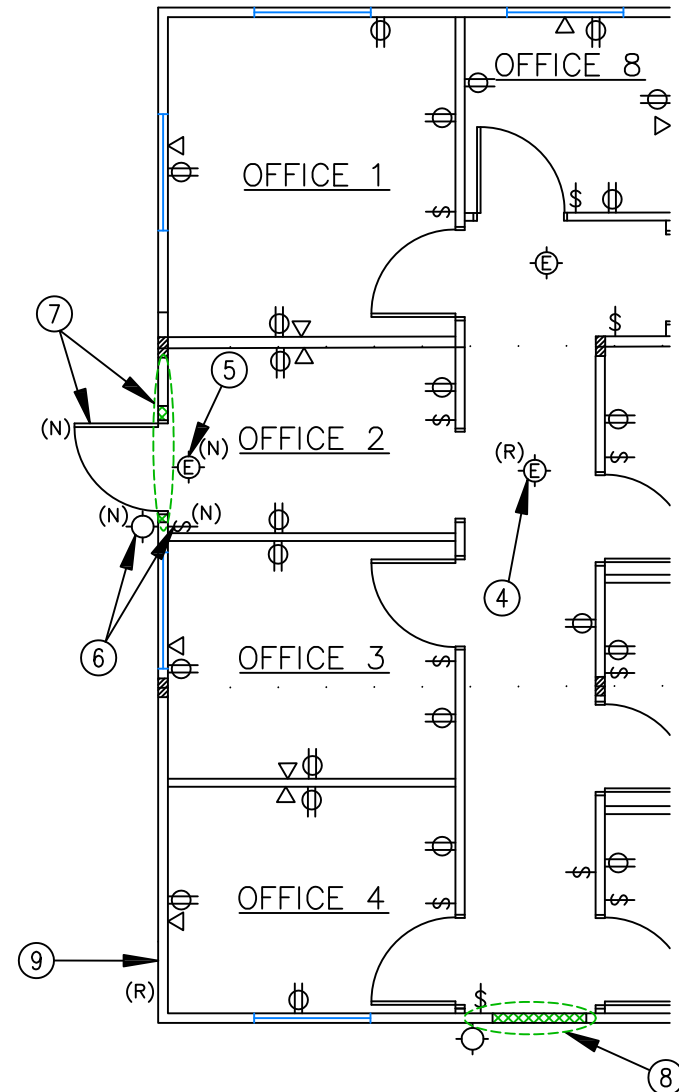

- ⑦ INSTALL NEW (N) EXTERIOR DOOR, FRAME, HARDWARE & ACCESSORIES, NEW FRAMING, VAPOR BARRIER, INSULATION, EXTERIOR & INTERIOR WALLS. PATCH & PAINT TO MATCH EXISTING.
- ⑧ INSTALL NEW FRAMING, VAPOR BARRIER, INSULATION, INTERIOR & EXTERIOR WALLS. PATCH, REPAIR & PAINT TO MATCH EXISTING.
- ⑨ REMOVE & RELOCATE (R) EXISTING "T-35" EXTERIOR BUILDING NAME SIGN. PATCH & RE-PAINT EXTERIOR AS NEEDED TO MATCH EXISTING.

662-16-012 Relocate T-35 Trailer
T-35 Trailer Interior and Exterior
Layout Modification

NOT TO SCALE

**DRAWING
C**

San Francisco VA Medical Center - 4150 Clement St, San Francisco CA 94121