



three inches = one foot  
one and one half inches = one foot  
one inch = one foot  
three eighths inch = one foot  
one quarter inch = one foot  
one eighth inch = one foot


6/10/2016 3:15:57 PM HILLIARD ARCHITECTS INC. COPYRIGHT

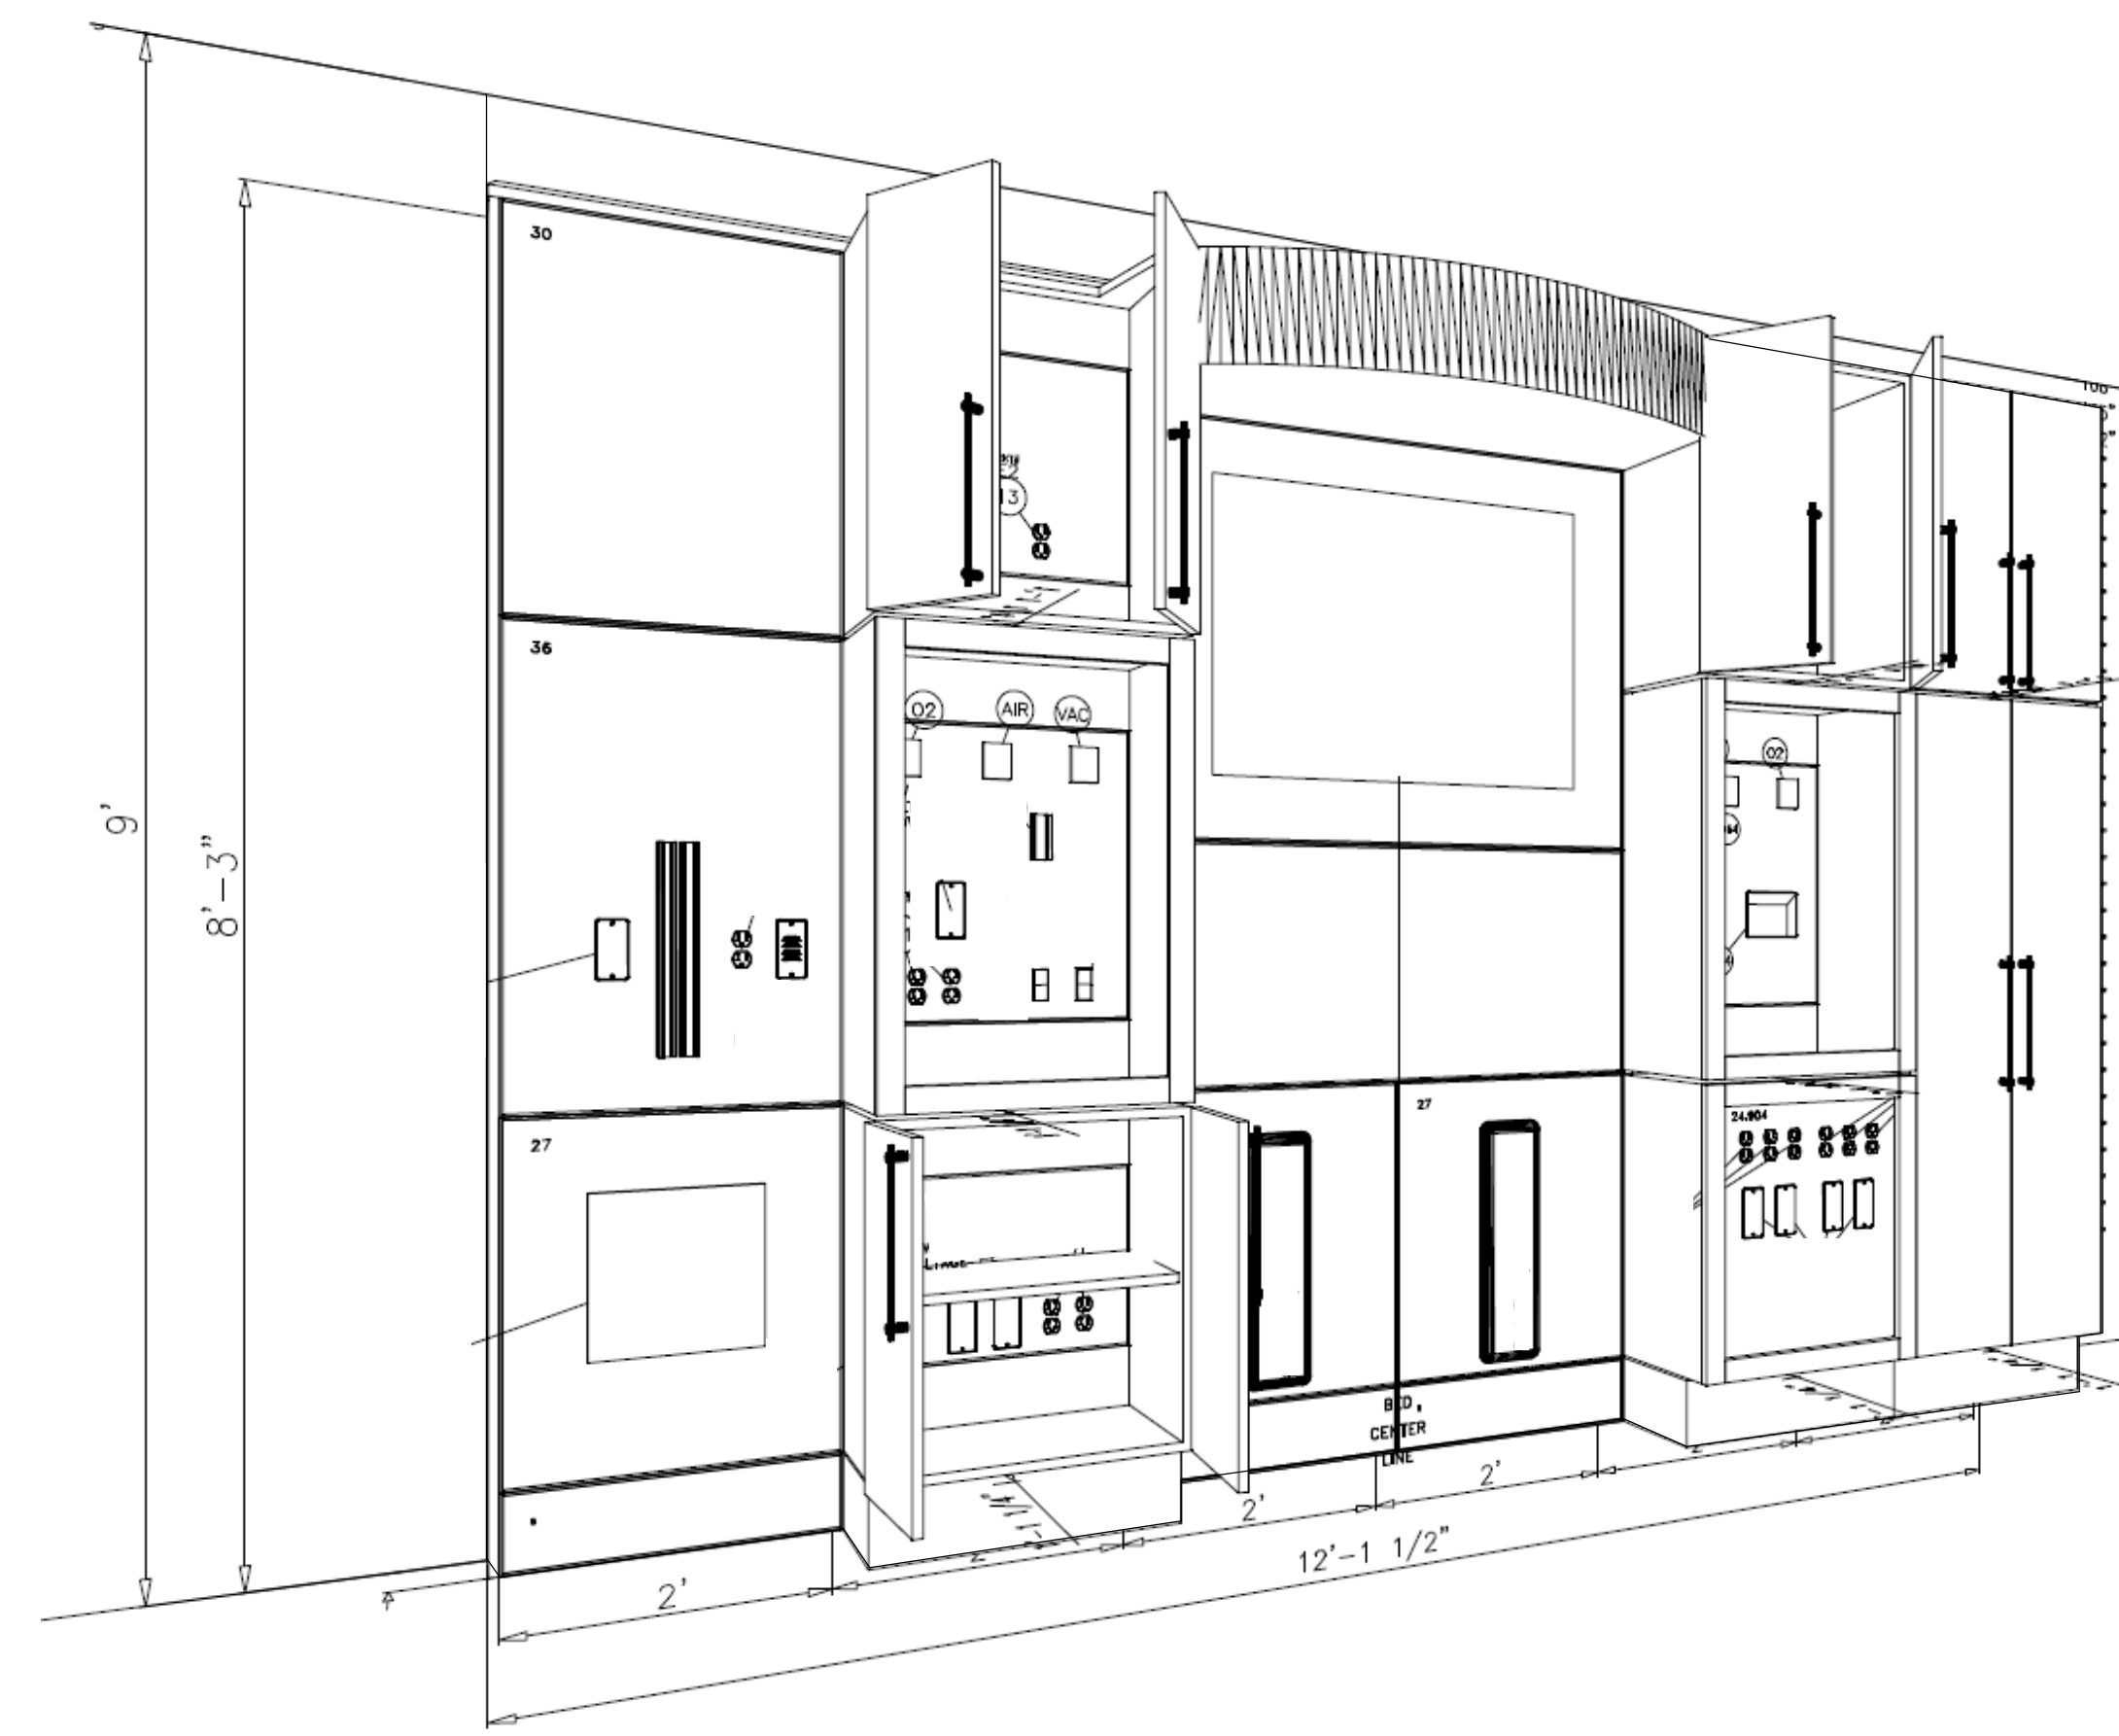


22 HEADWALL PERSPECTIVE  
N.T.S.

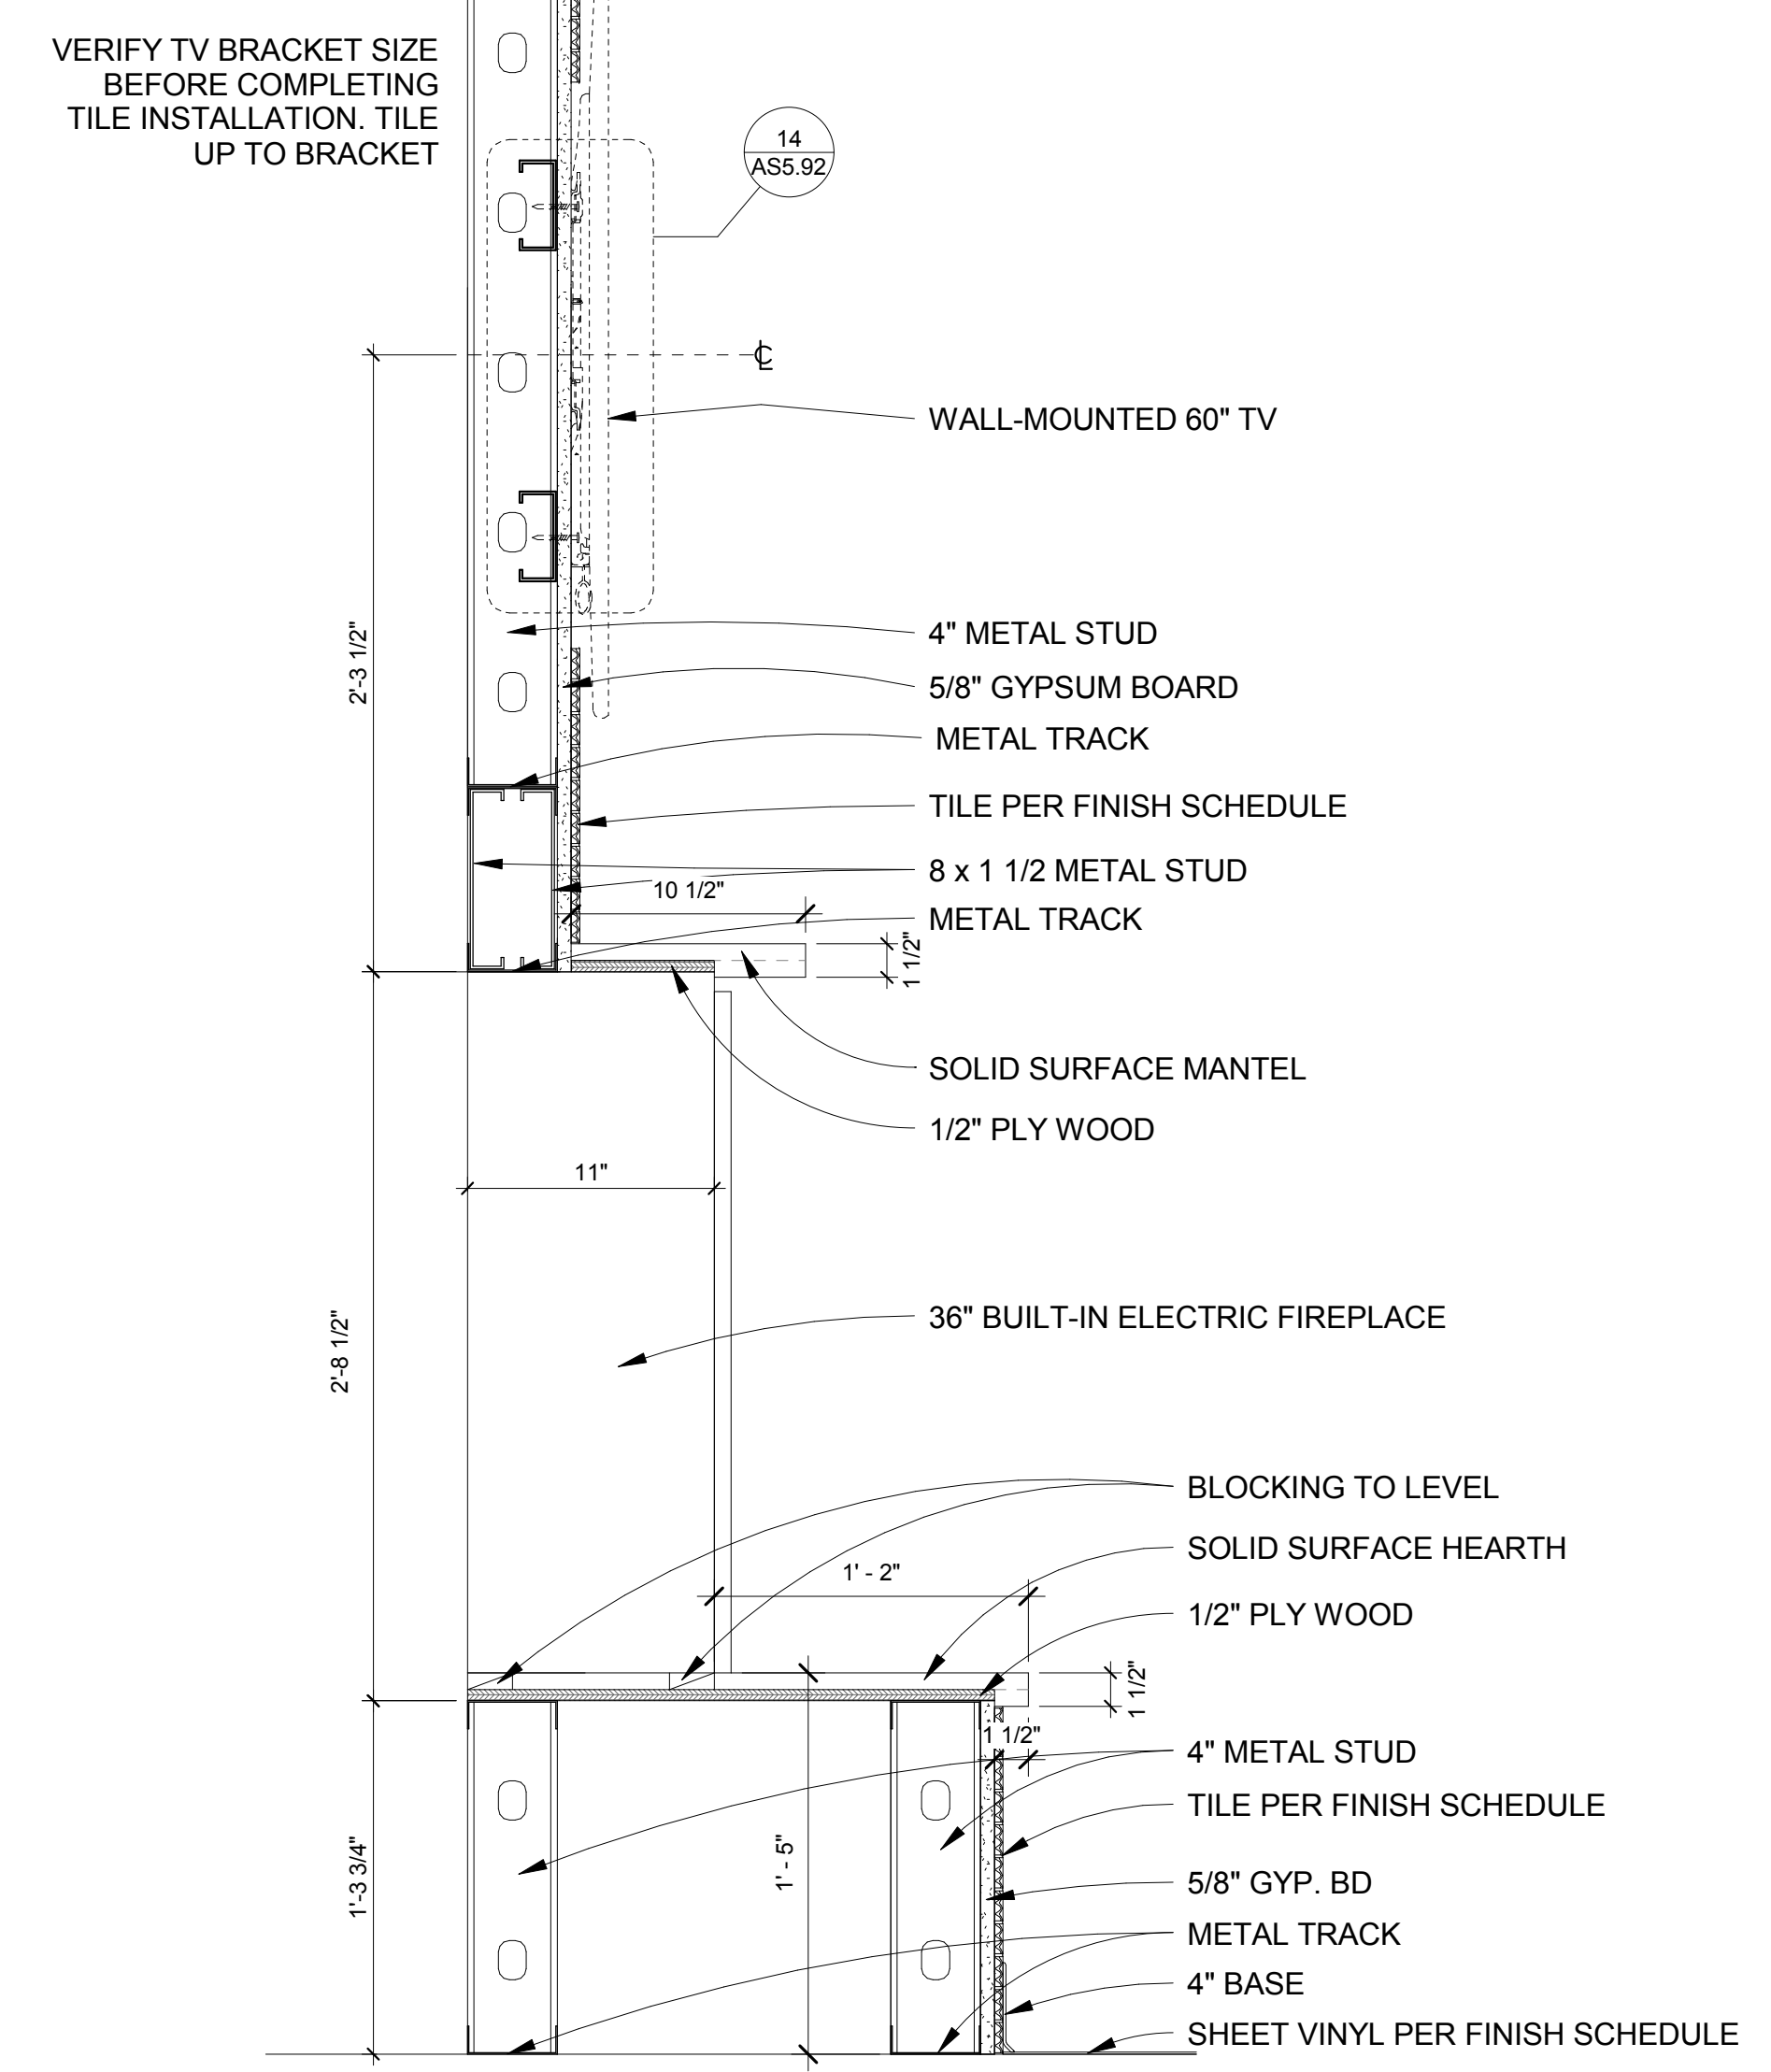


27 FIREPLACE SECTION

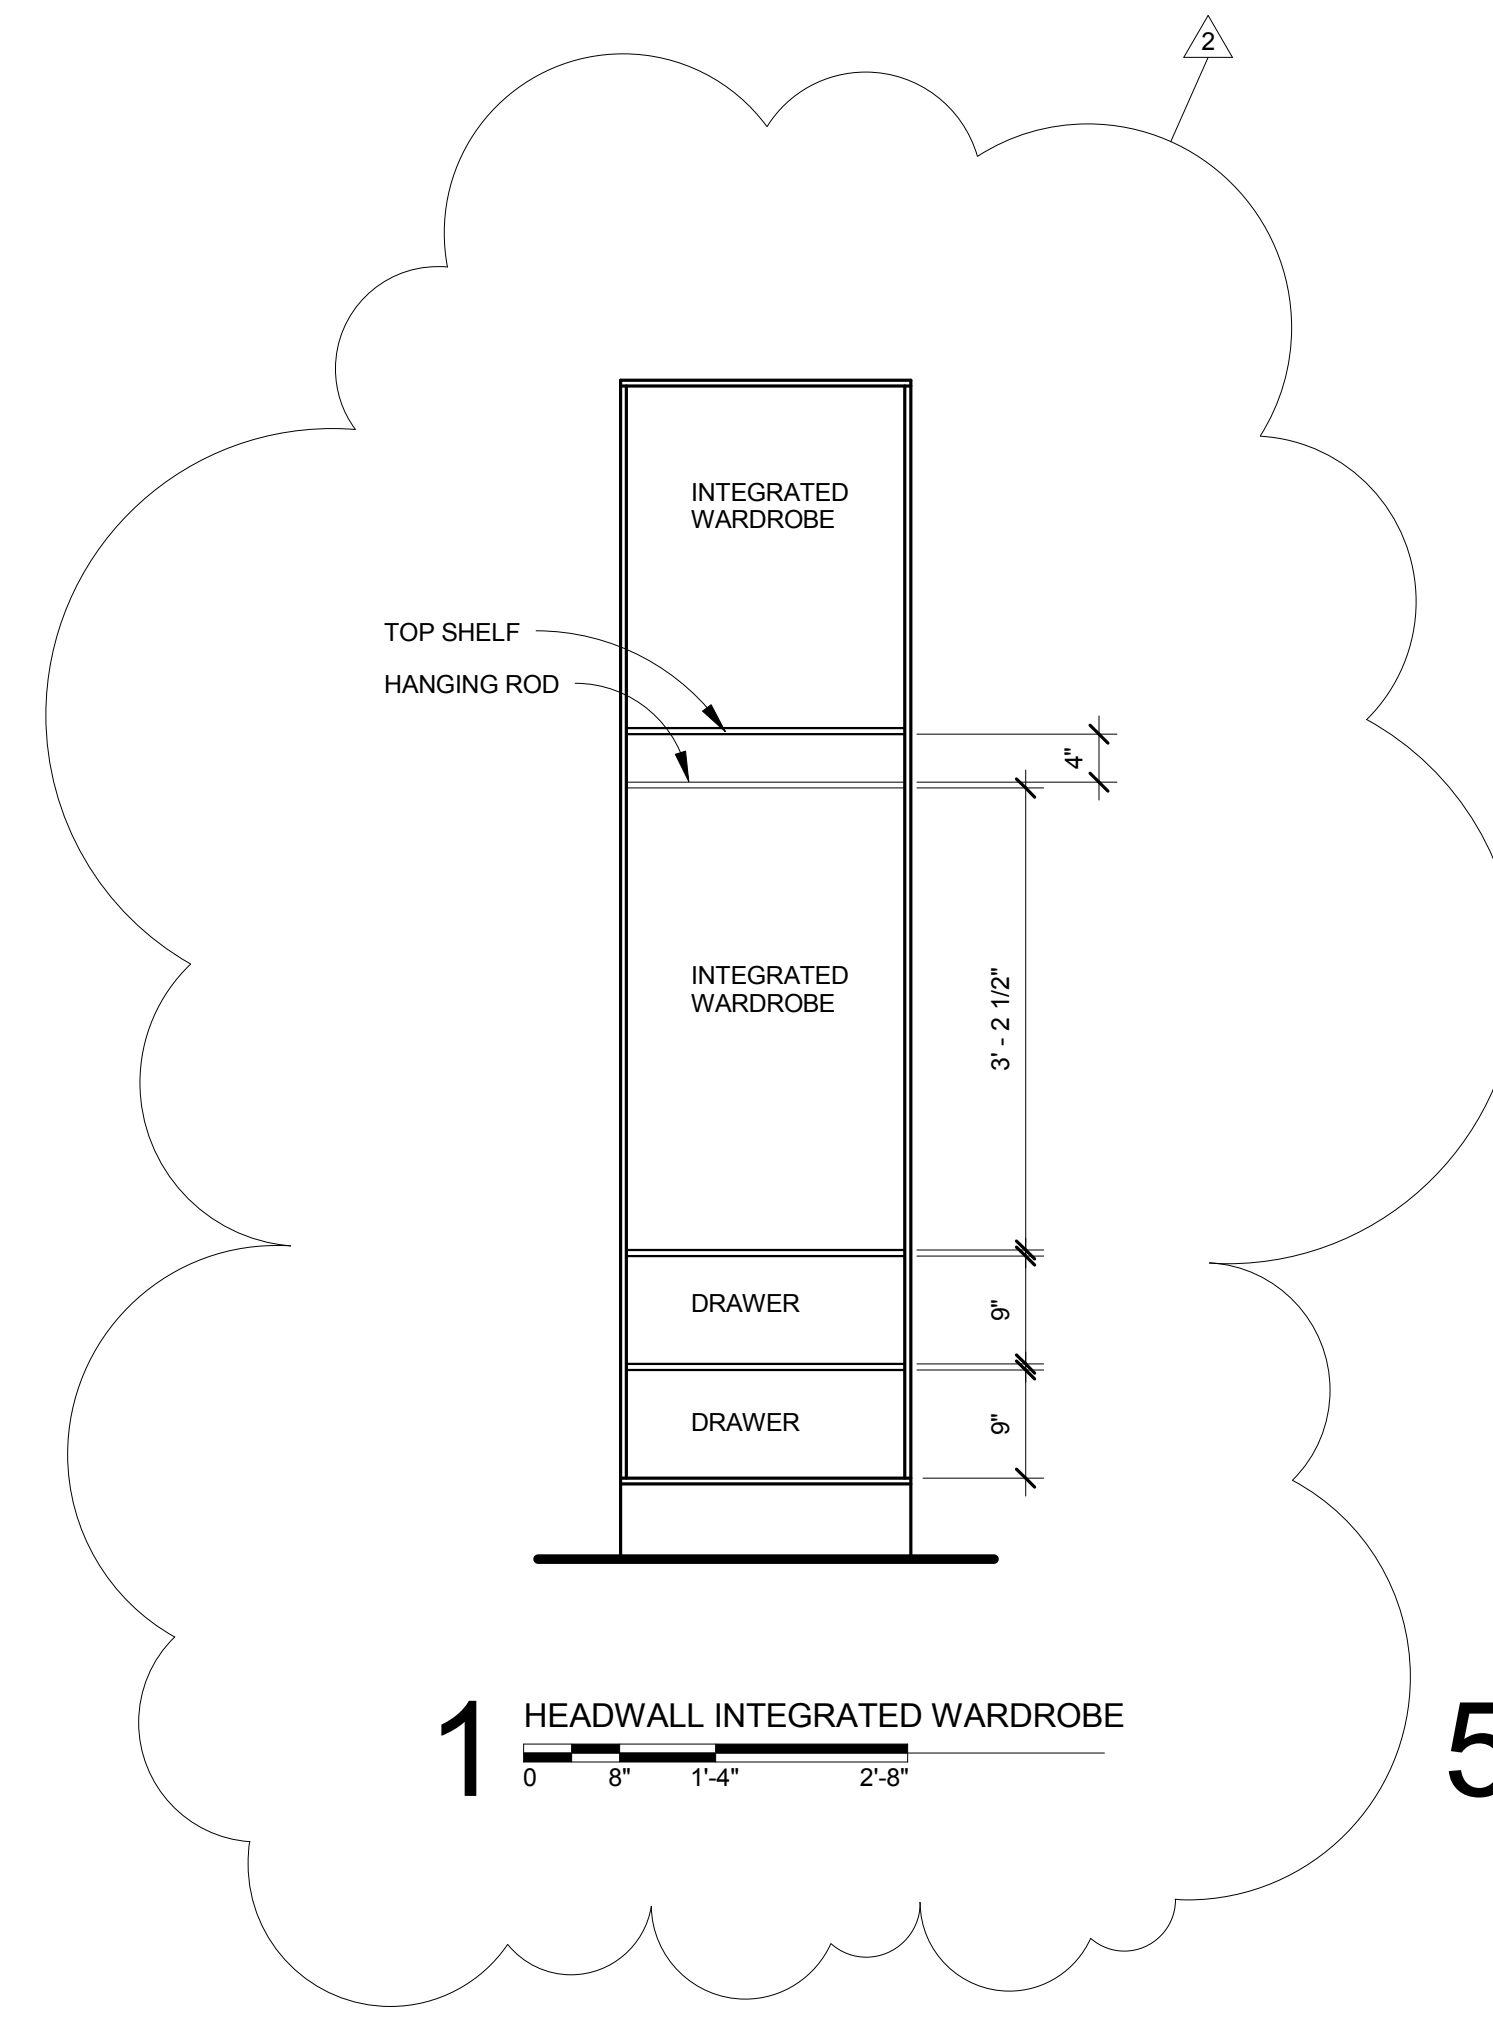

1 HEADWALL INTEGRATED WARDROBE

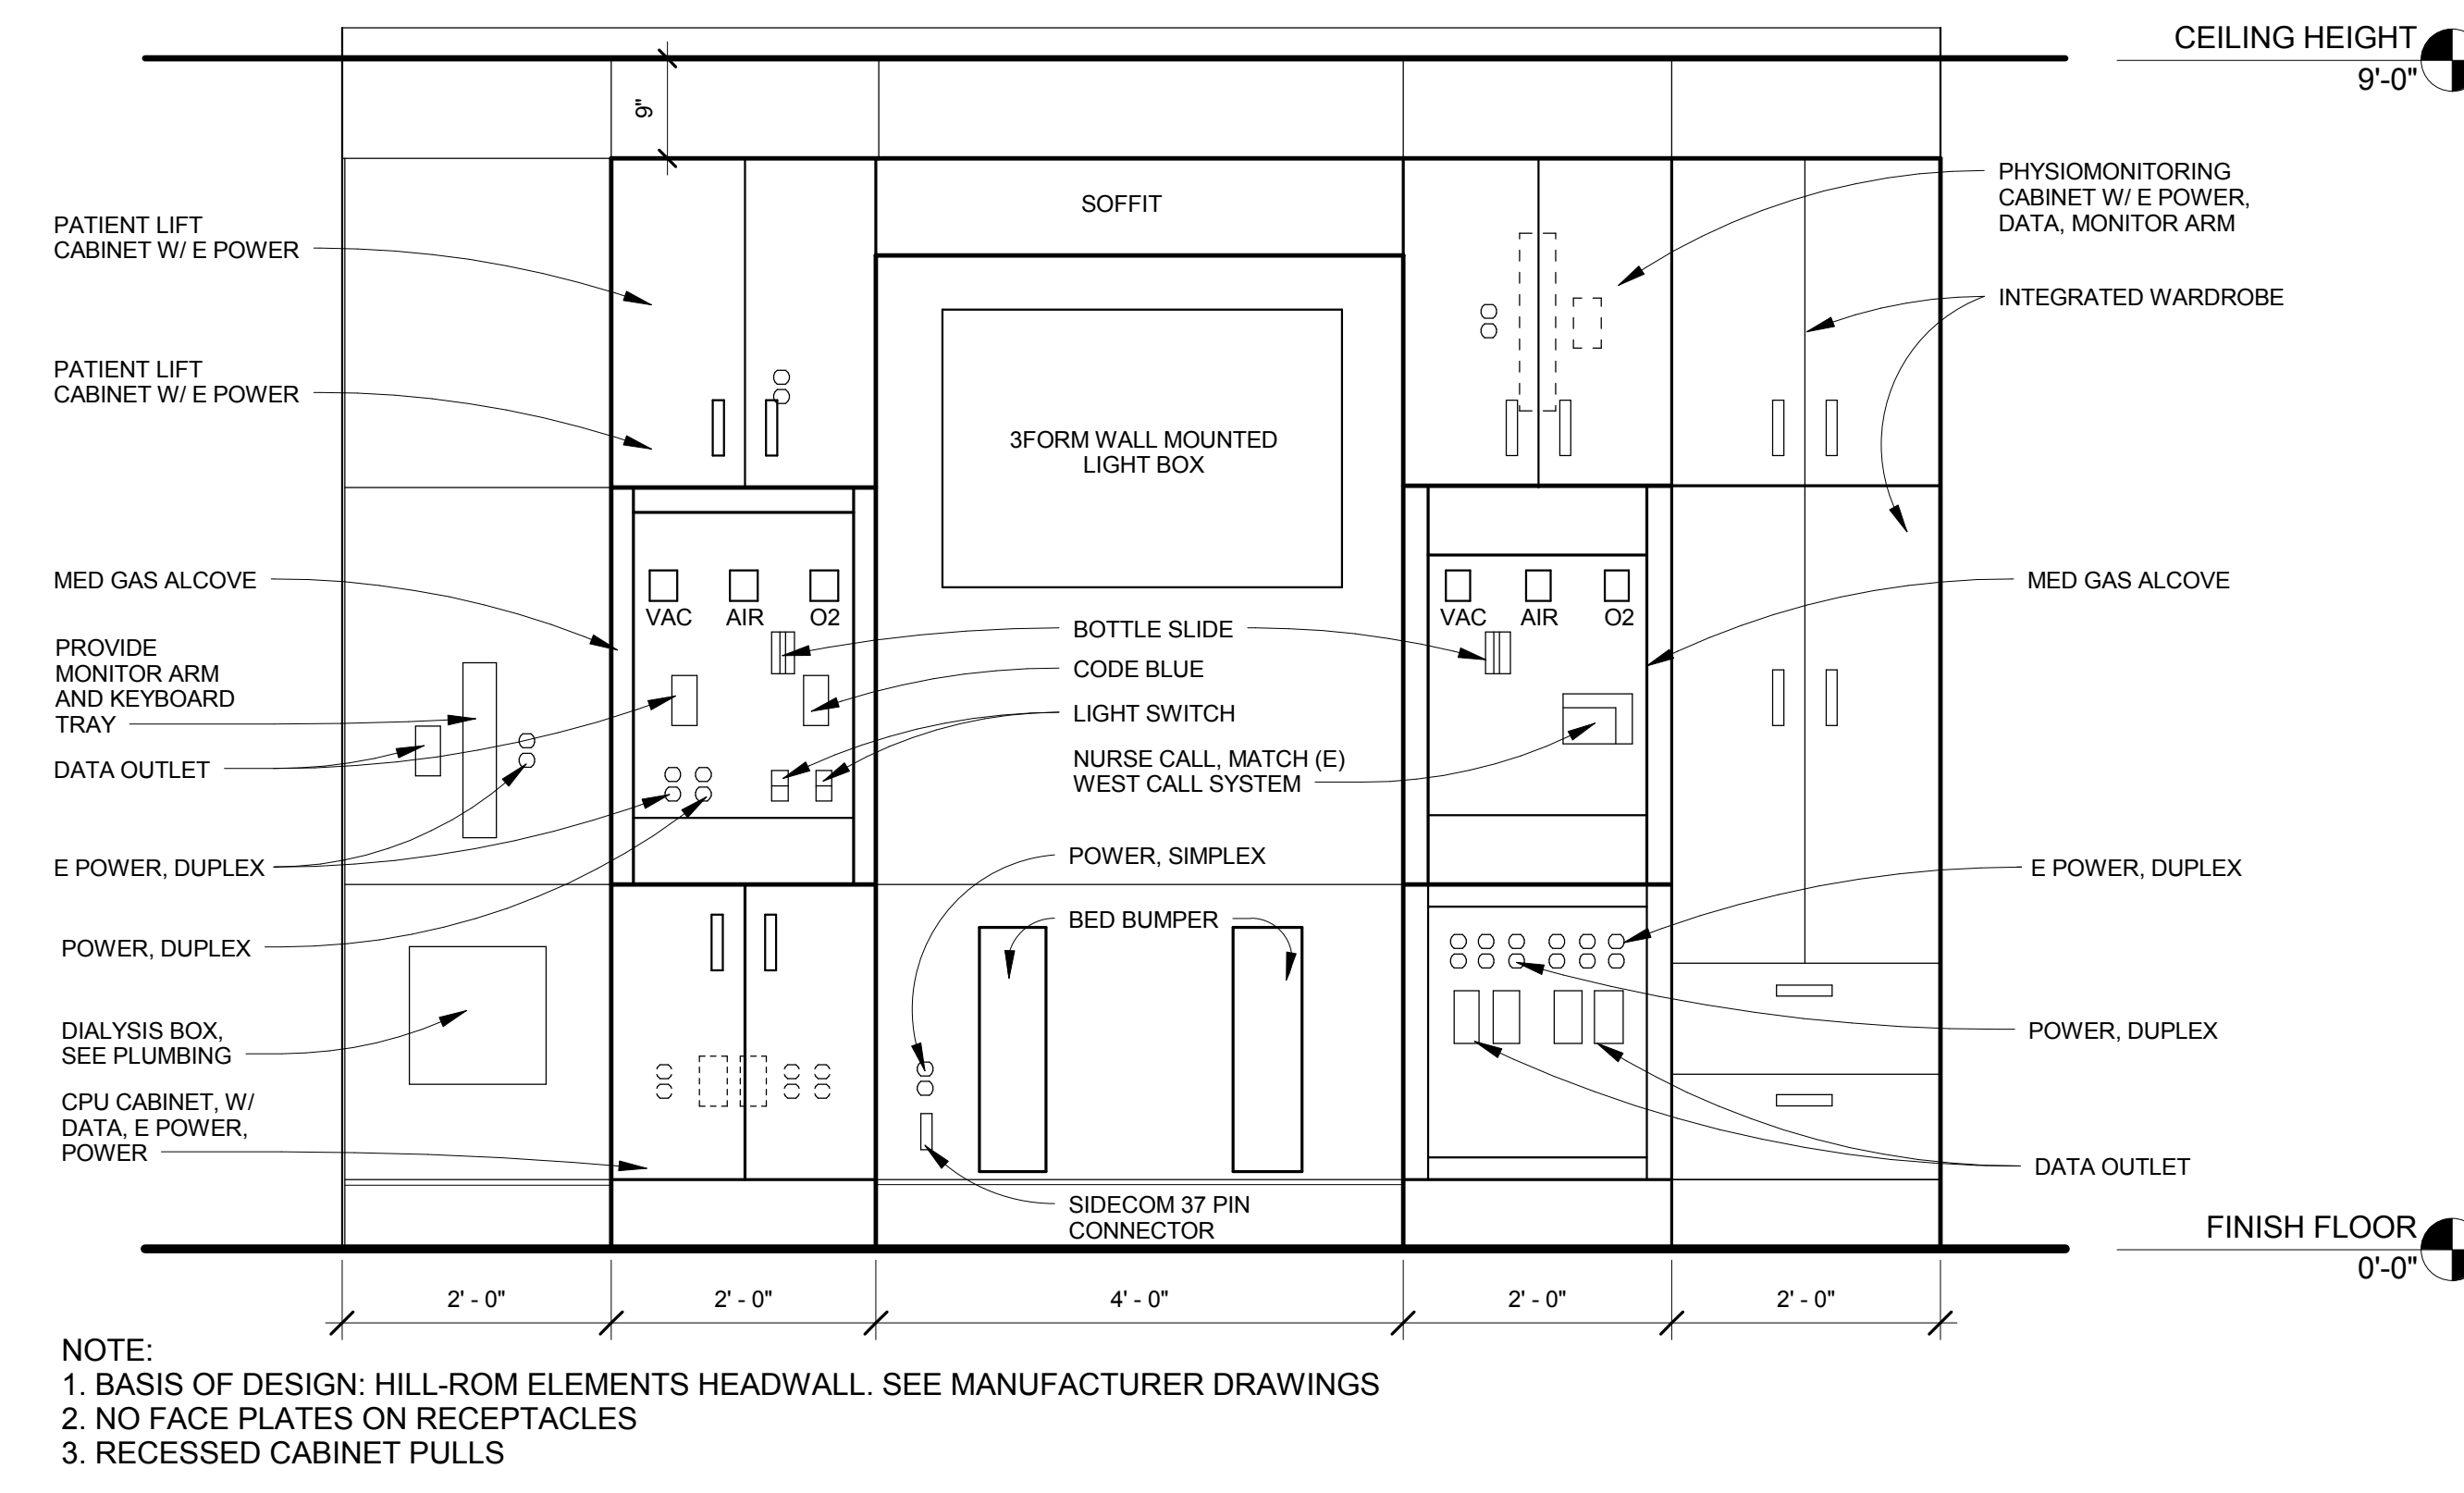

52 HEADWALL ELEVATION

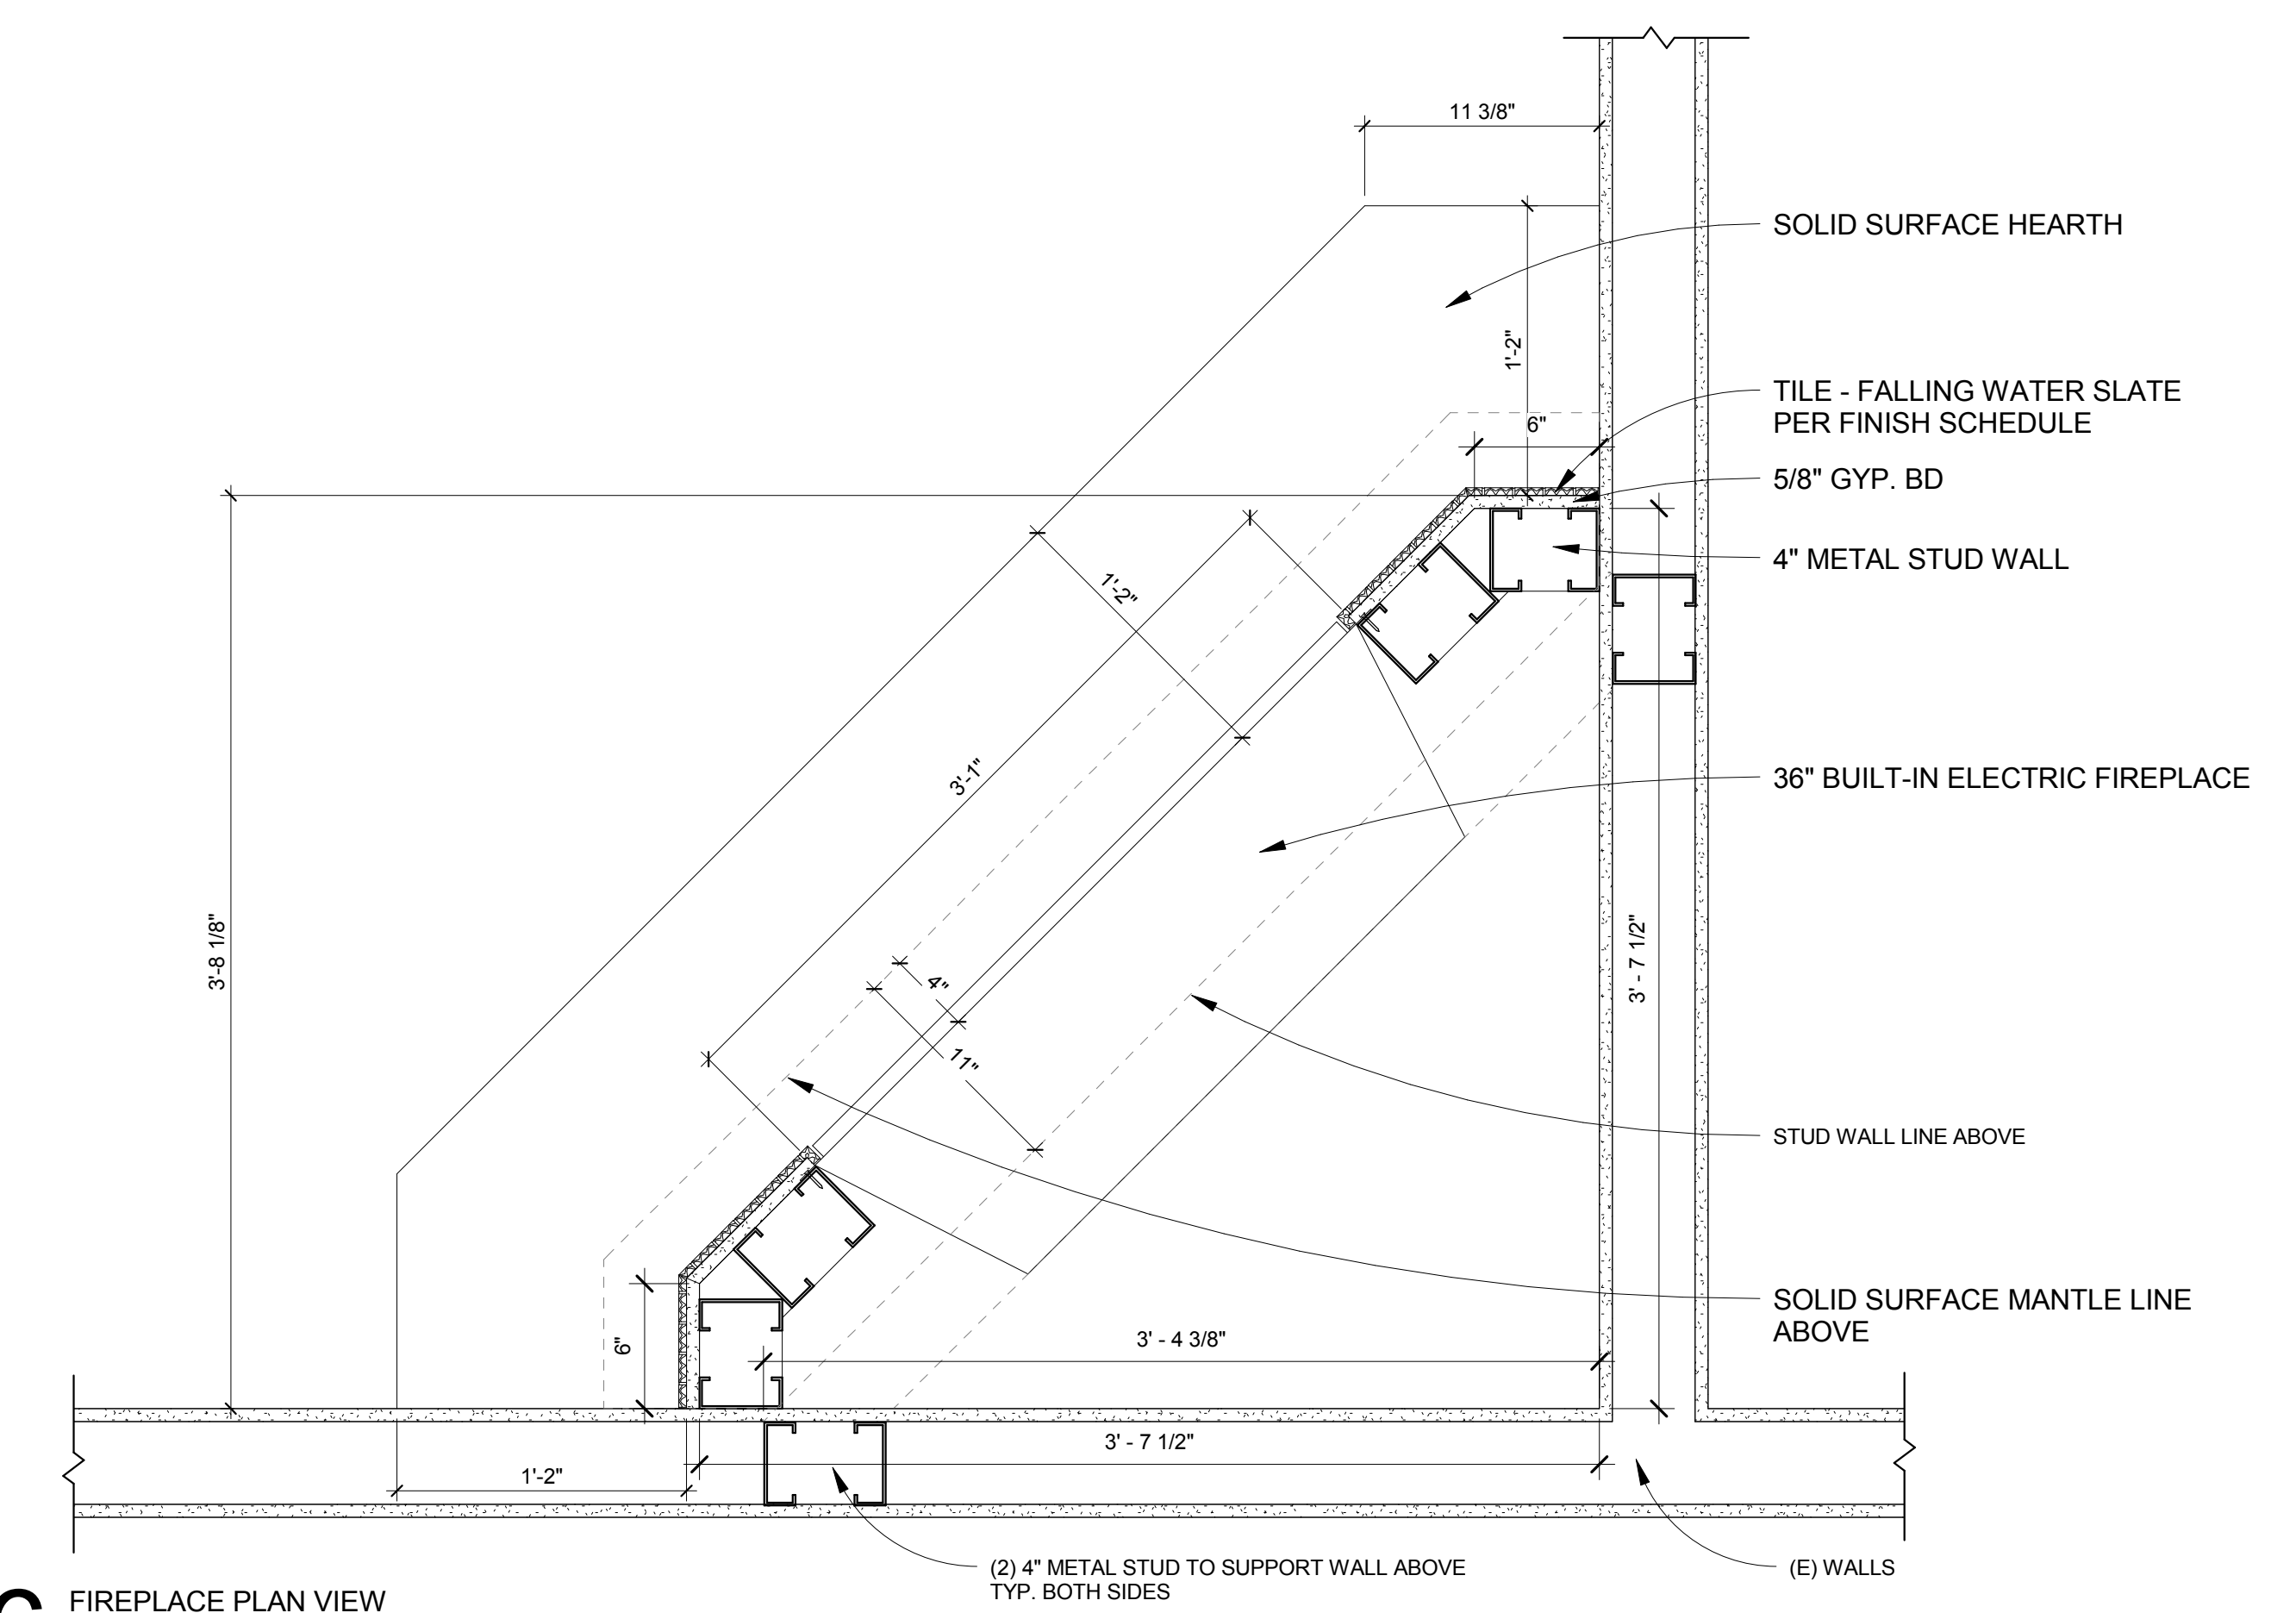

56 FIREPLACE PLAN VIEW

FINAL BID DOCUMENTS

<b>Revision 2</b> Revisions: Date: 06.03.2016		<b>CONSULTANTS:</b>				<b>ARCHITECT/ENGINEERS:</b>  1330 Broadway, Suite 1111 Oakland, CA 94612-5017 Tel 415 989 6400, Fax 415 989 3056 www.HilliardArchitects.com		<b>MISC. INTERIOR DETAILS</b> Approved: Project Director		<b>Project Title</b> BUILDING 700 4 FLOOR RENOVATION		<b>Project Number</b> 612A4-12-212 <b>Building Number</b> 700		<b>Office of Construction and Facilities Management</b> 	
				<b>KEY PLAN</b>				<b>Location</b> VA MATHER		<b>Drawing Number</b> AS5.93		<b>Dwg. 41 of 105</b>			