NORTH

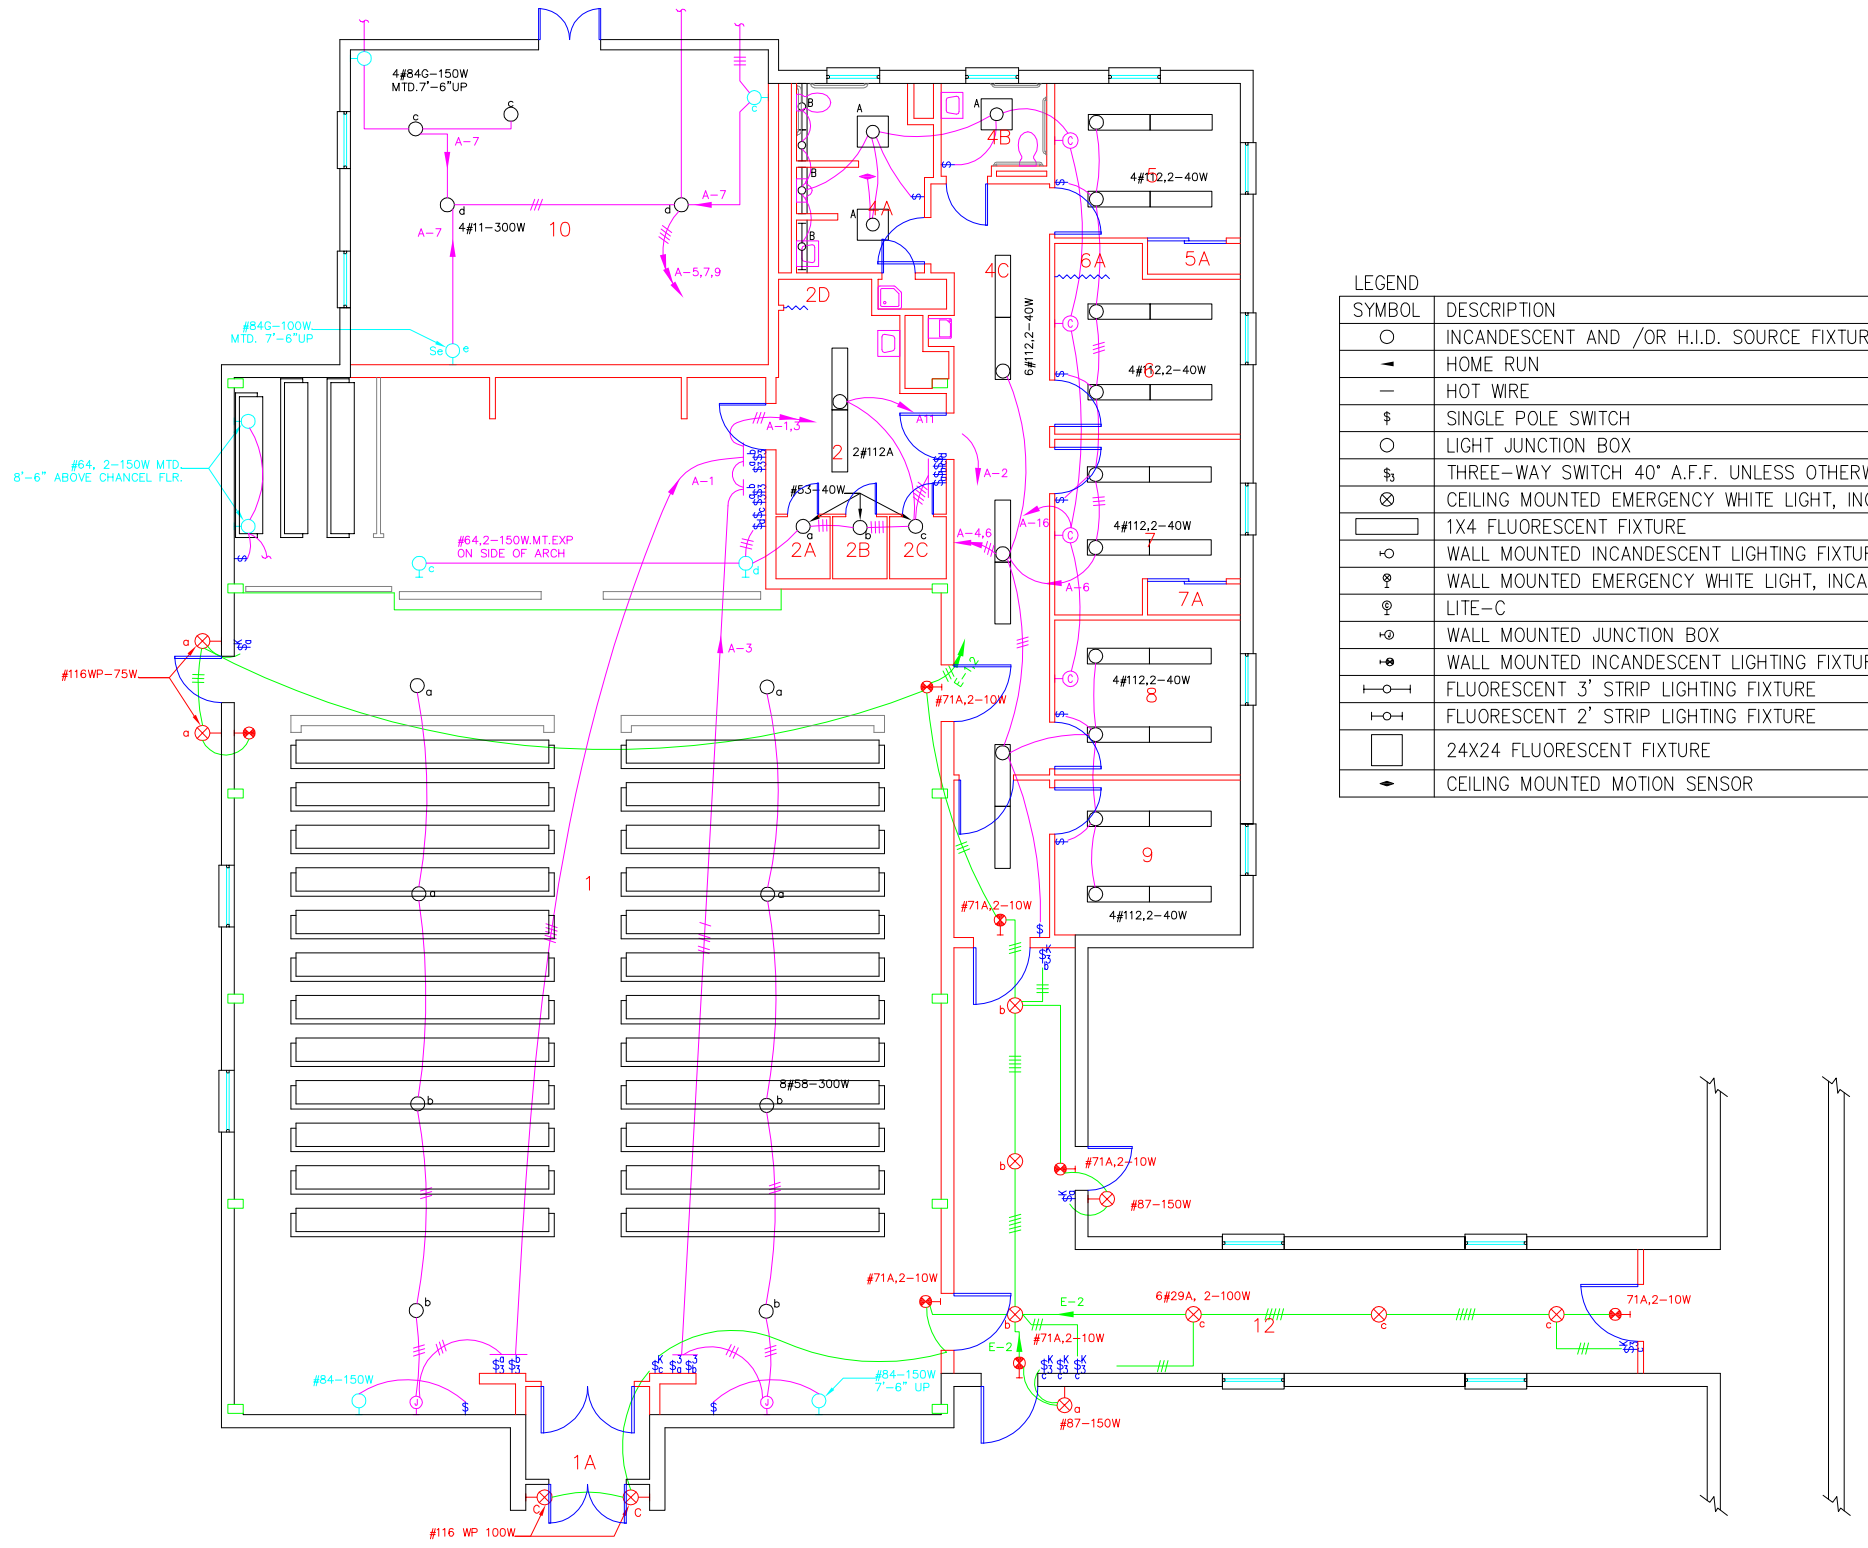

LEGEND

SYMBOL	DESCRIPTION
○	INCANDESCENT AND /OR H.I.D. SOURCE FIXTURE
→	HOME RUN
—	HOT WIRE
$	SINGLE POLE SWITCH
○	LIGHT JUNCTION BOX
$3	THREE-WAY SWITCH 40" A.F.F. UNLESS OTHERWISE NOTED
⊗	CEILING MOUNTED EMERGENCY WHITE LIGHT, INCANDESCENT
▭	1X4 FLUORESCENT FIXTURE
⊸○	WALL MOUNTED INCANDESCENT LIGHTING FIXTURE
⊸⊗	WALL MOUNTED EMERGENCY WHITE LIGHT, INCANDESCENT
⊸C	LITE-C
⊸②	WALL MOUNTED JUNCTION BOX
⊸⊜	WALL MOUNTED INCANDESCENT LIGHTING FIXTURE (DOUBLE FACE)
⊢○⊣	FLUORESCENT 3' STRIP LIGHTING FIXTURE
⊢○⊣	FLUORESCENT 2' STRIP LIGHTING FIXTURE
□	24X24 FLUORESCENT FIXTURE
◂▸	CEILING MOUNTED MOTION SENSOR

Revisions | Date

Professional Seal

Indus Systems, Inc.
2352, Main Street, Concord MA 01742
Tel: 978-461-0555
www.indus-systems.com

Drawing Title: FIRST FLOOR LIGHTING

Project Title: AS-BUILT Drawings

Date: 04-19-2012

Project No.

Drawing No.

Approved:

Approved:

Building Number: 106

Checked

Drawn

Location: VAMC, LEBANON PA.

VAMC, LEBANON

Department of Veterans Affairs

VA