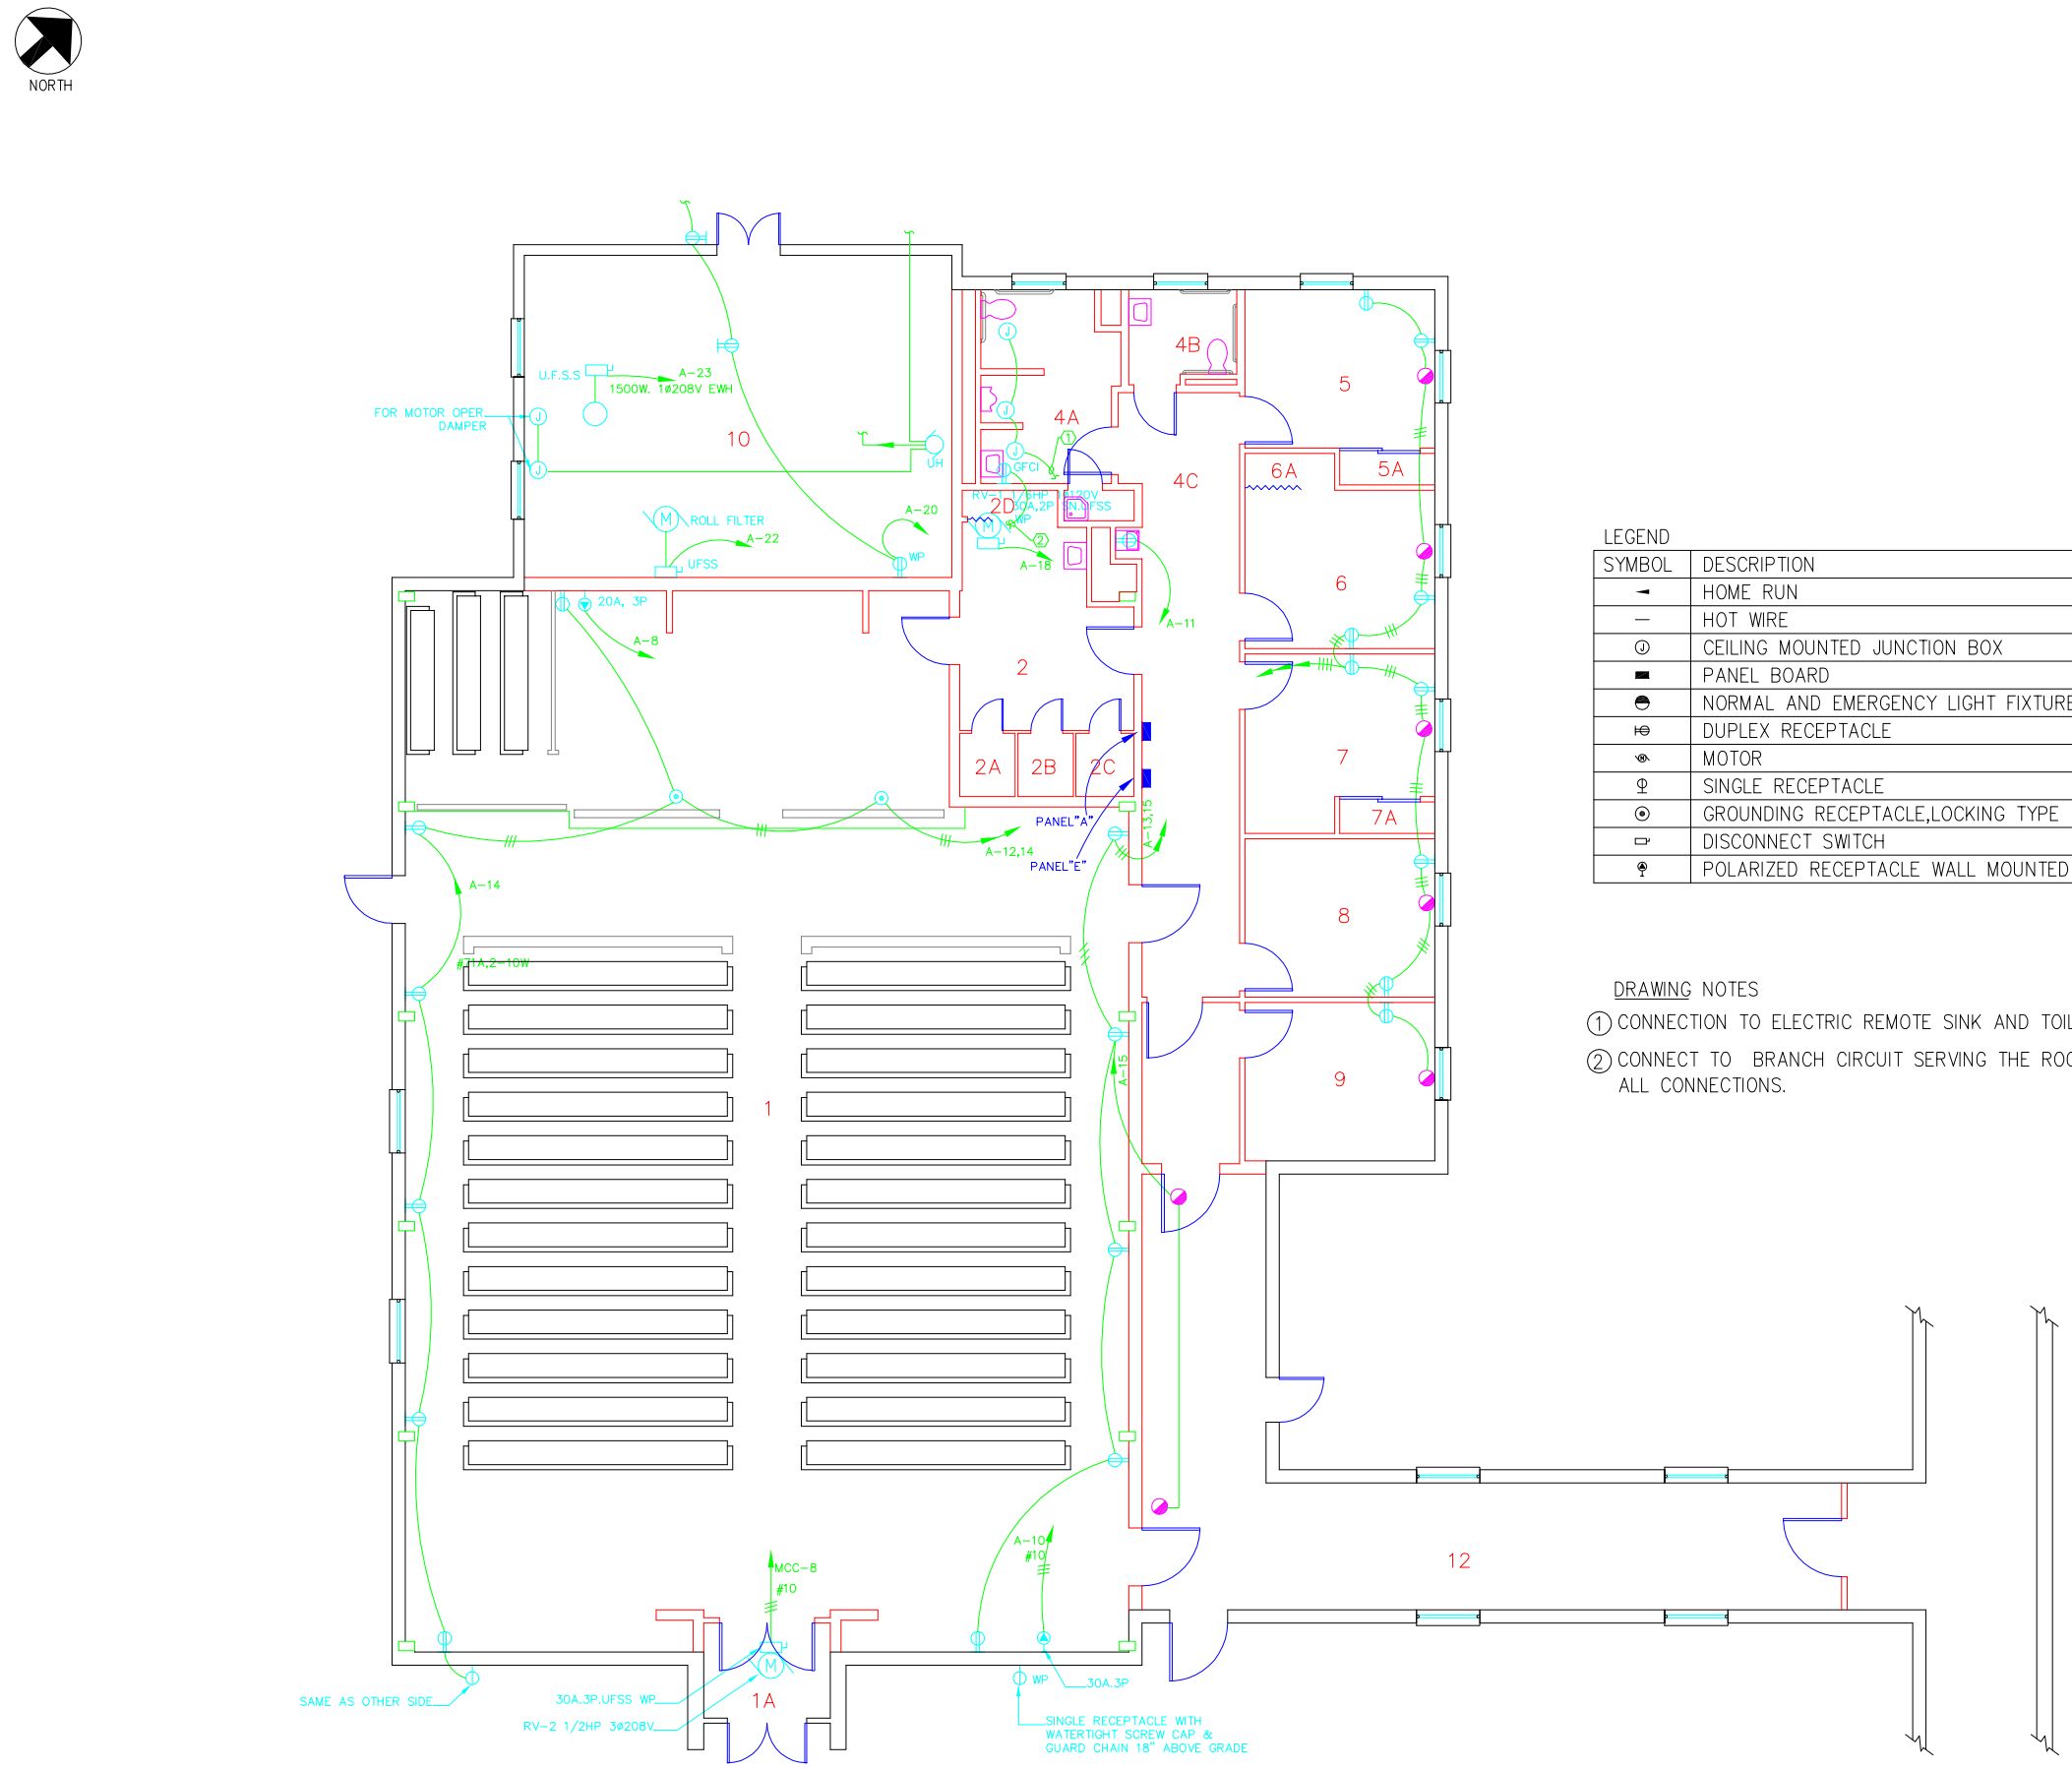

LEGEND

SYMBOL	DESCRIPTION
	HOME RUN
	HOT WIRE
	CEILING MOUNTED JUNCTION BOX
	PANEL BOARD
	NORMAL AND EMERGENCY LIGHT FIXTURE
	DUPLEX RECEPTACLE
	MOTOR
	SINGLE RECEPTACLE
	GROUNDING RECEPTACLE,LOCKING TYPE
	DISCONNECT SWITCH
	POLARIZED RECEPTACLE WALL MOUNTED

DRAWING NOTES

1. CONNECTION TO ELECTRIC REMOTE SINK AND TOILET.
2. CONNECT TO BRANCH CIRCUIT SERVING THE ROOM AND PROVIDE ALL CONNECTIONS.

Revisions | Date

Professional Seal

Indus Systems, Inc.
2352, Main Street, Concord MA 01742
Tel: 978-461-0555
www.indus-systems.com

Drawing Title: FIRST FLOOR POWER

Project Title: AS-BUILT Drawings

Date: 04-19-2012

Project No.

Approved:

Building Number: 106

Checked | Drawn

Drawing No.

Approved:

Location: VAMC, LEBANON PA.

VAMC, LEBANON

VA Department of Veterans Affairs