SEE SHEET B-1.04
MATCH LINE E

SEE SHEET B-1.06
MATCH LINE F

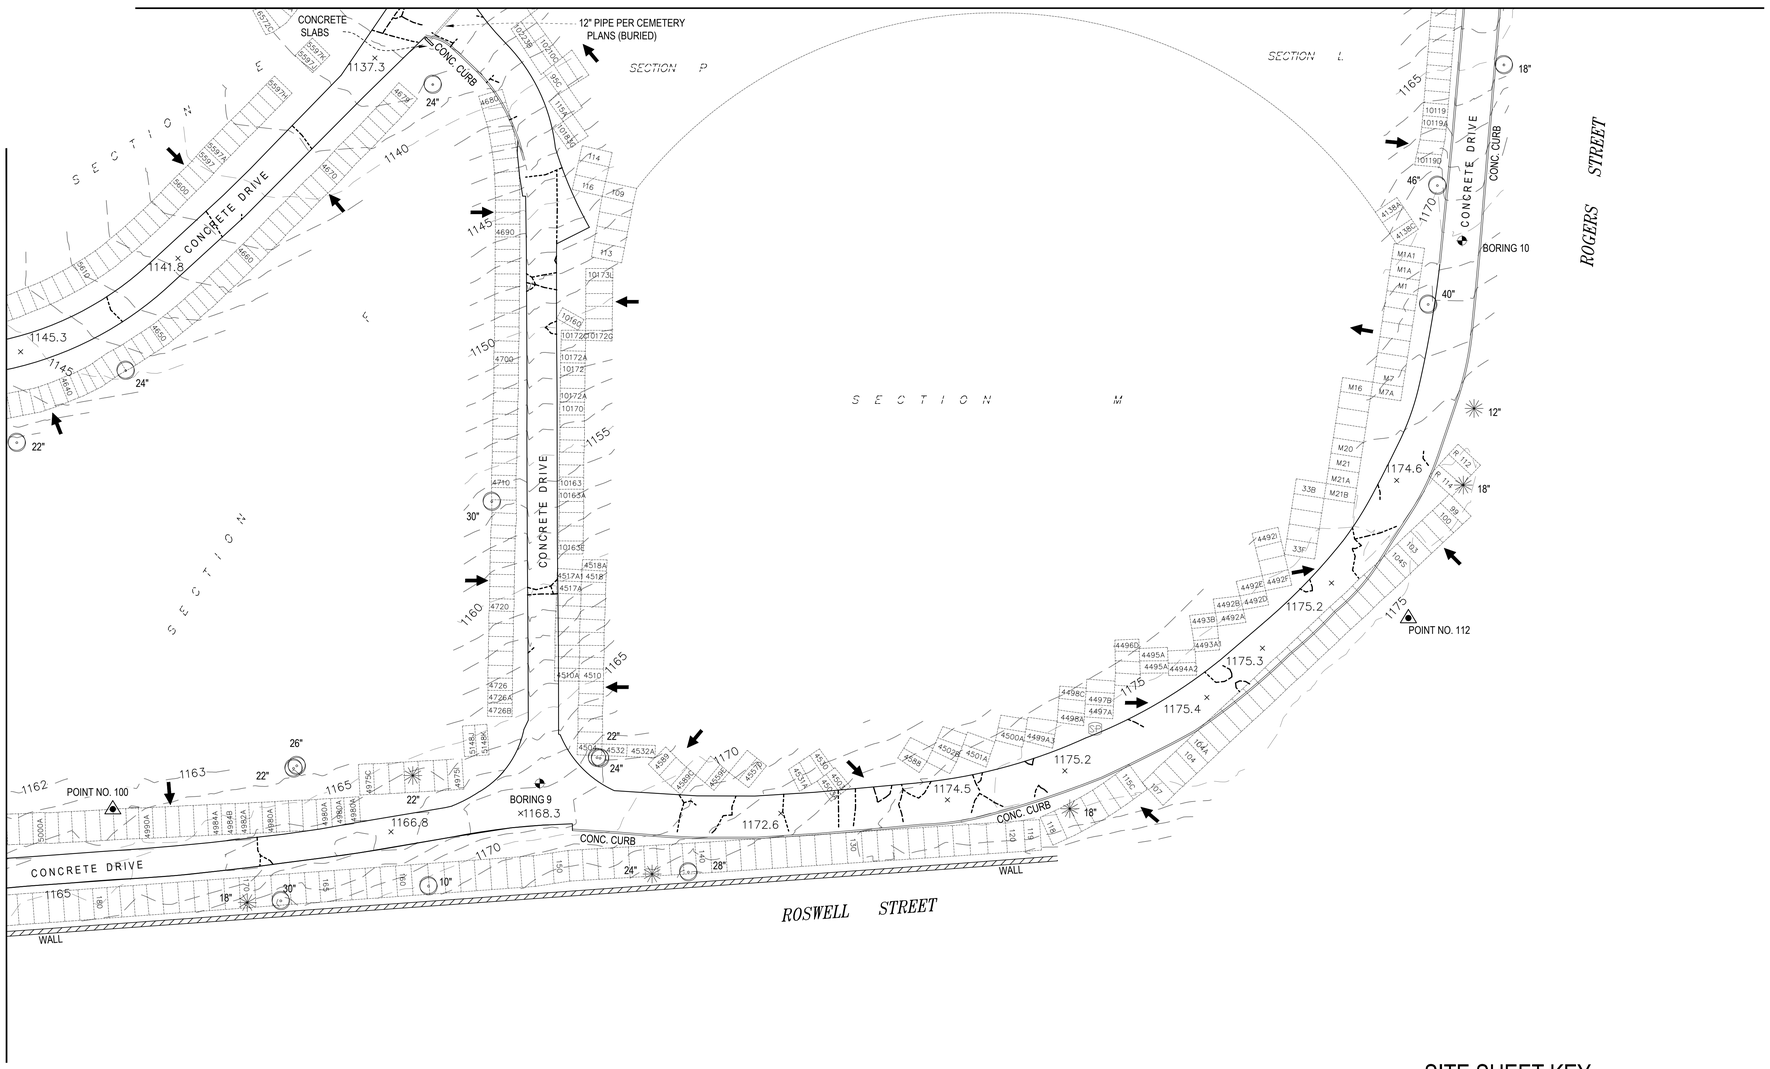

CONTROL SCHEDULE				
POINT NO.	NORTHING	EASTING	ELEVATION	POINT NAME
100	1437270.95	2183438.88	1163.99	B-17
101	1437277.99	2182947.40	1168.94	B-10
102	1437600.91	2182920.50	1189.32	1397
105	1437761.48	2183168.98	1167.00	I-13
106	1437548.98	2183510.30	1136.52	F-18
107	1437760.33	2183650.47	1124.91	I-20
110	1437543.80	2183861.13	1160.61	F-23
112	1437333.26	2183861.34	1174.68	C-23
115	1437275.16	2183229.20	1158.70	B-14
117	1437640.08	2182505.40	1148.83	G-3
119	1437770.08	2182330.24	1129.77	I-1
126	1437521.79	2182363.90	1128.13	F-1
129	1437428.60	2182523.54	1152.78	D-4

LEGEND

- BORING
- CULVERT
- CLEAN OUT
- CATCH BASIN
- CONTROL POINT
- FLAG POLE
- TRASH BIN
- GUARD POST
- HYDRANT
- IRRIGATION CONTROL BOX
- LIGHT POLE
- MANHOLE
- POWER POLE
- SIGN
- SPRINKLER HEAD
- WATER VALVE
- ROOF DRAIN
- CONIFEROUS TREE
- DECIDUOUS TREE
- DIRECTION OF GRAVESTONE FACE
- POWER POLE ANCHOR
- FENCE
- GAS MAIN
- OVERHEAD WIRES
- PAVEMENT CRACK
- STORM SEWER
- STORM SEWER PER PLANS
- EXPANSION JOINT
- UNDERGROUND ELECTRIC
- WATER MAIN
- SANITARY SEWER

SITE SHEET KEY

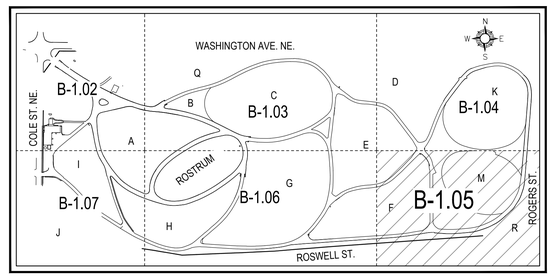

SCALE 0 20 40 60 IN FEET

ASBUILT DRAWINGS - SEPTEMBER 10, 2015

ASBUILT DRAWINGS	9–10–15
Revisions:	Date

CONSULTANTS:

Terracon
2855 Premiere Pkwy, Ste. C
Duluth, GA 30097
(770) 623-0755 tel (770) 623-9628 fax
www.terracon.com

Advanced Structural Technologies
5001 American Blvd. W., Suite 800
Bloomington, MN 55437
(952) 854-9302 tel
(952) 854-9690 fax
www.astmn.com

ARCHITECT/ENGINEERS:

ANDERSON ENGINEERING
ENGINEERING • ARCHITECTURE • LAND SURVEYING • ENVIRONMENTAL SERVICES • LANDSCAPE ARCHITECTURE

Anderson Engineering of Minnesota, LLC
13605 1st Avenue North
Suite 100
Plymouth, MN 55441
763-412-4000 (o) 763-412-4090 (f)
www.ae-mn.com

Drawing Title: SITE SURVEY
Approved: Project Director

Project Title: ROADWAY AND STORM DRAINAGE REPLACEMENT
Location: MARIETTA NATIONAL CEMETERY MARIETTA, GEORGIA
Date: JANUARY 31, 2014 | Checked: TG/MB | Drawn: TH/PH

Project Number: 859CM3020
Building Number:
Drawing Number: B-1.05
Dwg. 8 of 58

National Cemetery Administration
Department of Veterans Affairs

VA FORM 08-6231

one eighth inch = one foot three quarters inch = one foot one quarter inch = one foot three eighths inch = one foot one half inch = one foot one inch = one foot one and one half inches = one foot three inches = one foot
K:\13300\13371 VA IDIQ 2012 Marietta National Cemetery - Replace Roads and Storm Drainage\Dwg C3d\Record Plans Aug 2015\13371 S-1 - Asbuilt.dwg 9-23-15 05:56:51 PM CAgsen