



MATCH LINE G SEE SHEET B-1.07

MATCH LINE F SEE SHEET B-1.05


SEE SHEET B-1.03
MATCH LINE D

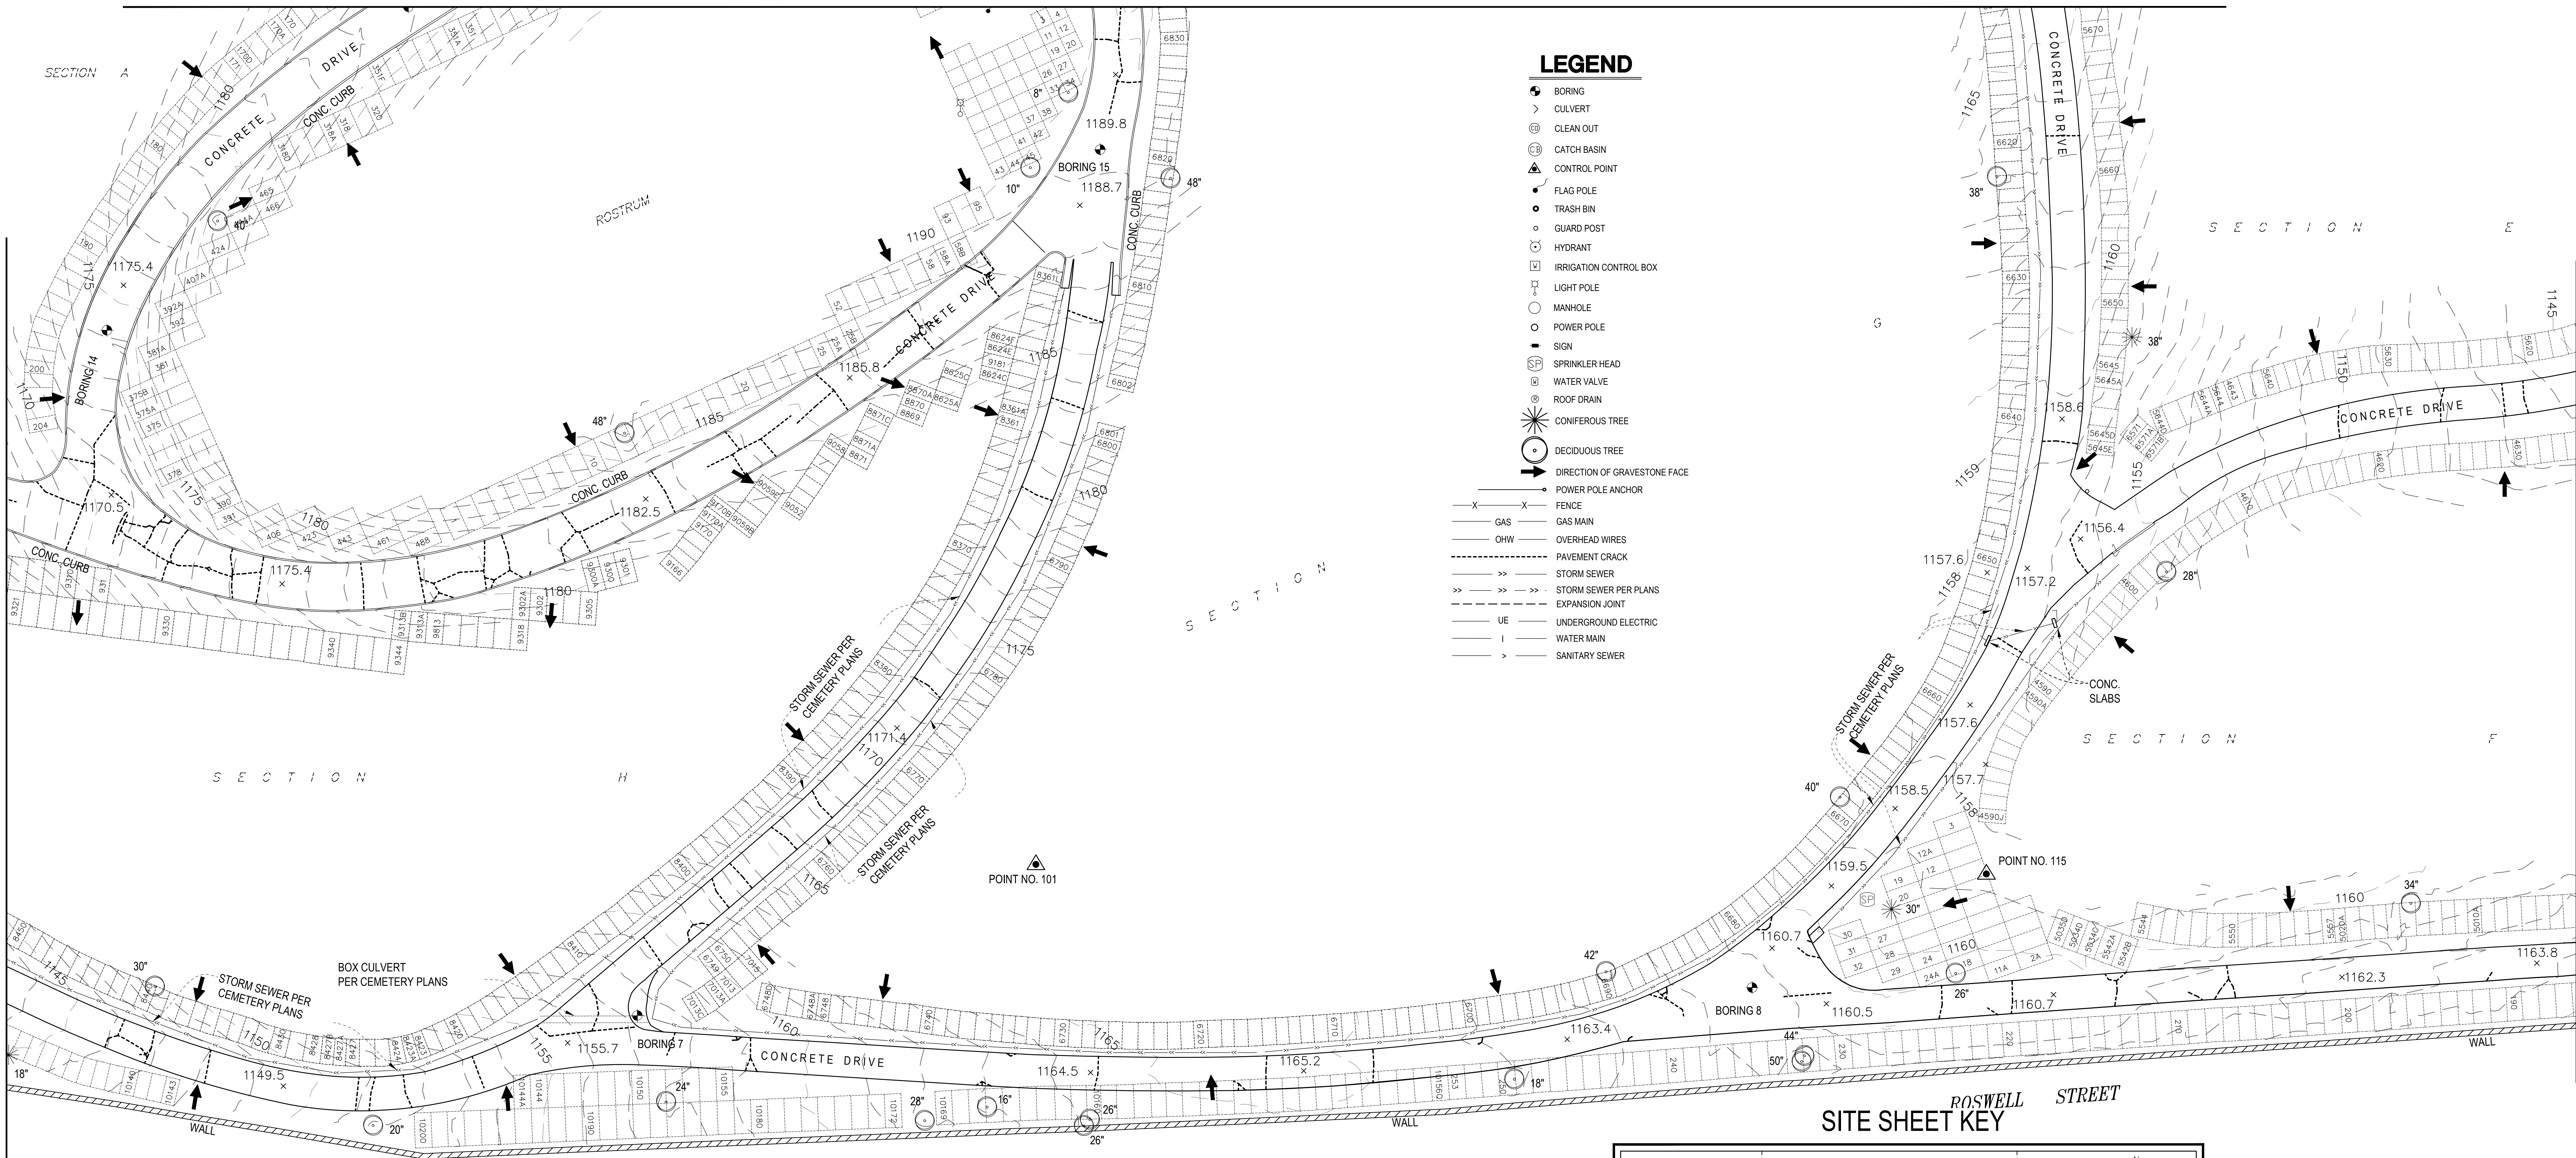

LEGEND

- BORING
- CULVERT
- CLEAN OUT
- CATCH BASIN
- CONTROL POINT
- FLAG POLE
- TRASH BIN
- GUARD POST
- HYDRANT
- IRRIGATION CONTROL BOX
- LIGHT POLE
- MANHOLE
- POWER POLE
- SIGN
- SPRINKLER HEAD
- WATER VALVE
- ROOF DRAIN
- CONIFEROUS TREE
- DECIDUOUS TREE
- DIRECTION OF GRAVESTONE FACE
- POWER POLE ANCHOR
- FENCE
- GAS MAIN
- OVERHEAD WIRES
- PAVEMENT CRACK
- STORM SEWER
- STORM SEWER PER PLANS
- EXPANSION JOINT
- UNDERGROUND ELECTRIC
- WATER MAIN
- SANITARY SEWER

SITE SHEET KEY

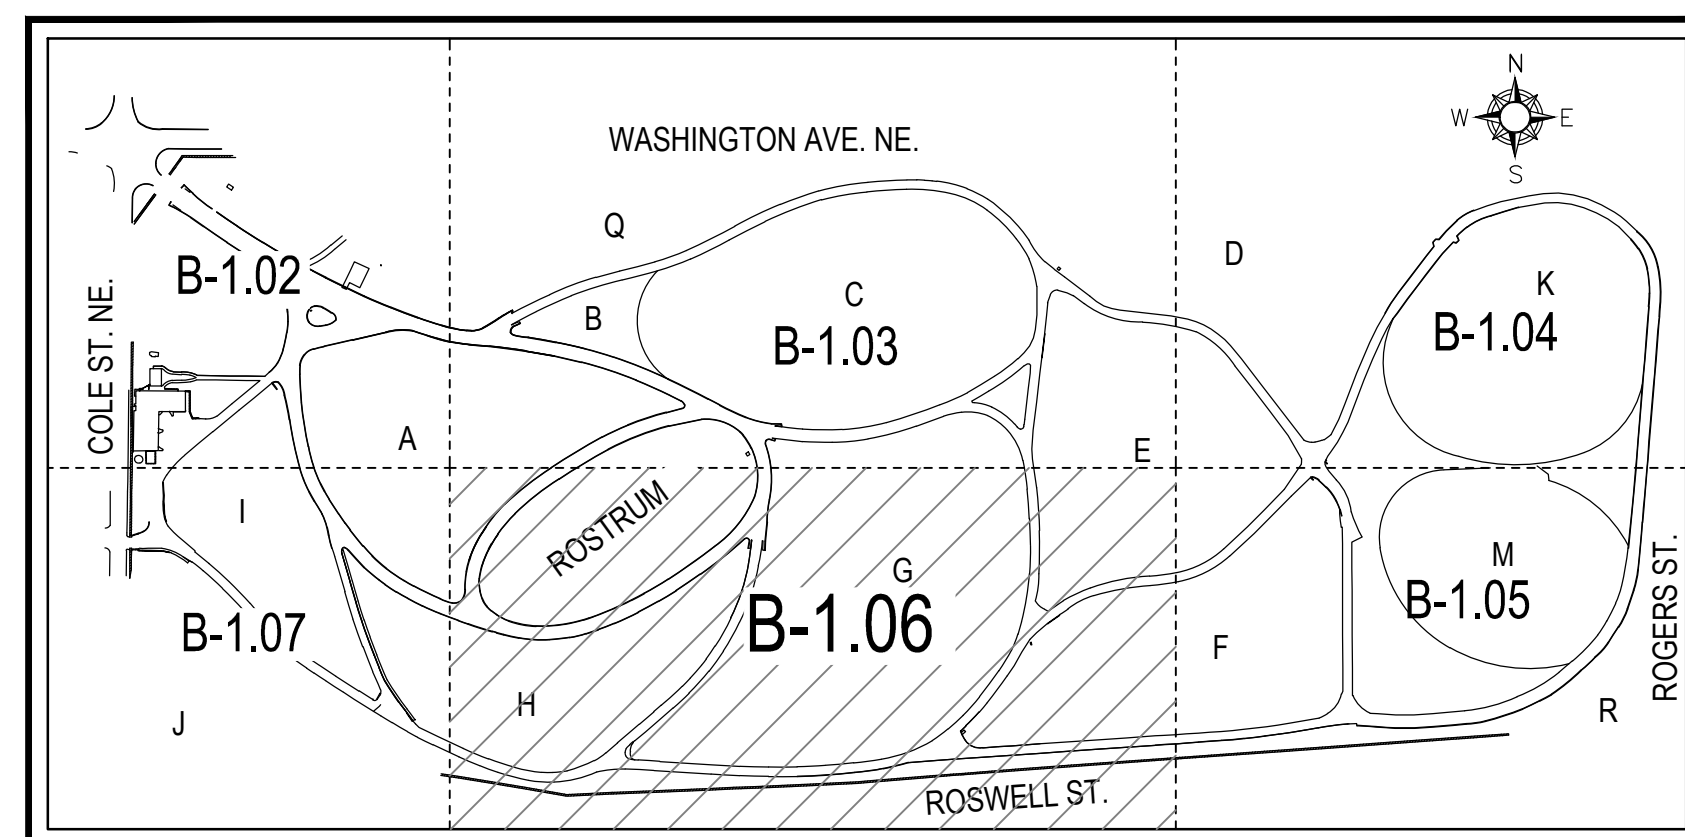

ASBULT DRAWINGS - SEPTEMBER 10, 2015

CONSULTANTS: Terracon Terracon 2855 Premiere Pkwy, Ste. C Duluth, GA 30097 (770) 623-0755 tel (770) 623-9628 fax www.terracon.com		ARCHITECT/ENGINEERS: ANDERSON ENGINEERING ENGINEERING • ARCHITECTURE • LAND SURVEYING ENVIRONMENTAL SERVICES • LANDSCAPE ARCHITECTURE Anderson Engineering of Minnesota, LLC 13605 1st Avenue North Suite 100 Plymouth, MN 55441 763-412-4000 (o) 763-412-4090 (f) www.ae-mn.com		Project Title ROADWAY AND STORM DRAINAGE REPLACEMENT Location MARIETTA NATIONAL CEMETERY MARIETTA, GEORGIA Date JANUARY 31, 2014 Checked TGMB Drawn THPH		Drawing Title SITE SURVEY Approved: Project Director		Project Number 859CM3020 Building Number Drawing Number B-106 Dwg. 9 of 58		National Cemetery Administration Department of Veterans Affairs	
ASBULT DRAWINGS Revisions: 9-10-15 Date											