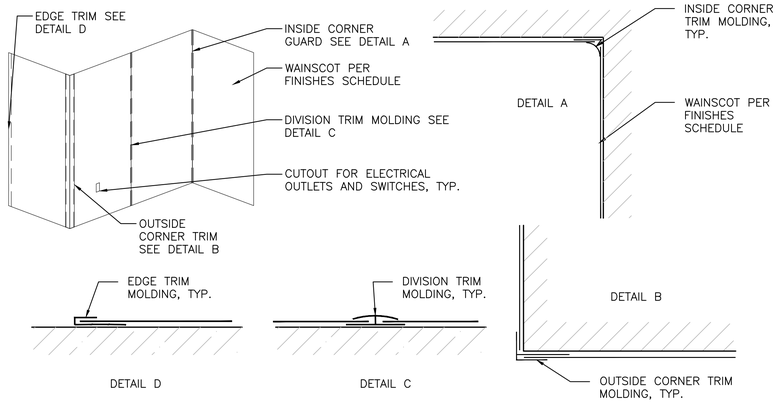

B1 TYPICAL WAINSCOT
SCALE: 3" = 1'-0"

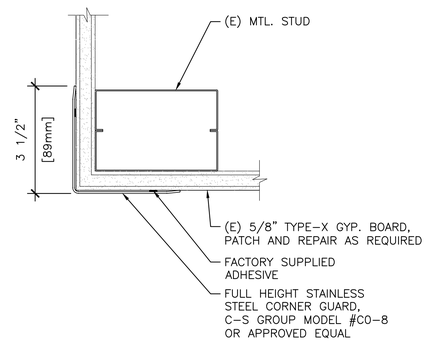

B4 CORNER GUARD
SCALE: 6" = 1'-0"

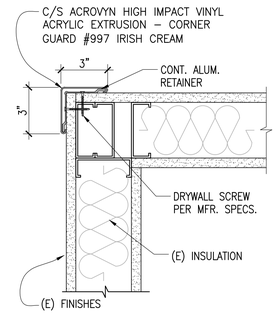

NOTE:
REMOVE EXISTING CORNER GUARD AND RETAINER PRIOR INSTALLATION OF NEW FLOOR TILE AND WALL BASE. REINSTALL (E) CORNER GUARD AND RETAINER BACK TO ORIGINAL LOCATION AND REPLACE WITH NEW TO MATCH EXISTING IF IT'S DAMAGED PRIOR OR DURING CONSTRUCTION.

B6 CORNER GUARD - ACRYLIC
SCALE: 3" = 1'-0"

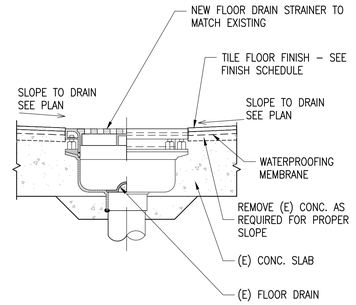

B8 FLOOR DRAIN
SCALE: 1-1/2" = 1'-0"

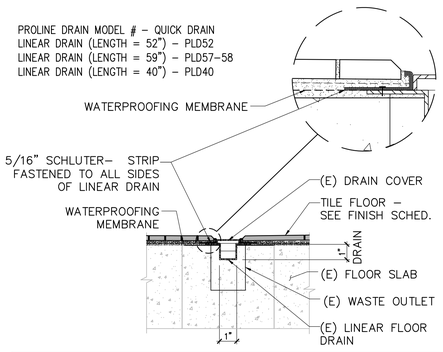

NOTE:
REMOVE EXISTING DRAIN COVER AND EDGE STRIP, INSTALL NEW FLOOR TILE AND SCHLUTER STRIP AND REINSTALL EXISTING LINEAR DRAIN COVER. REPLACE WITH NEW DRAIN COVER TO MATCH EXISTING IF IT'S DAMAGED PRIOR OR DURING CONSTRUCTION.

D2 LINEAR DRAIN
SCALE: 3" = 1'-0"

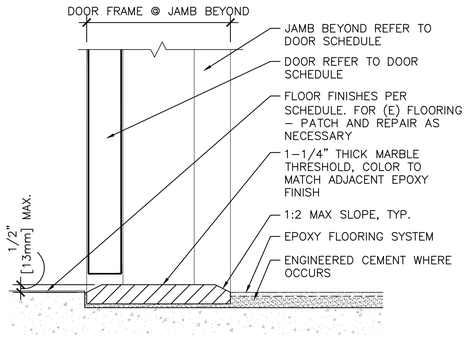

D4 RESILENT/EPOXY FLOOR DOOR THRESHOLD
SCALE: 3" = 1'-0"

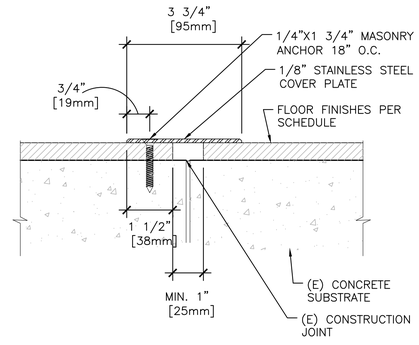

D6 COVER PLATE OVER FLOOR JOINT
SCALE: 6" = 1'-0"

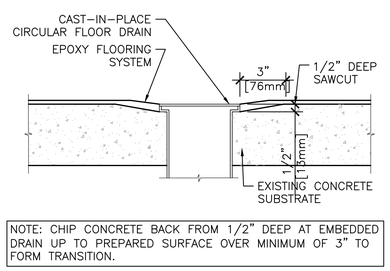

NOTE: CHIP CONCRETE BACK FROM 1/2" DEEP AT EMBEDDED DRAIN UP TO PREPARED SURFACE OVER MINIMUM OF 3" TO FORM TRANSITION.

D8 EPOXY FLOORING AT FLOOR DRAIN/CLEANOUT
SCALE: 3" = 1'-0"

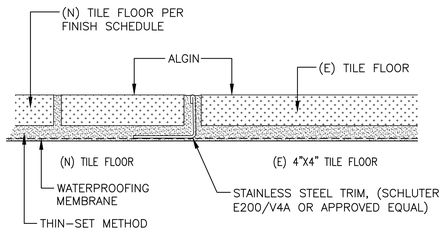

F2 TILE FLOOR TRANSITION
FULL SCALE

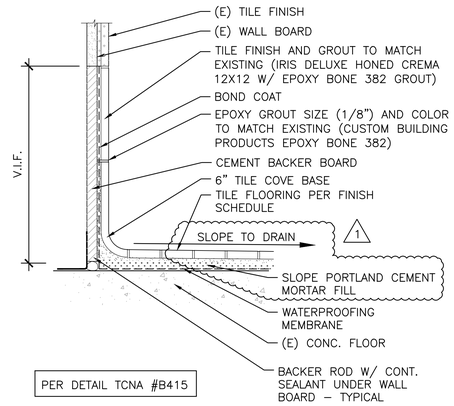

PER DETAIL TCNA #B415

F4 TILE FLOORING COVE BASE
SCALE: 3" = 1'-0"

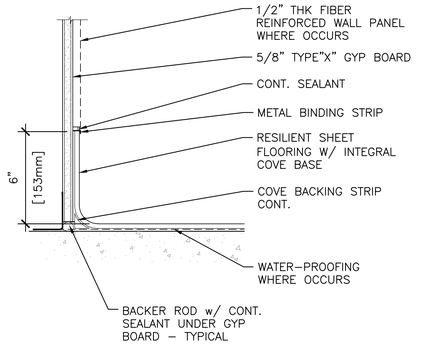

F6 RESILIENT SHEET FLOORING COVE BASE
SCALE: 3" = 1'-0"

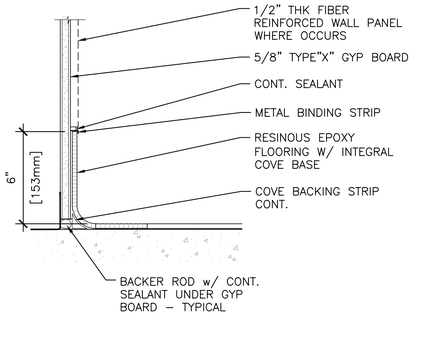

F8 EPOXY COVE BASE
SCALE: 3" = 1'-0"

100% CONSTRUCTION DOCUMENTS

Revisions:	Date
35% SCHEMATIC SUBMISSION	07/12/13
85% DESIGN DEVELOPMENT	11/19/13
100% CONSTRUCTION DOCUMENTS	03/06/14
1 REVISION 1	06/20/16

CONSULTANTS:

LICENSED ARCHITECT SHIRISH R.DESAI C-20141 04/30/17 STATE OF CALIFORNIA

ARCHITECT/ENGINEERS:

SRD ARCHITECTS INC
ARCHITECTURE INTERIORS PROJECT MANAGEMENT
3920 E. CORONADO STREET, SUITE 201
ANAHEIM CALIFORNIA 92807
1000 S FREMONT AVE, UNIT 53,
BLDG. A1, SUITE 1218
ALHAMBRA CALIFORNIA 91803
www.SRDarchitectsInc.com
O: 714 688 0212 • 626 202 0546 • FAX: 714 688 0244

Drawing Title: INTERIOR DETAILS

Project Title: REPLACE FLOORING AND FINISHES VARIOUS BUILDINGS

Project Number: 600-13-116

Building Number: 150 C + 161

Location: 5901 EAST SEVENTH STREET LONG BEACH, CA 90822

Drawing Number: AE-502

Approved: CHIEF CONSTRUCTION MANAGEMENT/DESIGN SECTION

PROJECT ENGINEER

Date: 03/06/14 | Checked: W.H. | Drawn: M.K.

Dwg. 41 of 62

Office of Construction and Facilities Management

Department of Veterans Affairs

100% CONSTRUCTION DOCUMENTS

VA FORM 08-6231

10/24/2016 1:57:28 AM, ARCH expand E1 (30.00 x 42.00 Inches)