

**Q1.)** *Should our bid include the removal of 6 sanitary drains exiting the foundation, scope indicates 4 to 6 lines, possibly more?*

**A1.)** No, your bid should include only tying into the one main sewer line exiting the foundation. All drains (new and existing) that are required to be functional shall be tied into this one main.

**Q2.)** *Will we be required to trench outside the building for any new sewer connections to the City sanitary line?*

**A2.)** No sanitary work outside the building is included in the scope.

**Q3.)** *Can you provide the approximate invert of the sanitary connection at the Fort Hill Avenue line where it exits the foundation?*

**A3.)** Inverts are not available.

**Q4.)** *Will excavation outside of the shaded area on drawing for sanitary removal be considered additional work?*


**A4.)** Excavation outside the shaded area is not included in the contract. Any work deemed necessary by the Contracting Officer outside the shaded will be additional work.

**Q5.)** *Are we to bid the removal of the abandoned manhole on East Street and Fort Hill?*

**A5.)** No, the man hole shall be abandoned in place, however the connection of the abandoned line at building 20 shall be disconnected, cut at sub-grade and capped.

East Street

Building 20

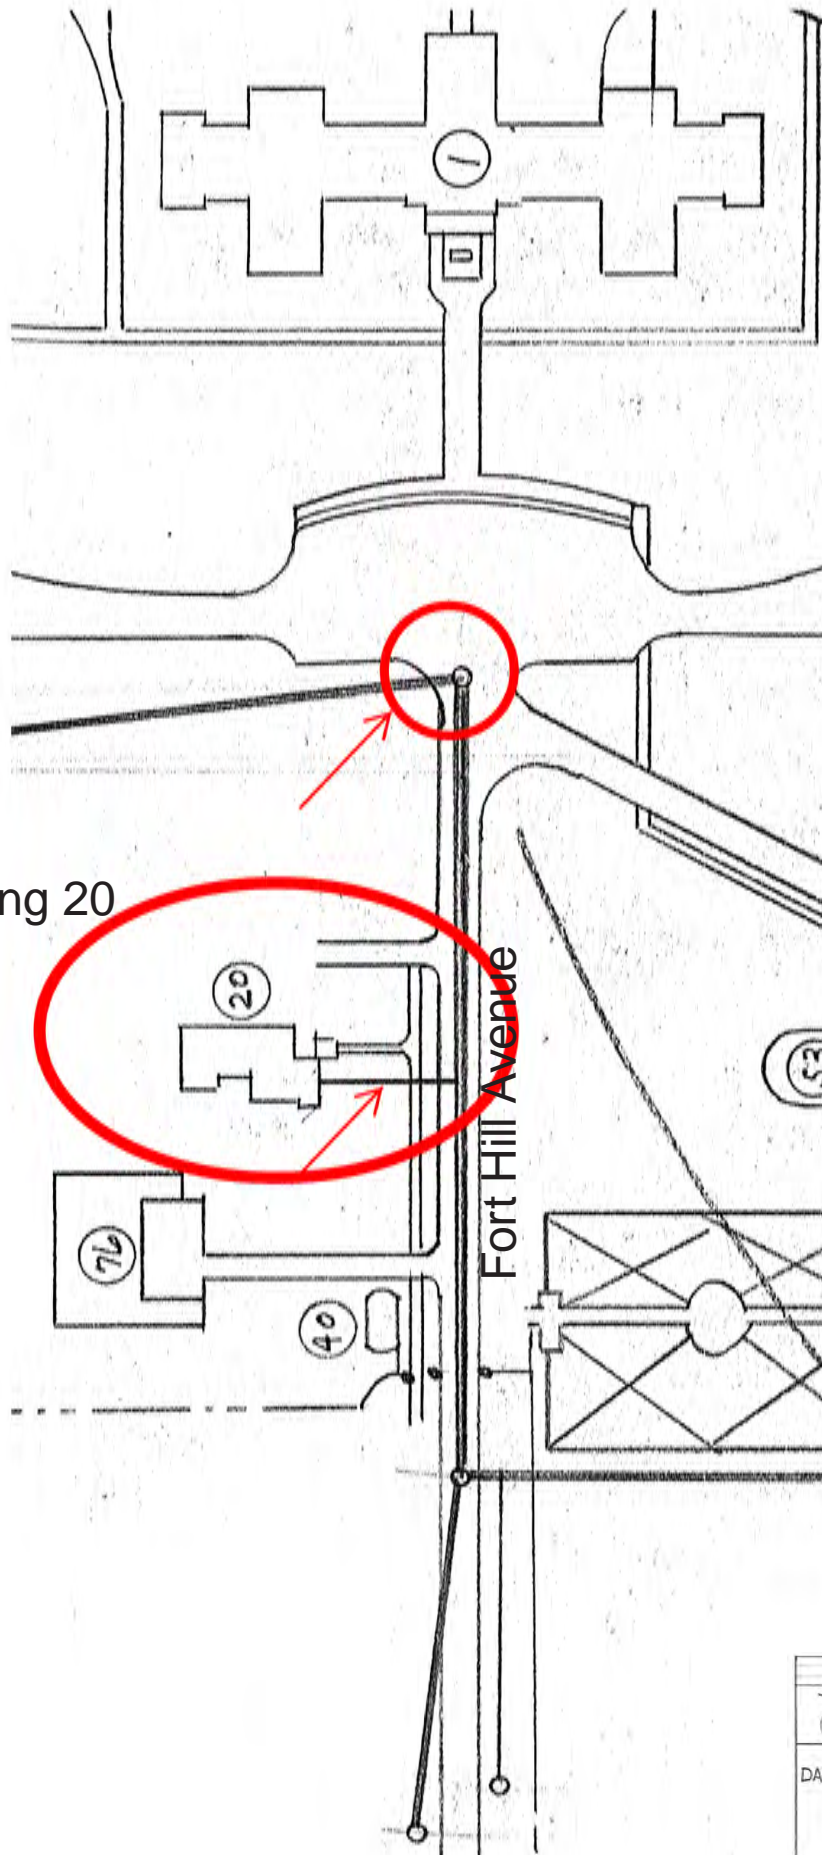

SANITARY SEWERS		
- VETERANS ADMINISTRATION FACILITY -		
CANANDAIGUA, NEW YORK		
DATE: 10/24/42		DWG. NO. 29