

ADDENDUM #4

Project #516-336 Bay Pines VA Cancer Infusion Center (201144)

05/09/14


This addendum is made and hereby becomes a part of the Construction Documents for this project dated 11/15/2013 as prepared by Long & Associates Architects/Engineers, Inc., 4525 S. Manhattan Avenue, Tampa, FL 33611.

Changes to Drawing:


3.01 Refer to Drawing E0.2, Light Fixture Schedule:

- A. Per directive from BPVA COR, revise fixture type "SD" exterior LED bollard specification to the following BPVA Standard for bollards: Beacon Metro, Model #MTB-F. See clouded area on attached Sketch RE.03 for related revisions to light fixture schedule.

END OF ADDENDUM #4

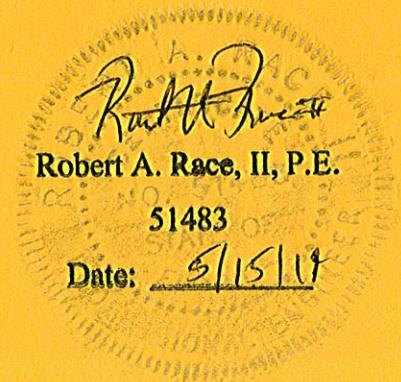

SD	EXTERIOR LED BOLLARD	BEACON	MTB-F-42-AC-24G-30-UNV-IND5-XX	30 WATT, 1,560 LUMENS, 4000K	IN-GRADE PER MANUFACTURER'S RECOMMENDATIONS. SEE "POLE BASE FOR BOLLARDS" DETAIL	DIE CAST ALUMINUM HOUSING. INTEGRAL SURGE PROTECTOR, STAINLESS STEEL FASTENERS, WET LOCATION LISTED. CUSTOM COLOR BY ARCHITECT. PROVIDE ANCHORAGE PER MANUFACTURER'S RECOMMENDATIONS. 5 YEAR WARRANTY ON ALL FIXTURE COMPONENTS.
SE SE1	6" EXTERIOR LED DOWNLIGHT	GOTHAM	ALED-41/14-6AR-MVOLT-SF	24.6 WATT LED, 1538 LUMENS, 4100K	RECESSED FLANGED	INTEGRAL FUSED LED DRIVER, SEMI-SPECULAR FINISH, CLEAR TRIM, TEMPERED GLASS LENS. LIGHT ENGINE AND DRIVER SHALL BE ACCESSIBLE FROM BELOW CEILING. DAMP LISTED. FIXTURE TYPE 'SE1' IS SAME AS TYPE 'SE', EXCEPT FIXTURE HAS INTEGRAL 90 MINUTE, FULL LUMEN OUTPUT BATTERY CHARGER. 5 YEAR WARRANTY ON ALL FIXTURE COMPONENTS.

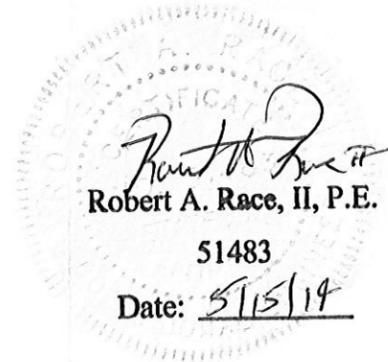
Robert A. Race, II, P.E.
 51483
 Date: 5/15/14

ADDENDUM #4


JOB NO: 516-336

DRAWN: RAR

CHECKED: RAR

DATE: 05/08/14

REFER TO DWG: E0.2

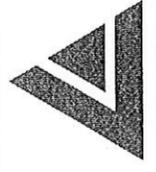

CANCER INFUSION THERAPY CENTER

LONG & ASSOCIATES
ARCHITECTS / ENGINEERS, INC.

4525 S. Manhattan Ave., Tampa, FL 33611-2305
 T: (813) 839-0506 F: (813) 839-4616 aac001624 1828 QB0013991