


H.V.A.C.
 (B) UPPER LEVEL FLOOR PLAN
 1/8"=1'-0"

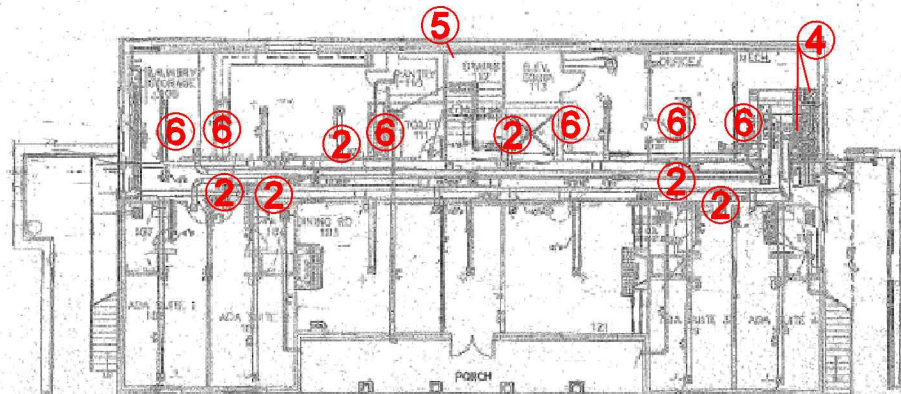

H.V.A.C.
 (B) MAIN LEVEL FLOOR PLAN
 1/8"=1'-0"

Removal Notes: Sheet H2

1. Remove current control system.
2. Remove existing temperatures sensors in each room.
3. Remove current condensing units.
4. Remove Furnace, evaporator, filter media section, and humidifier. Removal will start where the return duct turns 90 degrees before the filter section and end where at the current flex connection above the evaporator.
5. Remove refrigerant lines.
6. Remove existing damper actuator.

Drawing Title Fisher House HVAC	Project Title SPACE UTILIZATION	Date 5/16/16	<div>VA</div> Department of Veterans Affairs
		064-R	
REMOVALS	Building Number 016	H-2	