



\*Hydrant #2 was not tested due to construction in the area.

Test Conducted by: Firetech Consulting, Inc.  
 Randy Legler, PE  
 Jason Miller  
 Test Witnessed by: James Greenwell (VAMC)

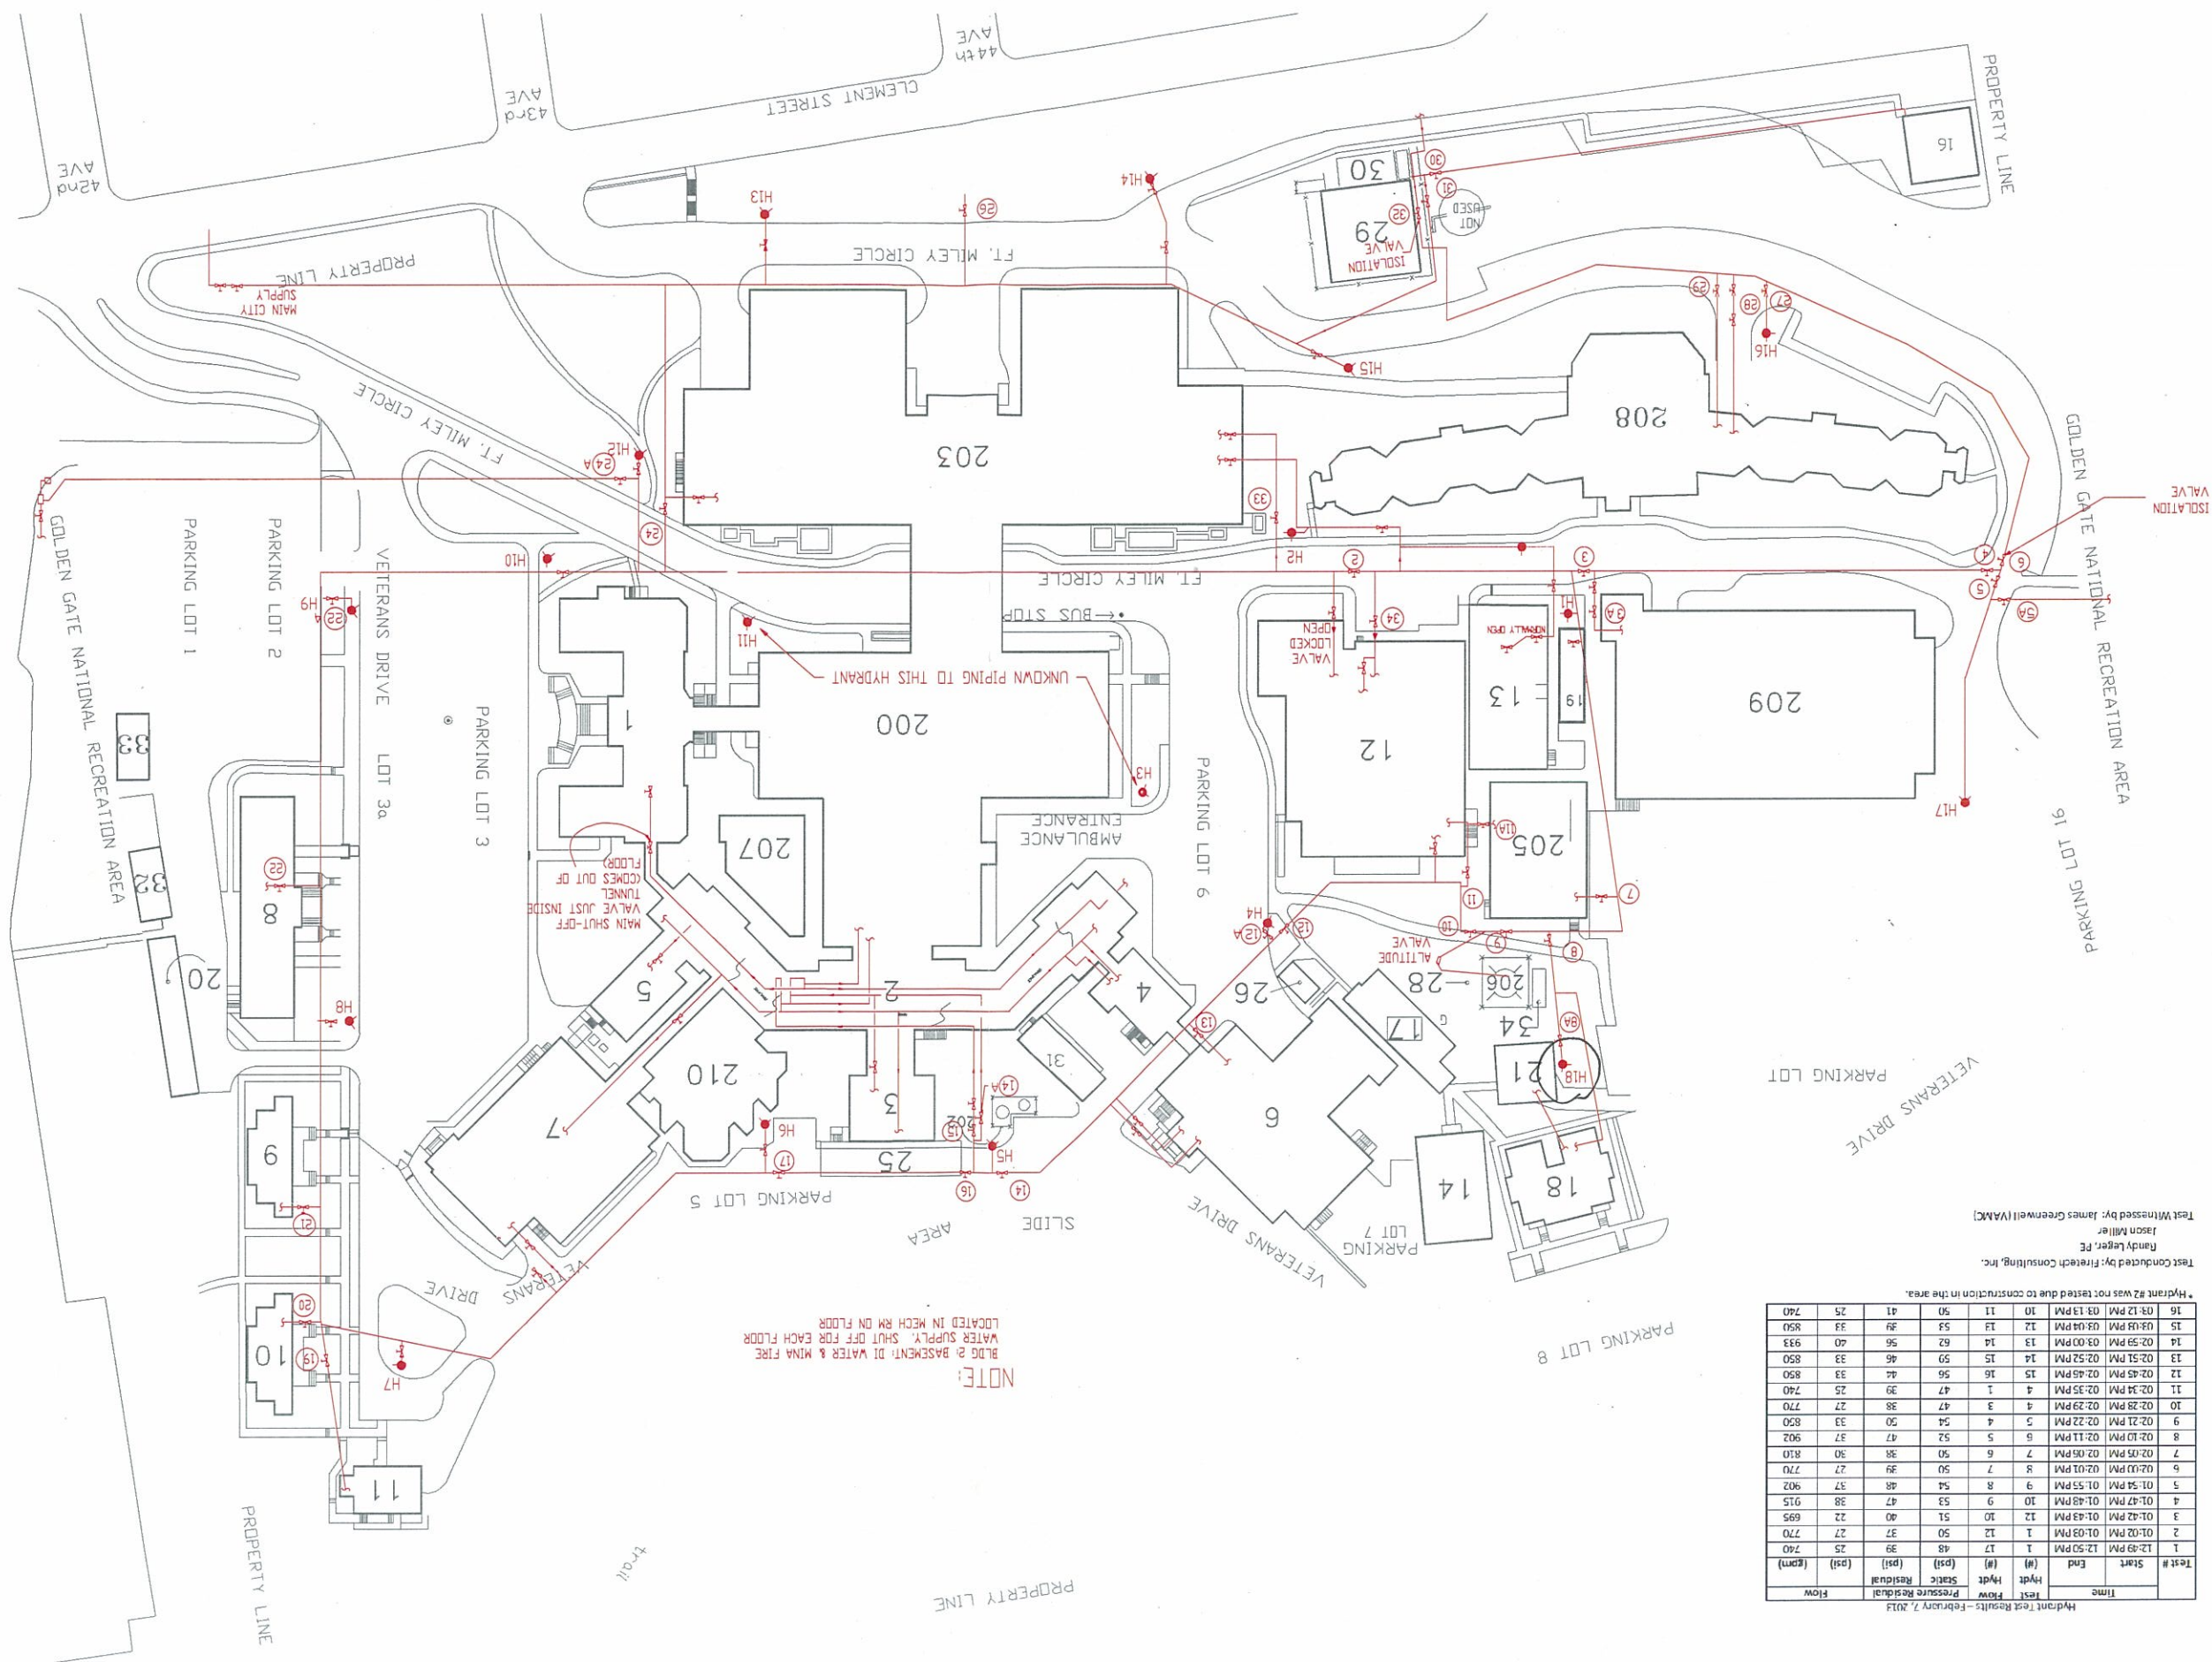

SCALE: DATE: FEBRUARY 2013  
 DRAWN BY: JAM RDL  
 REVISION: CHECKED BY: RDL

FIRE HYDRANT TEST  
 FEBRUARY 2013

VA MEDICAL CENTER  
 4150 Clement Street  
 San Francisco, California

Firetech Consulting  
 8867 W Radcliff Drive  
 Littleton, CO 80123  
 Office 720.981.3413  
 Fax 720.981.3464  
 www.FiretechConsulting.com  
 Veteran-Owned Small Business

HDY - 1.0

