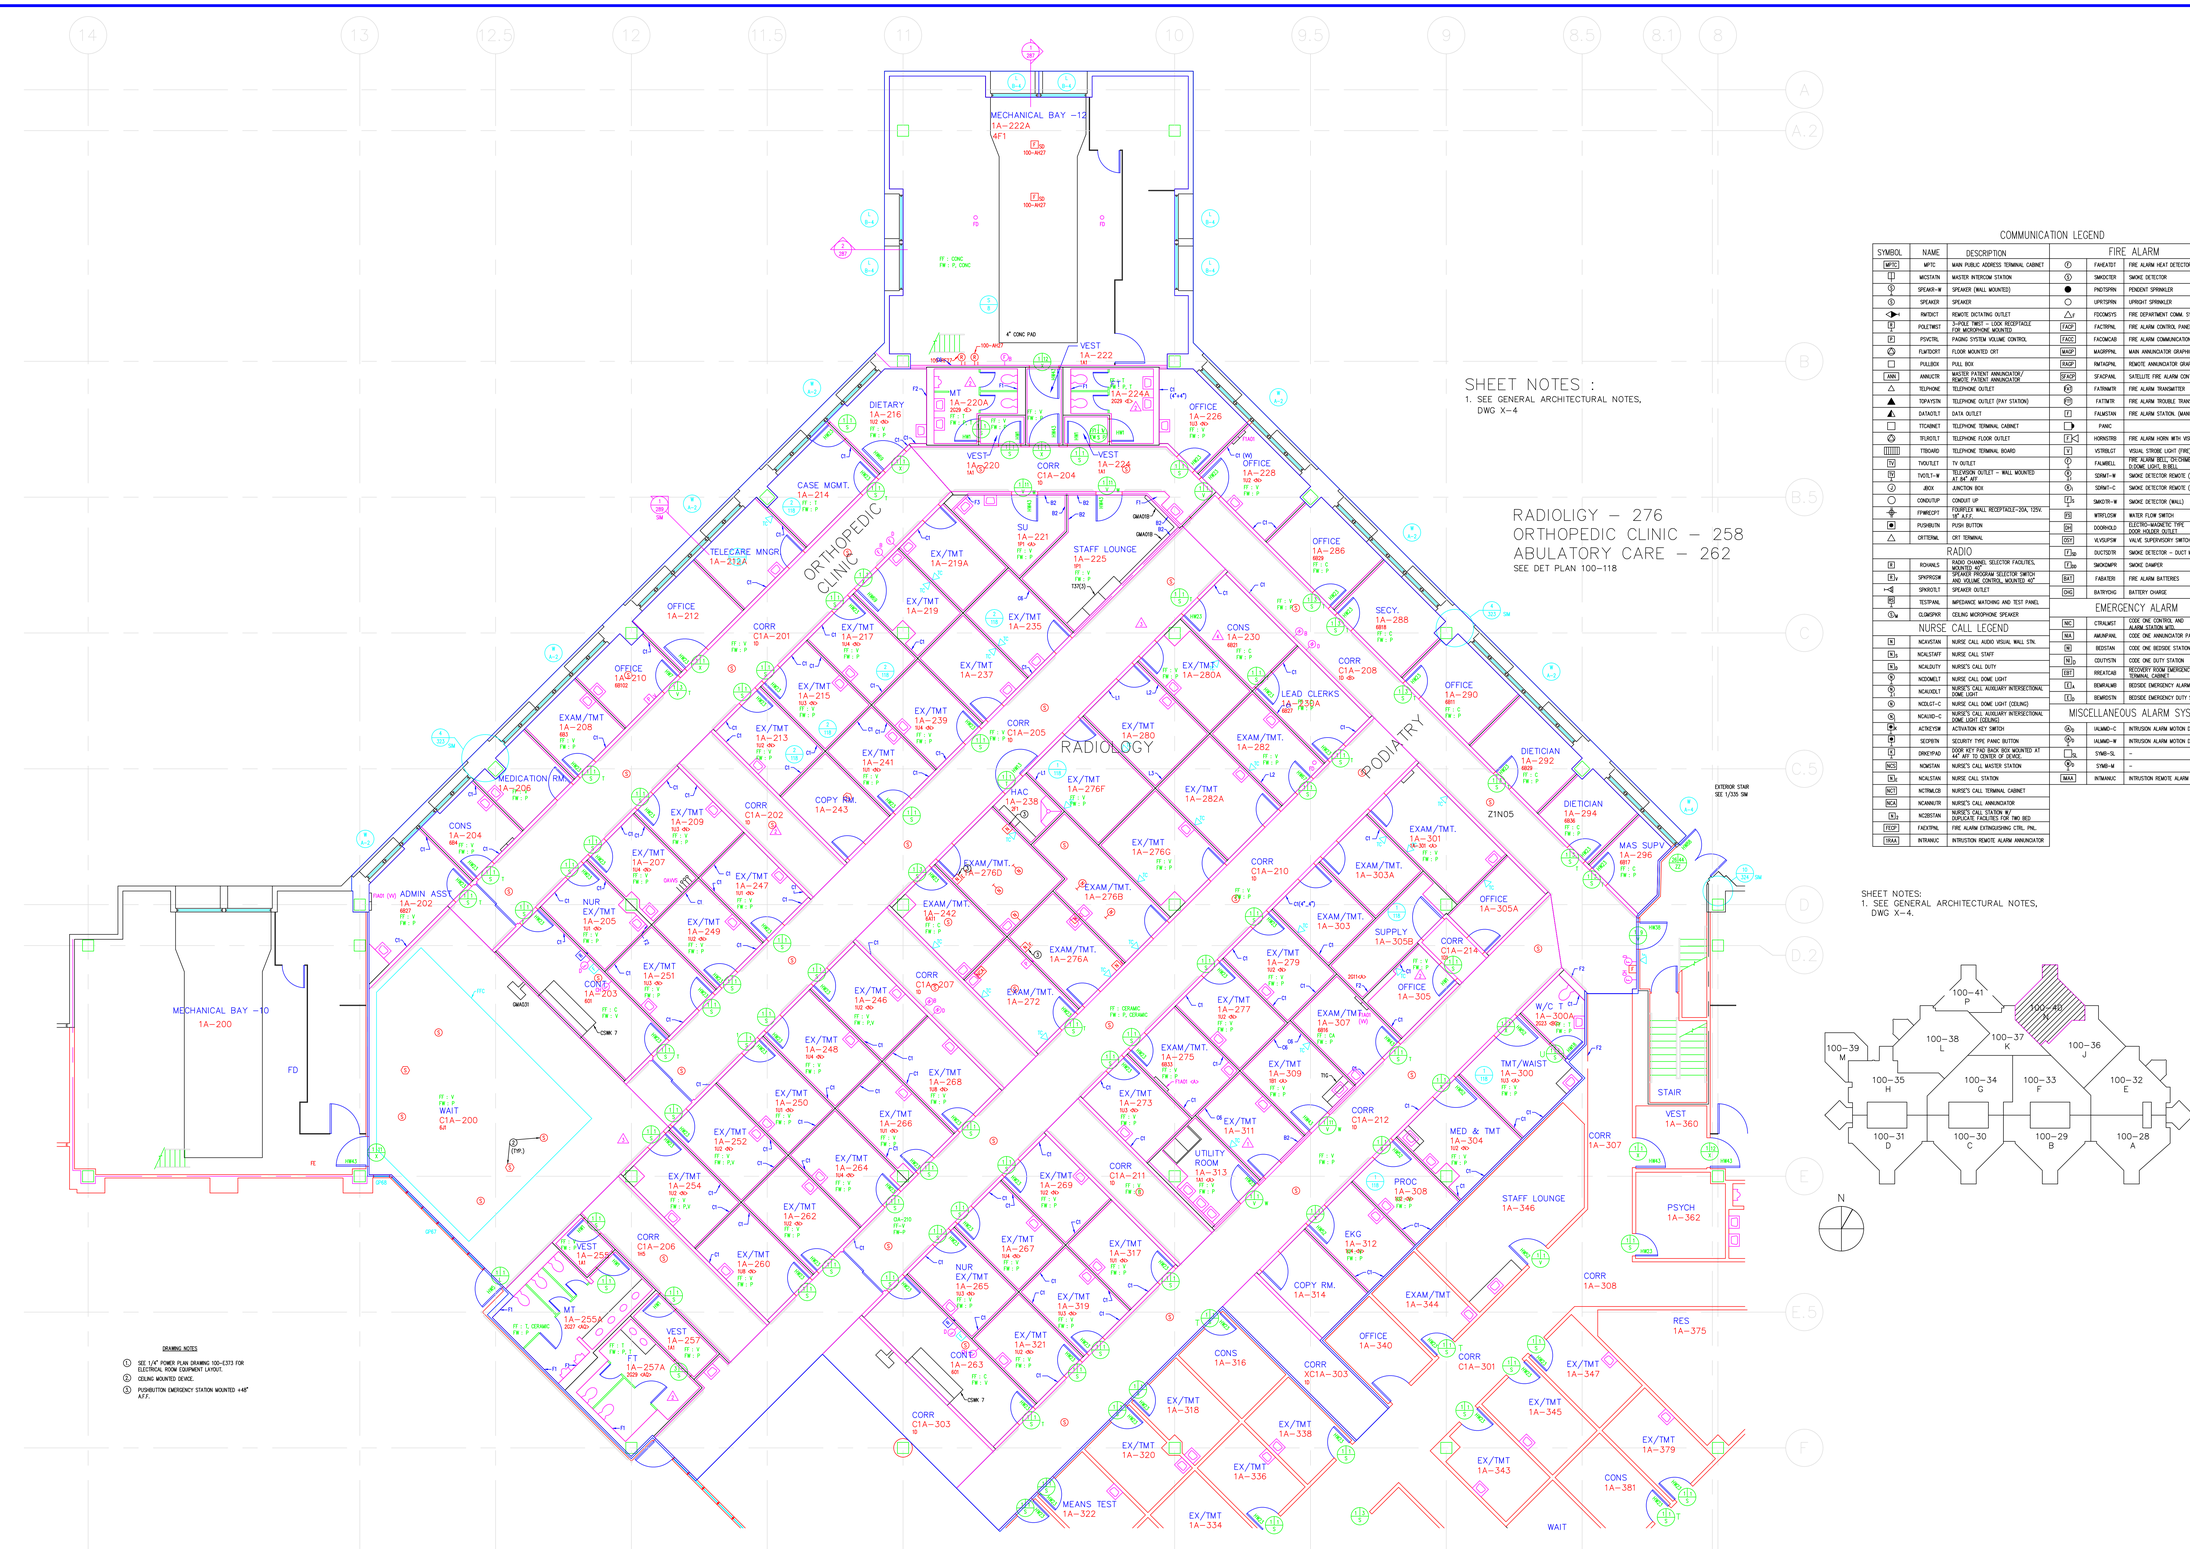

COMMUNICATION LEGEND

SYMBOL	NAME	DESCRIPTION
MPTC	MPTC	MAIN PUBLIC ADDRESS TERMINAL CABINET
	MCSTATN	MASTER INTERCOM STATION
	SPEAKR-W	SPEAKER (WALL MOUNTED)
	SPEAKER	SPEAKER
	PATDICT	REMOTE DICTATING OUTLET
	PDLETMST	3-POLE TWIST – LOCK RECEPTACLE FOR MICROPHONE MOUNTED
P	PSYCTRL	PAGING SYSTEM VOLUME CONTROL
	FLWTCRT	FLOOR MOUNTED CRT
	PULLBOX	PULL BOX
ANN	ANNUCTR	MASTER PATIENT ANNUNCIATOR/ REMOTE PATIENT ANNUNCIATOR
	TELPHONE	TELEPHONE OUTLET
	TOPAYSTN	TELEPHONE OUTLET (PAY STATION)
	DATAOUTL	DATA OUTLET
	TTCABNET	TELEPHONE TERMINAL CABINET
	TFLROUTL	TELEPHONE FLOOR OUTLET
	TTBOARD	TELEPHONE TERMINAL BOARD
TV	TVOUTLET	TV OUTLET
TV	TVOTLT-W	TELEVISION OUTLET – WALL MOUNTED AT 84" AFF.
J	JBOX	JUNCTION BOX
	CONDUITUP	CONDUIT UP
	FFWRECPT	FIREFLEX WALL RECEPTACLE-20A, 125V. 18" A.F.F.
	PUSHBUTN	PUSH BUTTON
	CRTTERNAL	CRT TERMINAL

RADIO

R	RCHANLS	RADIO CHANNEL SELECTOR FACILITIES, MOUNTED AT
R SW	SPKPRGSW	SPEAKER PROGRAM SELECTOR SWITCH AND VOLUME CONTROL, MOUNTED 40"
	SPKROUTL	SPEAKER OUTLET
	TESTPANL	IMPEDANCE MATCHING AND TEST PANEL
M	CLGMSPKR	CEILING MICROPHONE SPEAKER

NURSE CALL LEGEND

N	NCAVSTAN	NURSE CALL AUDIO VISUAL WALL STN.
N SB	NCALSTAFF	NURSE CALL STAFF
N SB	NCALDUTY	NURSE'S CALL DUTY
N	NCDOMLT	NURSE CALL DOME LIGHT
N	NCAUXOLT	NURSE'S CALL AUXILIARY INTERSECTIONAL DOME LIGHT
N	NCDLGT-C	NURSE CALL DOME LIGHT (CEILING)
N	NCAUXD-C	NURSE'S CALL AUXILIARY INTERSECTIONAL DOME LIGHT (CEILING)
NK	ACTKEYSW	ACTIVATION KEY SWITCH
N	SECPBTN	SECURITY TYPE PANIC BUTTON
N	DRKEYPAD	DOOR KEY PAD BACK BOX MOUNTED AT 44" AFF TO CENTER OF DEVICE.
NCS	NCMSTAN	NURSE'S CALL MASTER STATION
N SB	NCALSTAN	NURSE CALL STATION
NCT	NCTRMLCB	NURSE'S CALL TERMINAL CABINET
NCA	NCANNUTR	NURSE'S CALL ANNUNCIATOR
N SB	NCSBSTAN	NURSE'S CALL STATION W/ DUPLICATE FACILITIES FOR TWO BED.
FECP	FACKTPNL	FIRE ALARM EXTINGUISHING CTRL. PNL.
IRAA	INTRANUC	INTRUSTION REMOTE ALARM ANNUNCIATOR

FIRE ALARM

	FAHEATDT	FIRE ALARM HEAT DETECTOR
S	SMKDCTR	SMOKE DETECTOR
	PNDTSPRN	PENDENT SPRINKLER
	UPRTSPRN	UPRIGHT SPRINKLER
	FDCOMSYS	FIRE DEPARTMENT COMM. SYSTEM
FACP	FACTRPNL	FIRE ALARM CONTROL PANEL
FACC	FACOMCAB	FIRE ALARM COMMUNICATION CABINET
MAGP	MAGRPPNL	MAIN ANNUNCIATOR GRAPHIC PANEL
RAGP	RMTAGPNL	REMOTE ANNUNCIATOR GRAPHIC PANEL
SFACP	SFACPANL	SATELLITE FIRE ALARM CONTROL PANEL
FX	FATXMTR	FIRE ALARM TRANSMITTER
FT	FATTMTR	FIRE ALARM TROUBLE TRANSMITTER
F	FALMSTAN	FIRE ALARM STATION, (MANUAL)
	PANIC	PANIC
F	HORNSTRB	FIRE ALARM HORN WITH VISUAL UNIT
F	VSTRBLGT	VISUAL STROBE LIGHT (FIRE)
F	FALMBELL	FIRE ALARM BELL, DC/HNE, D.DOME, LIGHT, B.BELL
S	SDRMT-W	SMOKE DETECTOR REMOTE (WALL)
S	SDRMT-C	SMOKE DETECTOR REMOTE (CEILING)
S	SMKDTR-W	SMOKE DETECTOR (WALL)
FS	WTRFLOSW	WATER FLOW SWITCH
DH	DOORHOLD	ELECTRO-MAGNETIC TYPE DOOR HOLDER OUTLET
OSY	VLVSUPSW	VALVE SUPERVISORY SWITCH
S	DUCTSDTR	SMOKE DETECTOR – DUCT MOUNTED
S	SMOKDMPR	SMOKE DAMPER
BAT	FABATTR	FIRE ALARM BATTERIES
CHG	BATRYCHG	BATTERY CHARGE

EMERGENCY ALARM

NC	CTRALMST	CODE ONE CONTROL AND ALARM STATION MTD.
NA	AMUNFPNL	CODE ONE ANNUNCIATOR PANEL
N	BEDSTAN	CODE ONE BEDSIDE STATION
N D	CODTYSTN	CODE ONE DUTY STATION
ERT	RREATCAB	RECOVERY ROOM EMERGENCY ALARM TERMINAL CABINET
E	BEMRALMB	BEDSIDE EMERGENCY ALARM BUTTON
E	BEMRDSTN	BEDSIDE EMERGENCY DUTY STATION

MISCELLANEOUS ALARM SYSTEMS

	IALMMD-C	INTRUSION ALARM MOTION DETECTOR (D.6.)
	IALMMD-W	INTRUSION ALARM MOTION DETECTOR (WALL)
IL	SYMB-SL	-
	SYMB-M	-
MAX	INTMANUC	INTRUSTION REMOTE ALARM ANNUNCIATOR

SHEET NOTES:
1. SEE GENERAL ARCHITECTURAL NOTES, DWG X-4.

Revisions	Date
RECORD DRAWING	8-3-92
AMENDMENT NO. 1	20 FEB 87
AMENDMENT NO. 2	27 FEB 87
100 A-03	10 NOV 87
871 #A-1182	24 AUG 90
	18 JAN 2005

Professional Seal

Drawing Title: FIRST FLOOR PLAN – AREA N COMMUNICATION

Approved:

Approved:

Project Title: AS-BUILT Drawings

Building Number: 100 | Checked | Drawn

Location: VAMC, HOUSTON TEXAS.

Date: 2 JAN 87

Project No.: 580-040

Drawing No.: 100-28R2

VAMC - HOUSTON

Department of Veterans Affairs

VA FORM 08-6231, OCT 1978