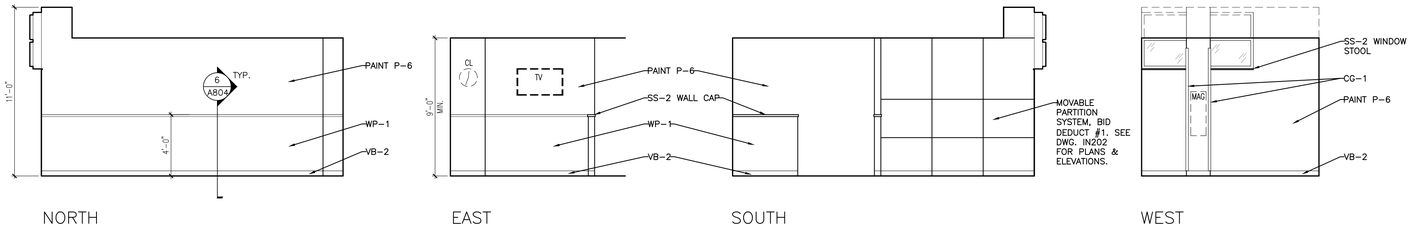

20 WAITING ROOM 1391
SCALE: 1/4" = 1'-0"

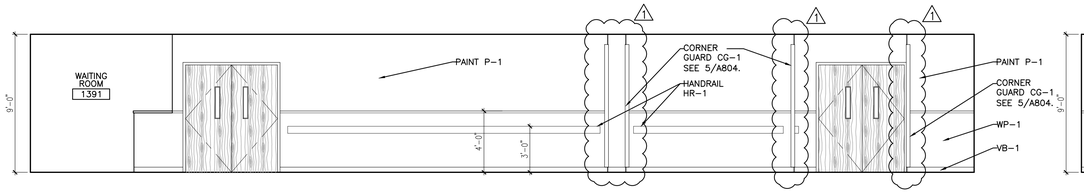

NORTH

21 CORRIDOR - C1AS18
SCALE: 1/4" = 1'-0"

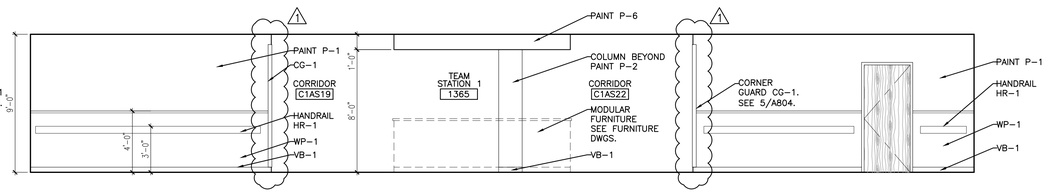

SOUTH

22 CORRIDOR - C1AS18
SCALE: 1/4" = 1'-0"

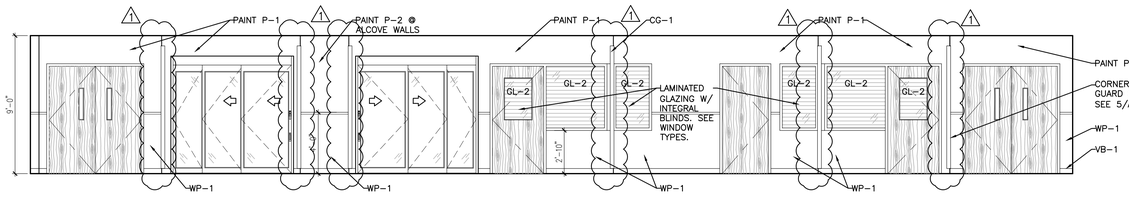

EAST

23 CORRIDOR - C1AS19
SCALE: 1/4" = 1'-0"

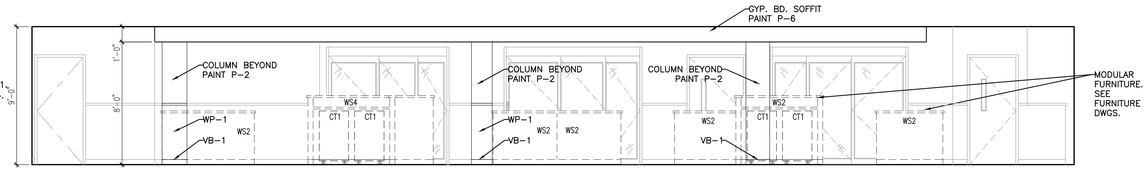

WEST

24 CORRIDOR - C1AS19
SCALE: 1/4" = 1'-0"

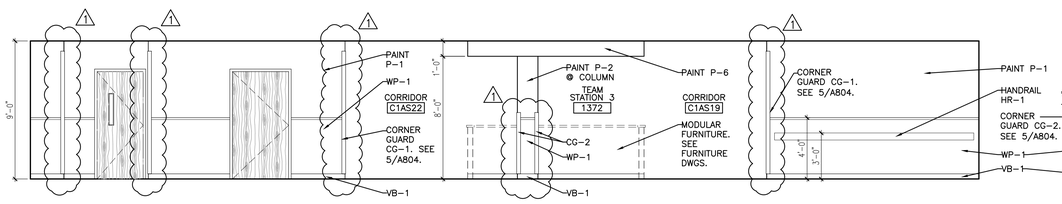

NORTH

25 CORRIDOR - C1AS20
SCALE: 1/4" = 1'-0"

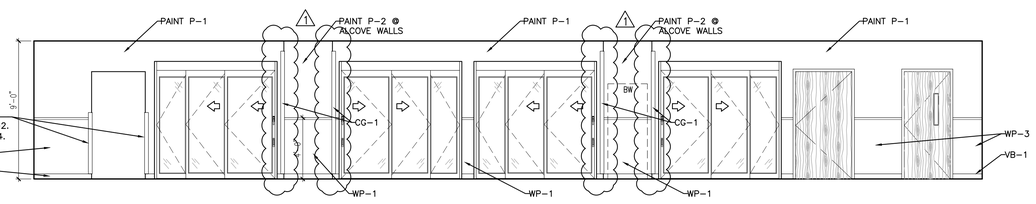

SOUTH

26 CORRIDOR - C1AS20
SCALE: 1/4" = 1'-0"

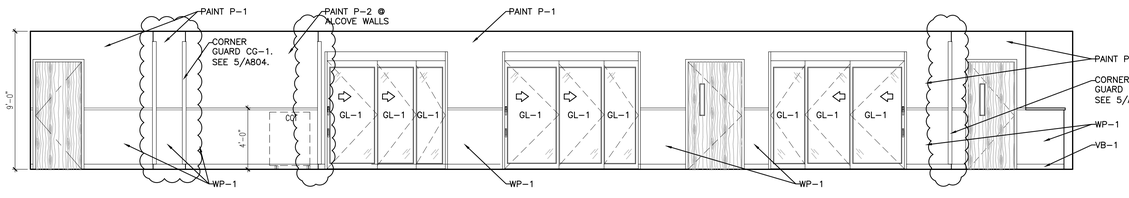

WEST

27 CORRIDOR - C1AS22
SCALE: 1/4" = 1'-0"

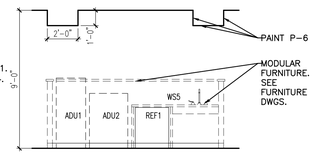

SOUTH

28 MEDS - 1370
SCALE: 1/4" = 1'-0"

FULLY SPRINKLERED
BID DOCUMENTS

Amendment #1	1 6-28-16
Revisions:	Date

Department of Veterans Affairs
Medical Center
5000 W. National Avenue
Milwaukee, WI

KEY PLAN:

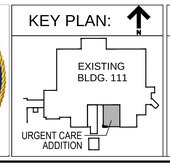

CONSULTANTS:
PCG DESIGN/BUILD SERVICES
R.A. Smith National
THE SIGMA GROUP Single Source. Sound Solutions.
Lerdahl

PROJECT LEADER:
Chequamegon BAY GROUP, INC.
309 N. WATER ST.
SUITE 650
MILWAUKEE, WI 53202
PHONE: (414) 258-6004

Drawing Title: INTERIOR ELEVATIONS	Project Title: 111 EXPAND URGENT CARE	Project Number: 695-402	Office of Facilities Management
		Building Number: 111	
Approved: Project Director	Location: VA Medical Center, Milwaukee, WI	Drawing Number: A802	Department of Veterans Affairs
	Date: January 28th, 2016 / Checked By: / Drawn By: KAB		

VA FORM 08-6231, OCT 1978