

A

B


C

D


E

F


one eighth inch = one foot
one quarter inch = one foot
three eighths inch = one foot
one half inch = one foot
three quarters inch = one foot
one inch = one foot
one and one half inches = one foot
two inches = one foot
three inches = one foot

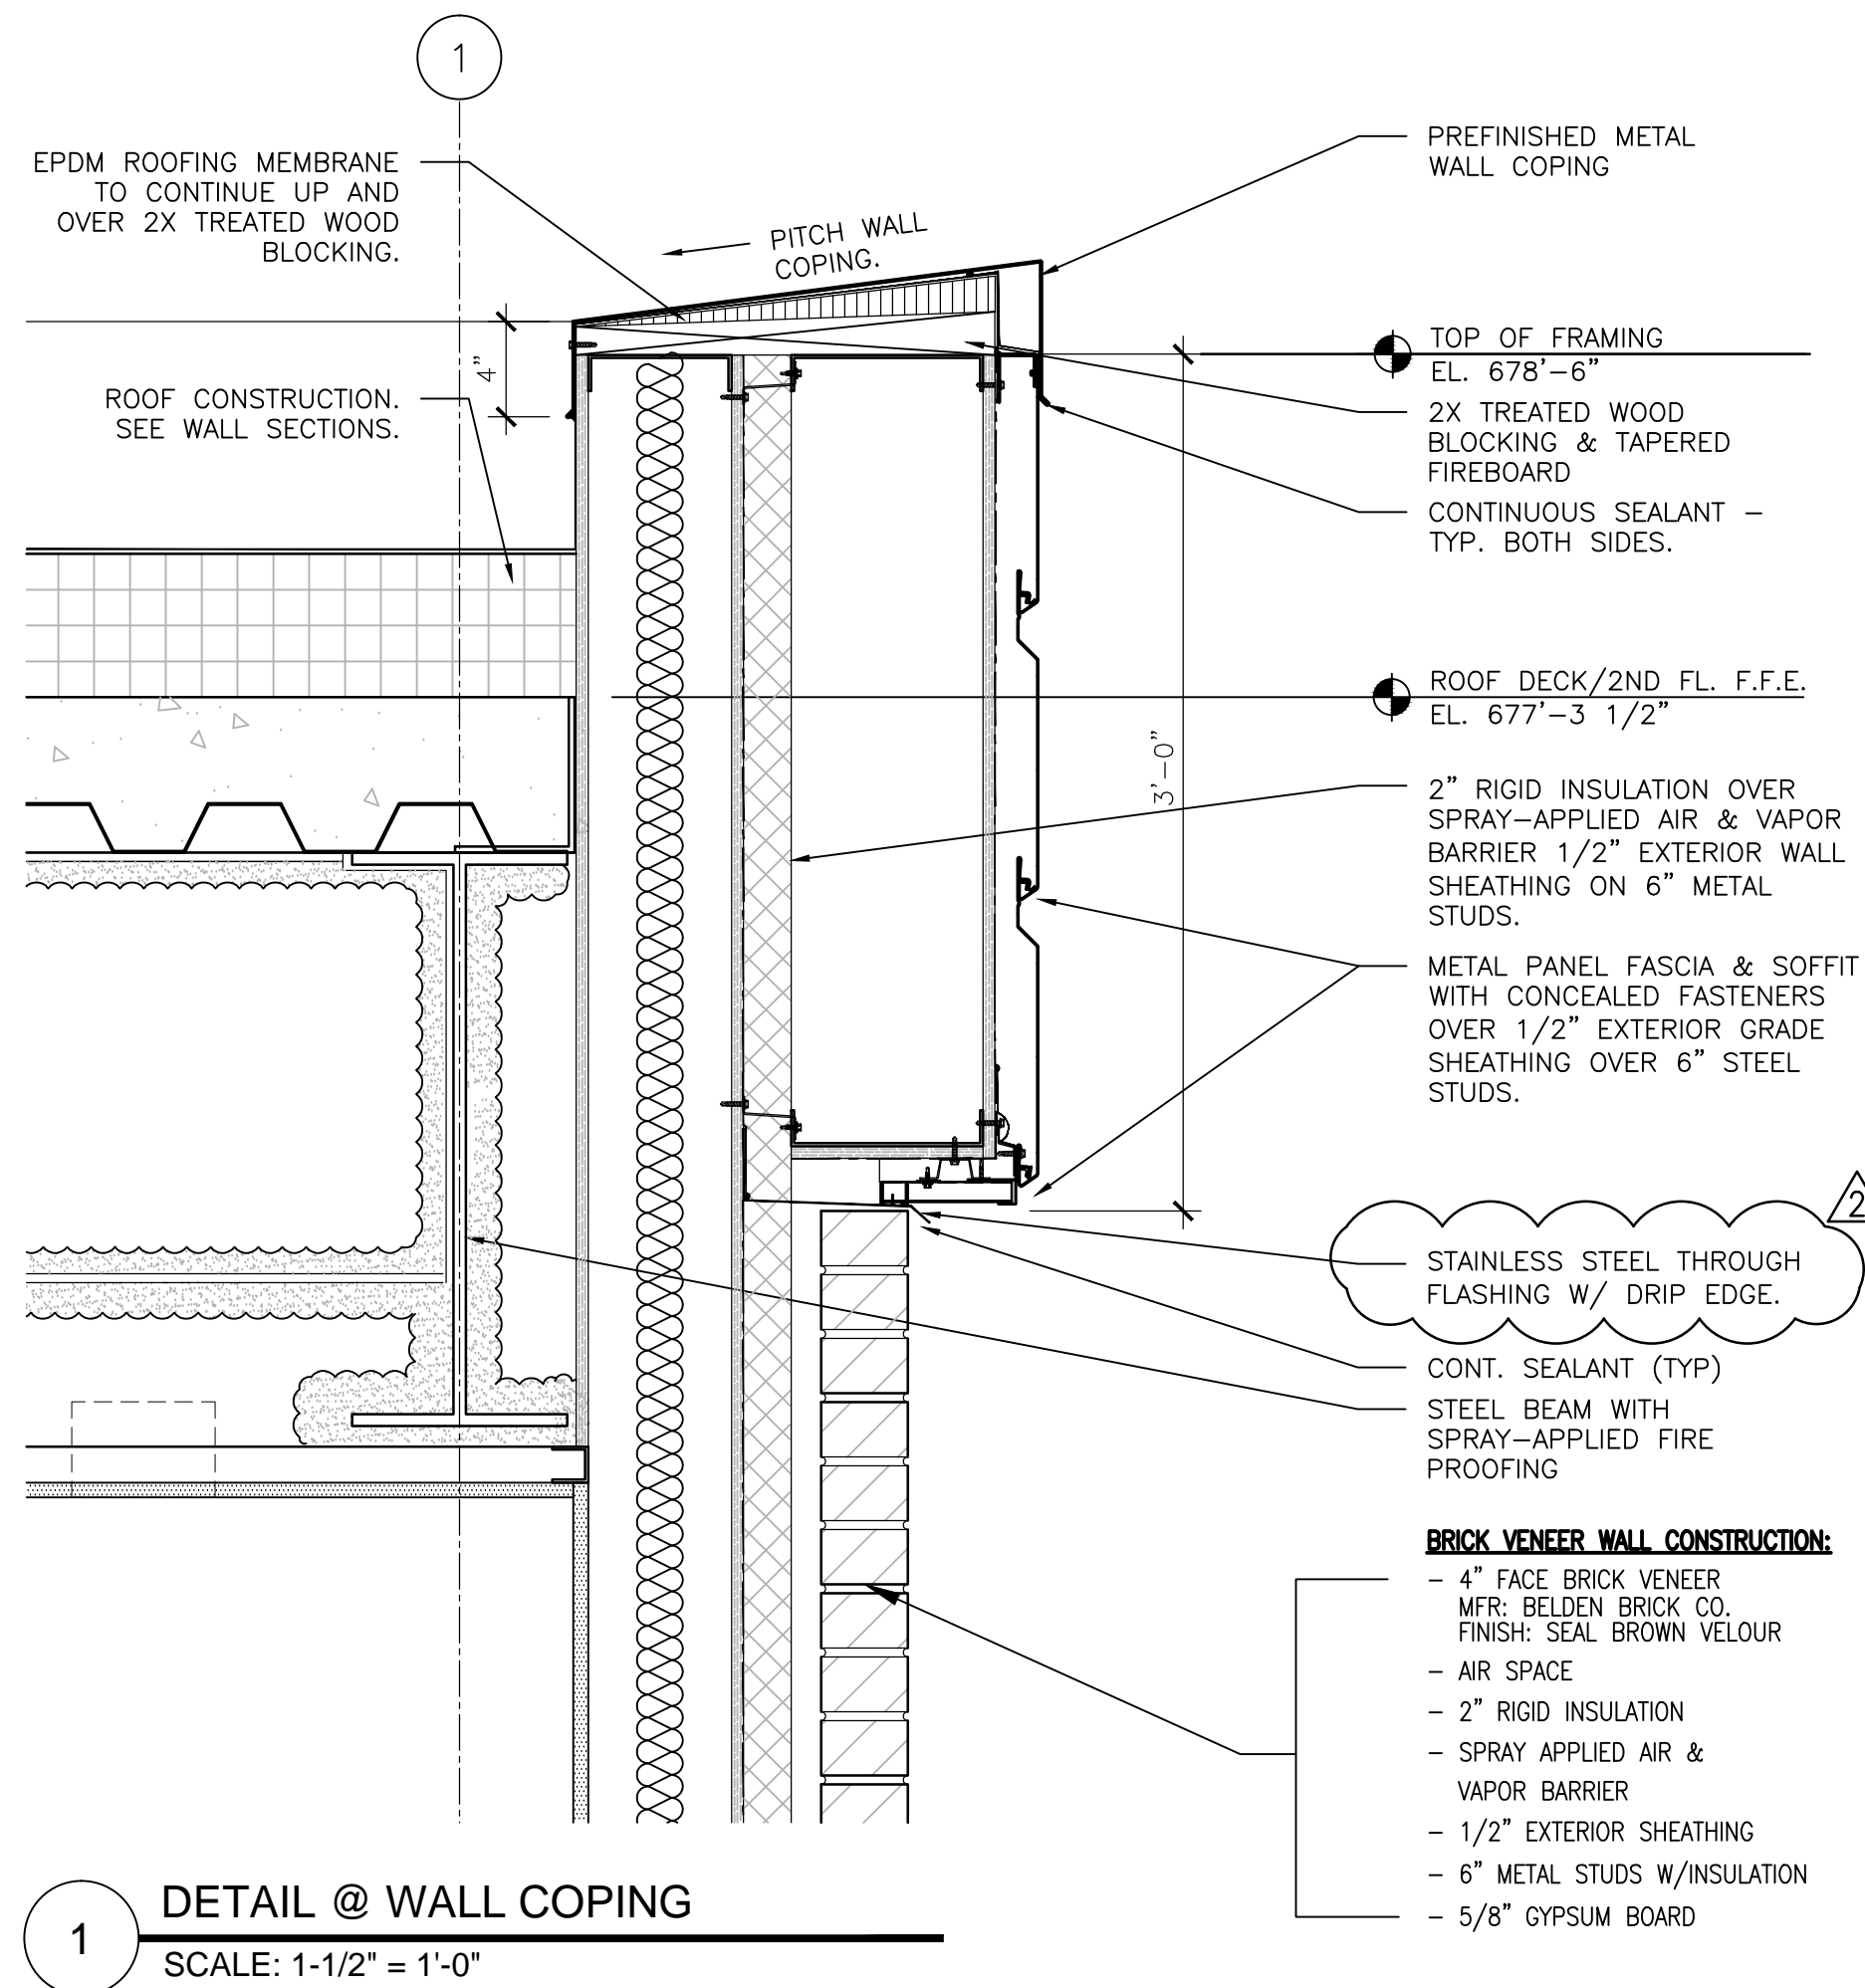


1 DETAIL @ WALL COPING
SCALE: 1-1/2" = 1'-0"

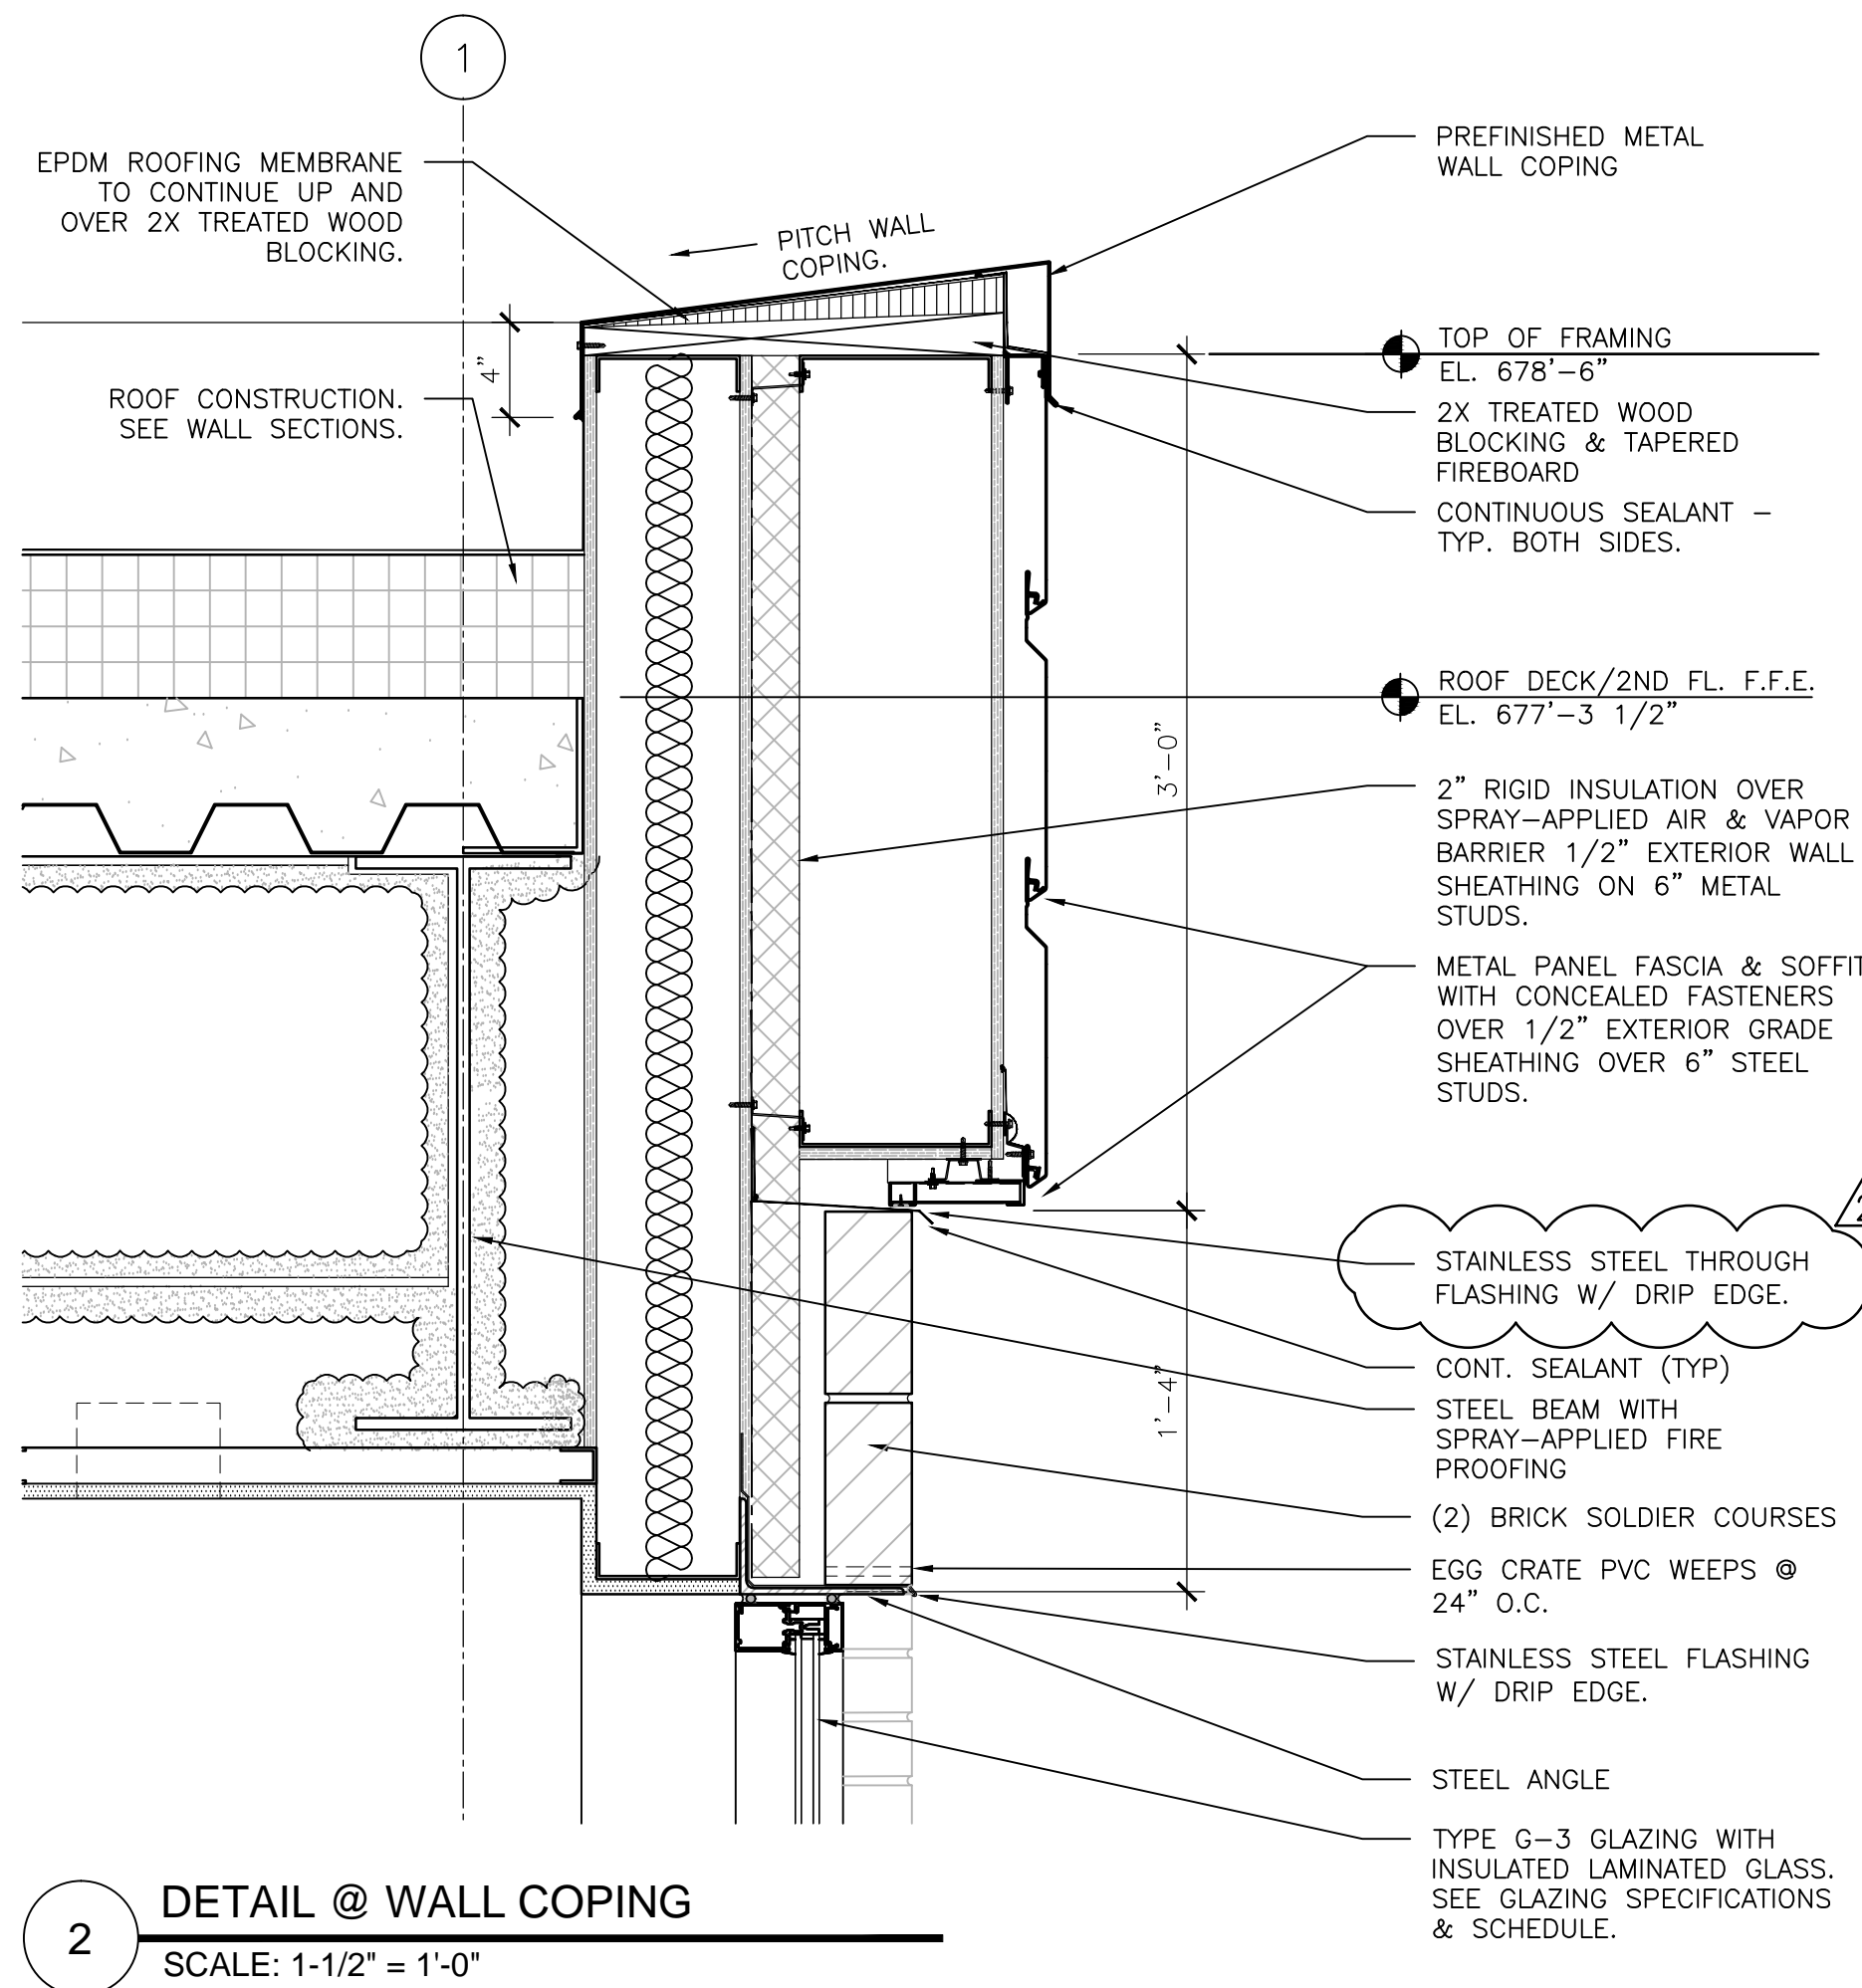


2 DETAIL @ WALL COPING
SCALE: 1-1/2" = 1'-0"

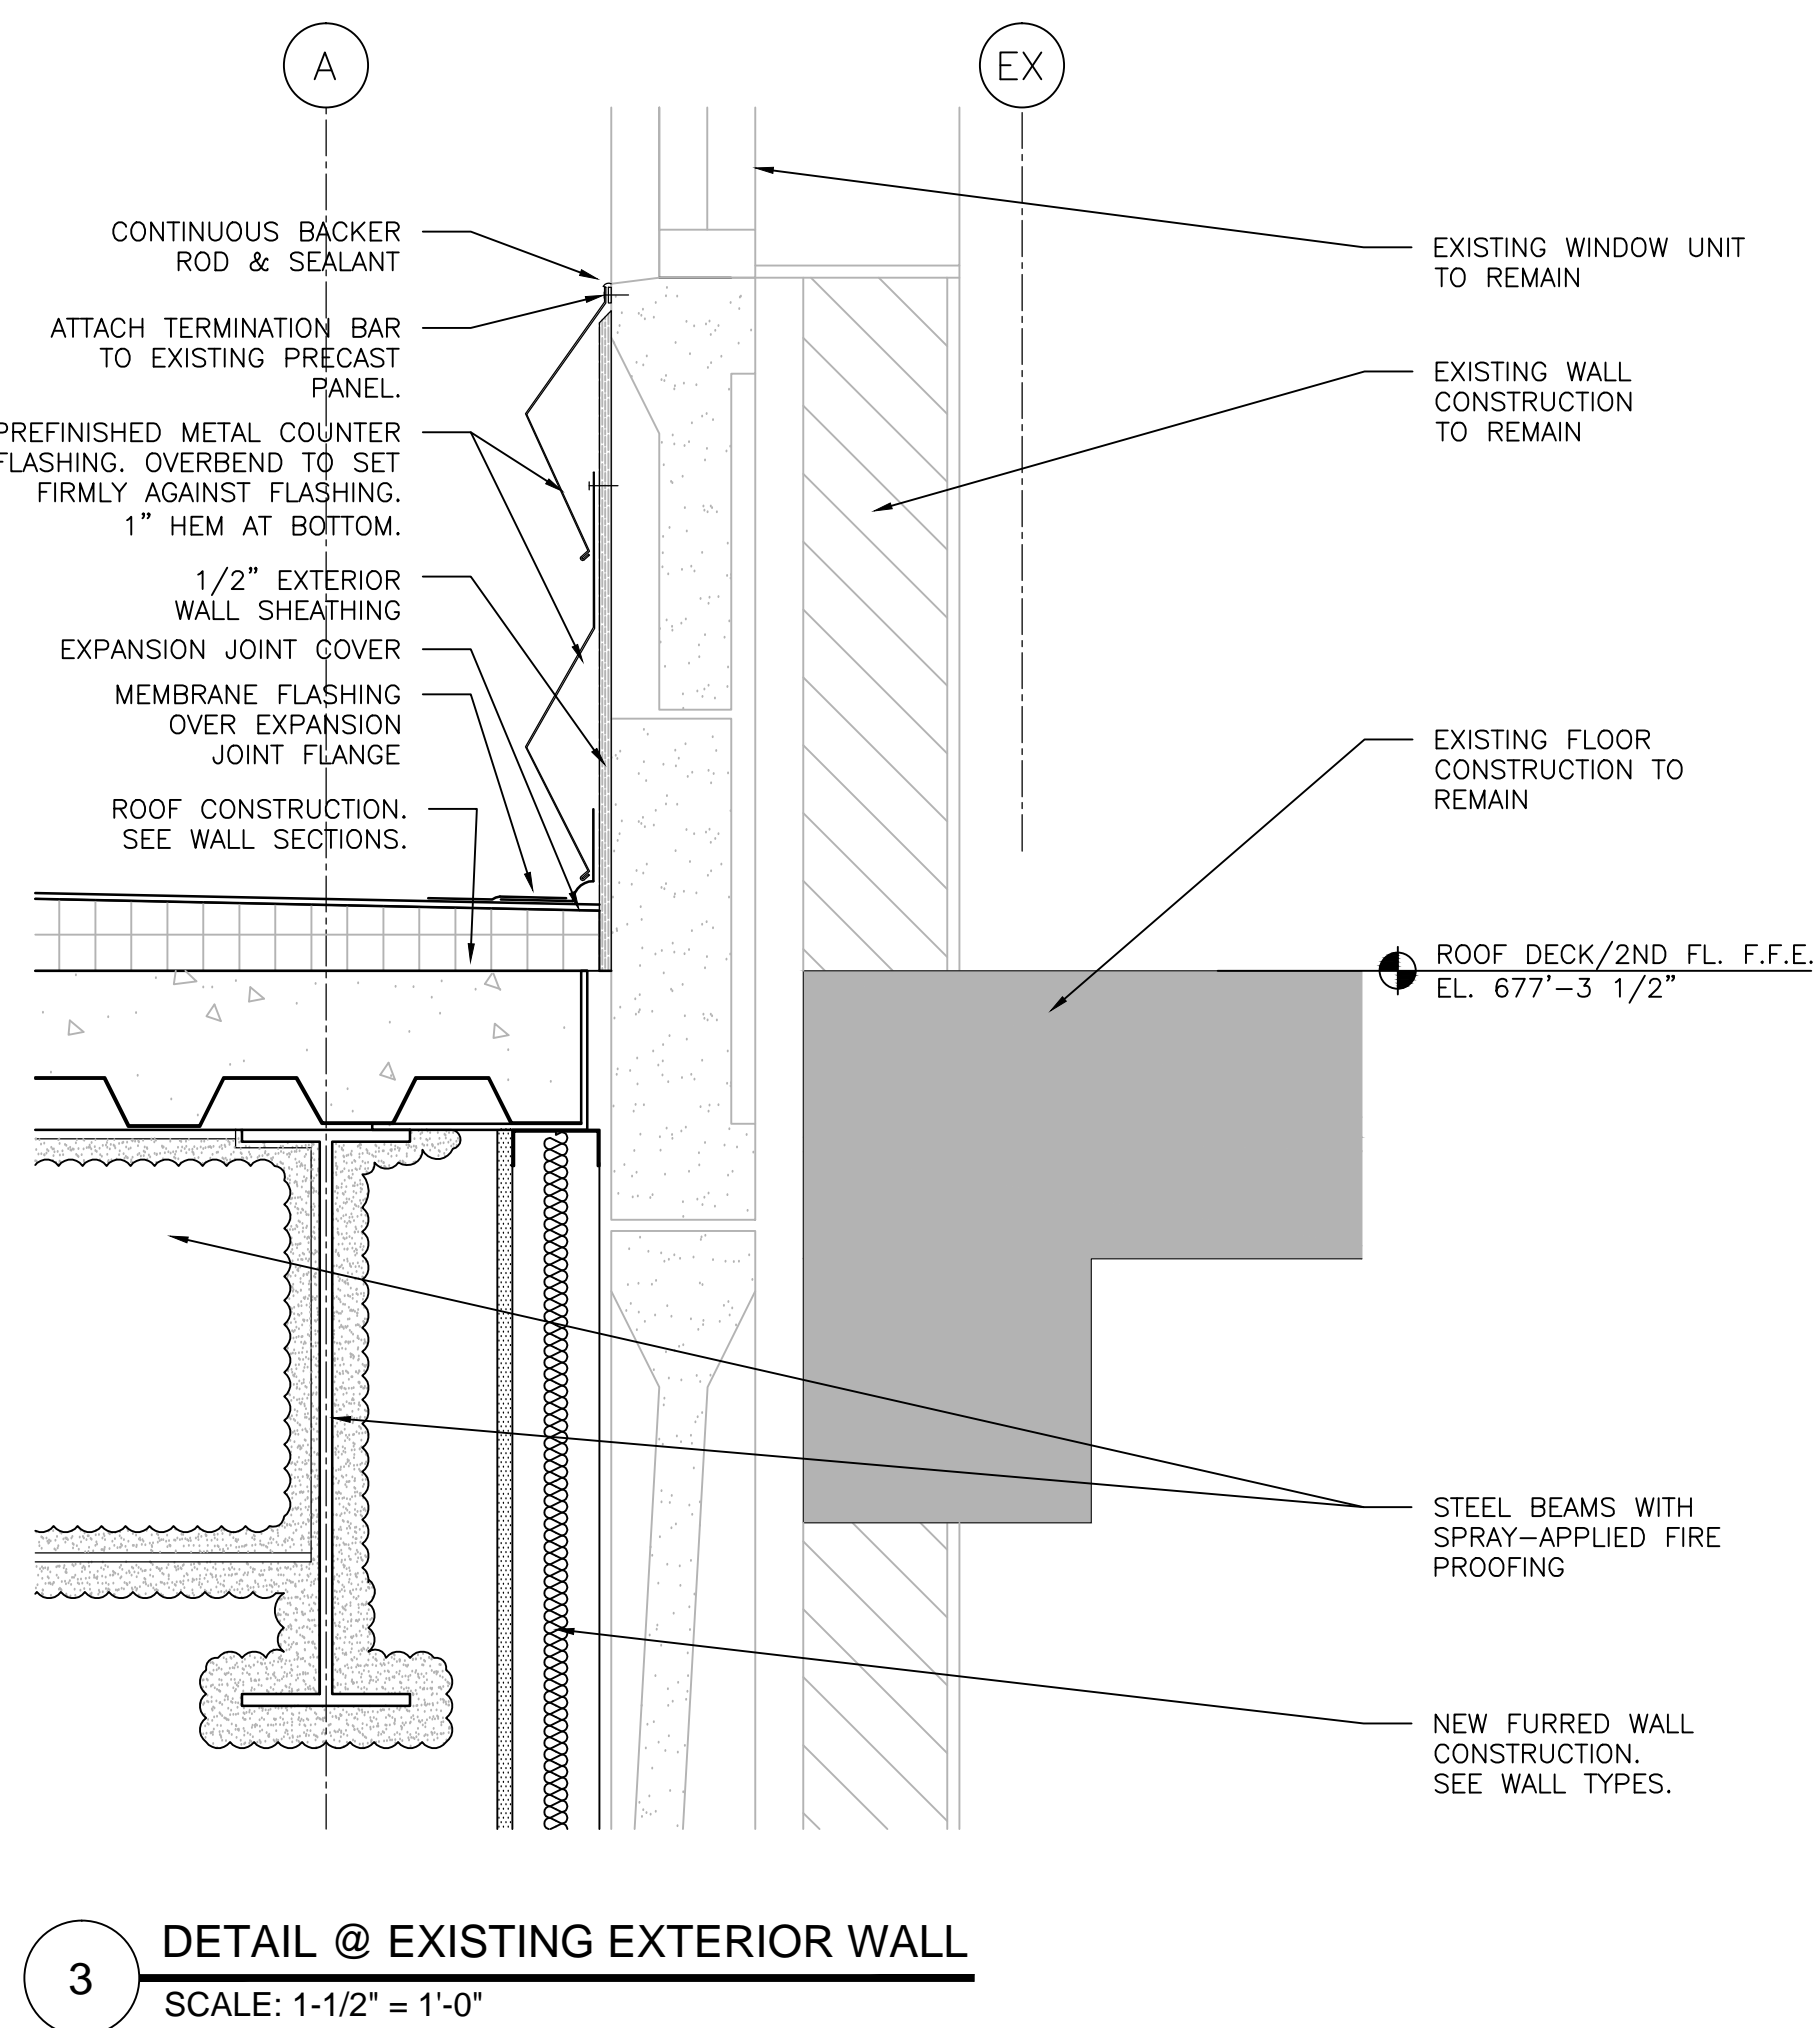

3 DETAIL @ EXISTING EXTERIOR WALL
SCALE: 1-1/2" = 1'-0"

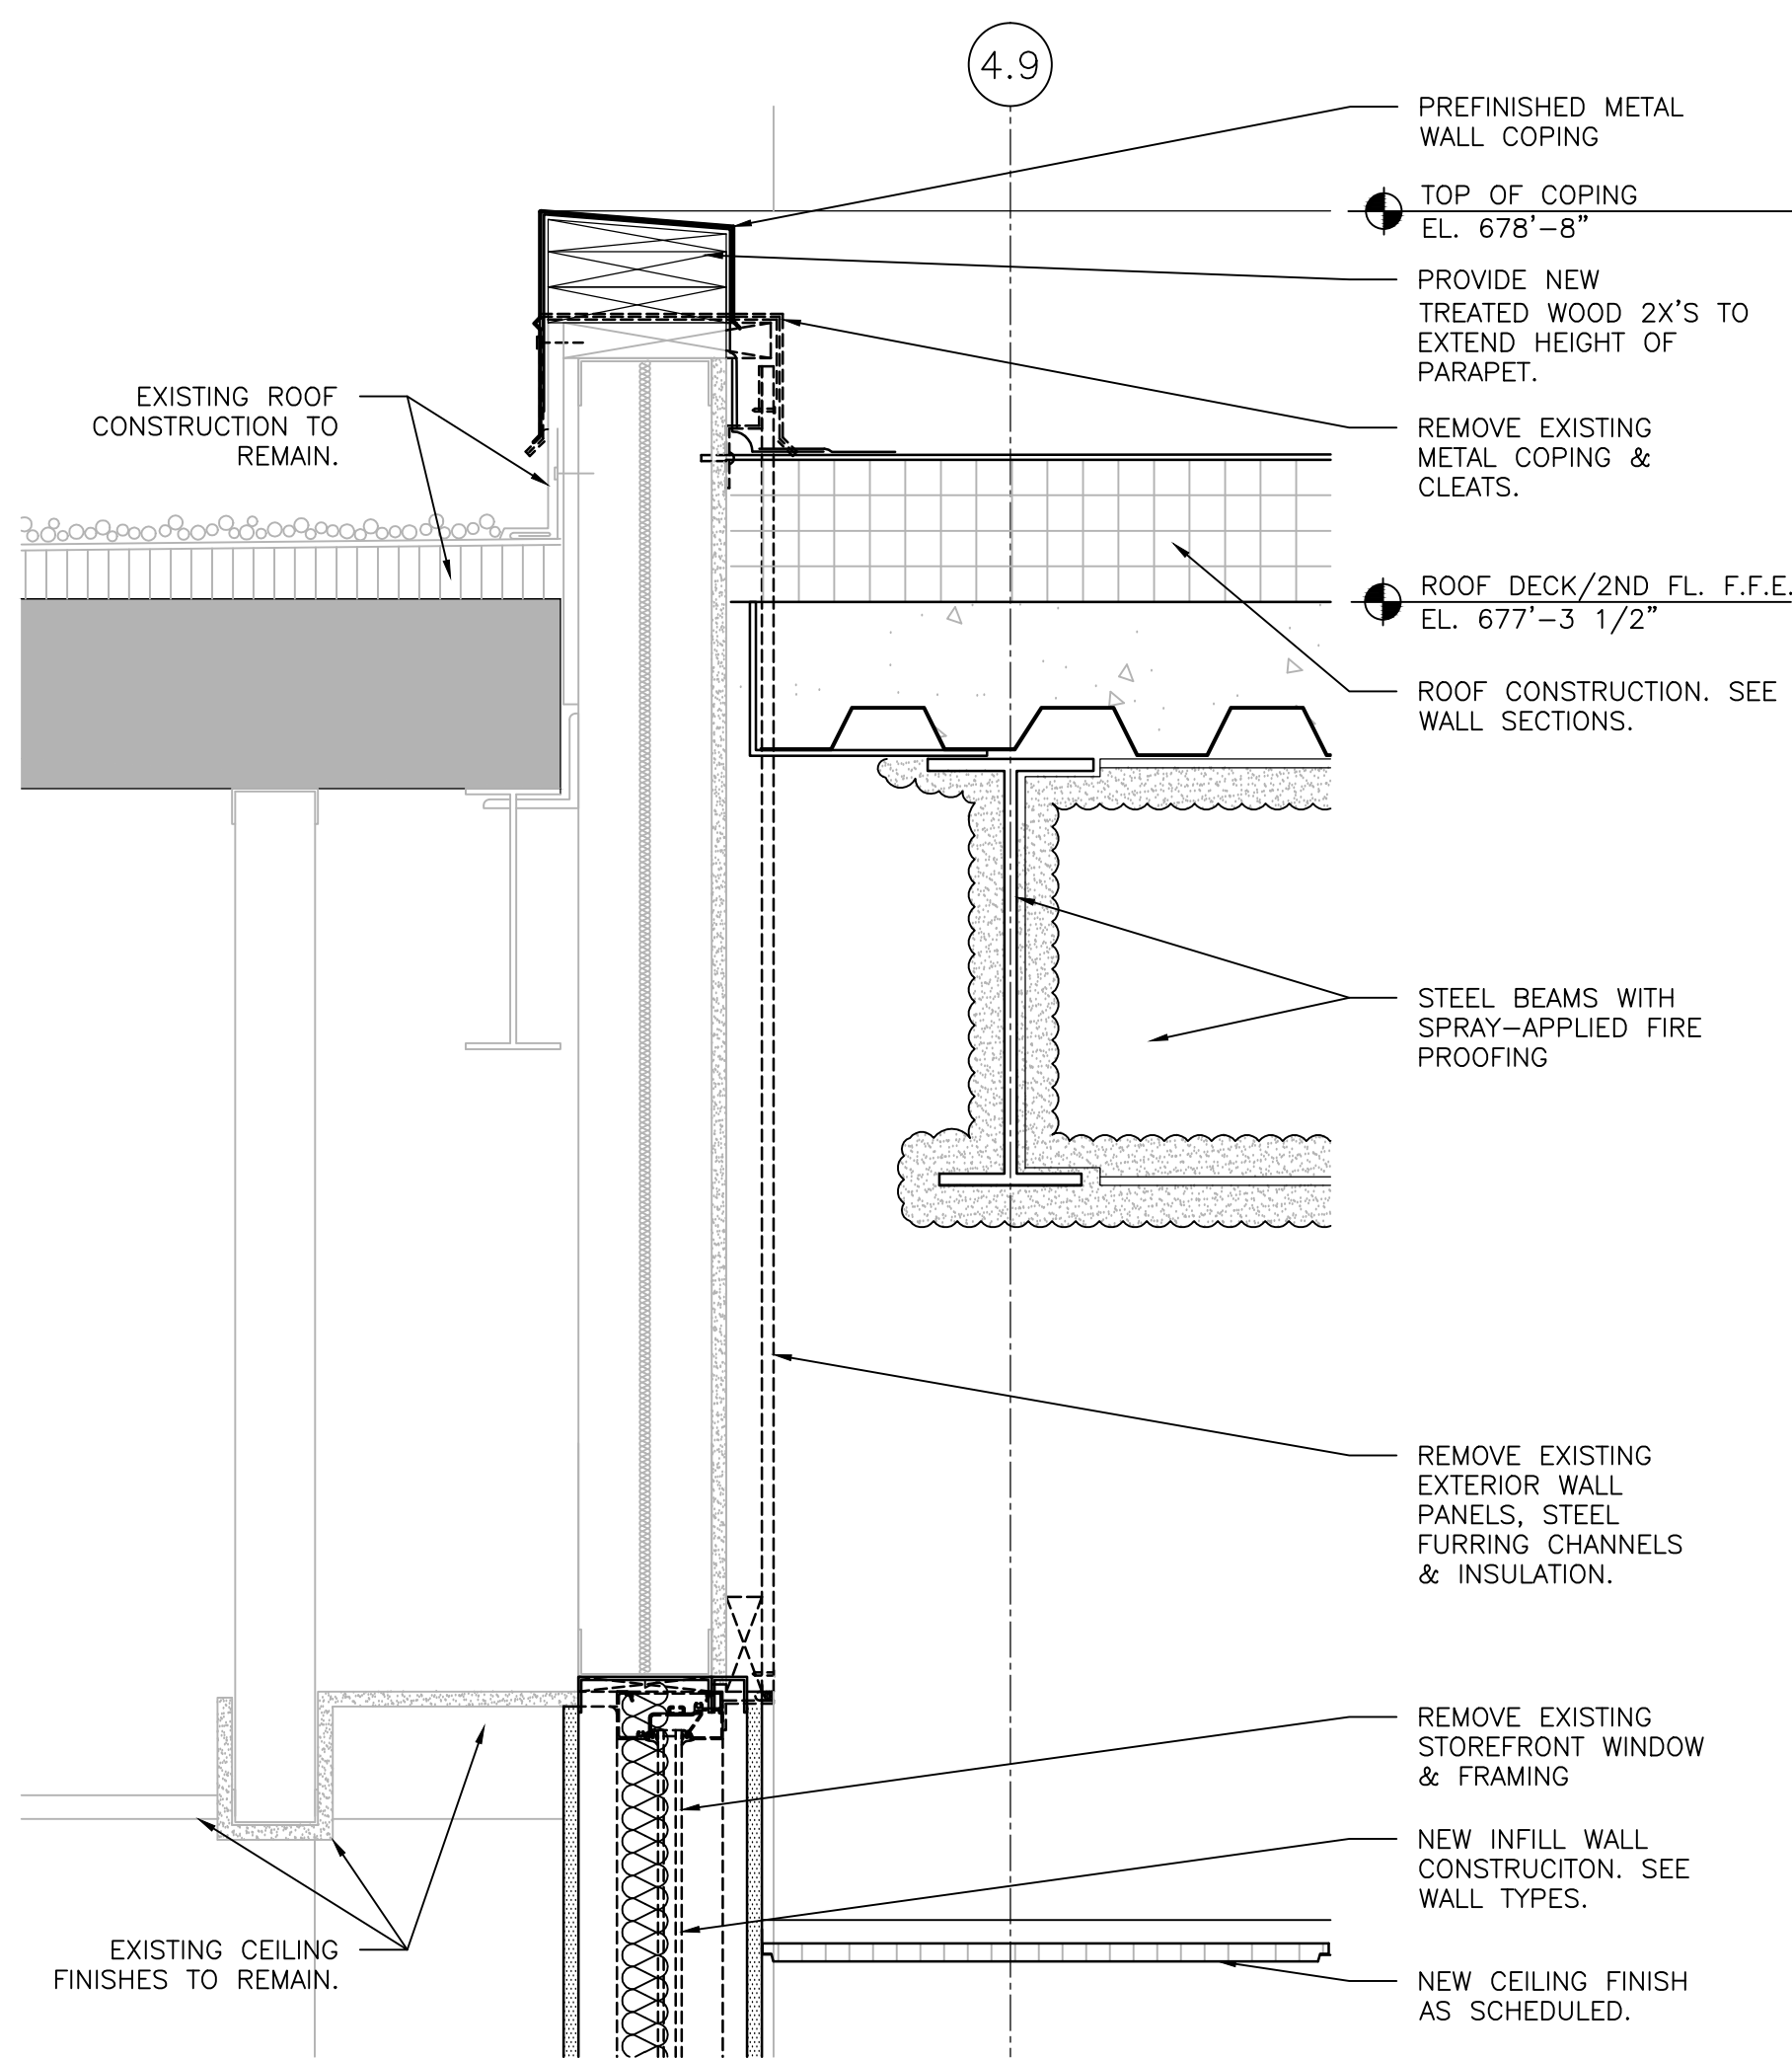

4 DETAIL @ EXISTING EXTERIOR WALL
SCALE: 1-1/2" = 1'-0"

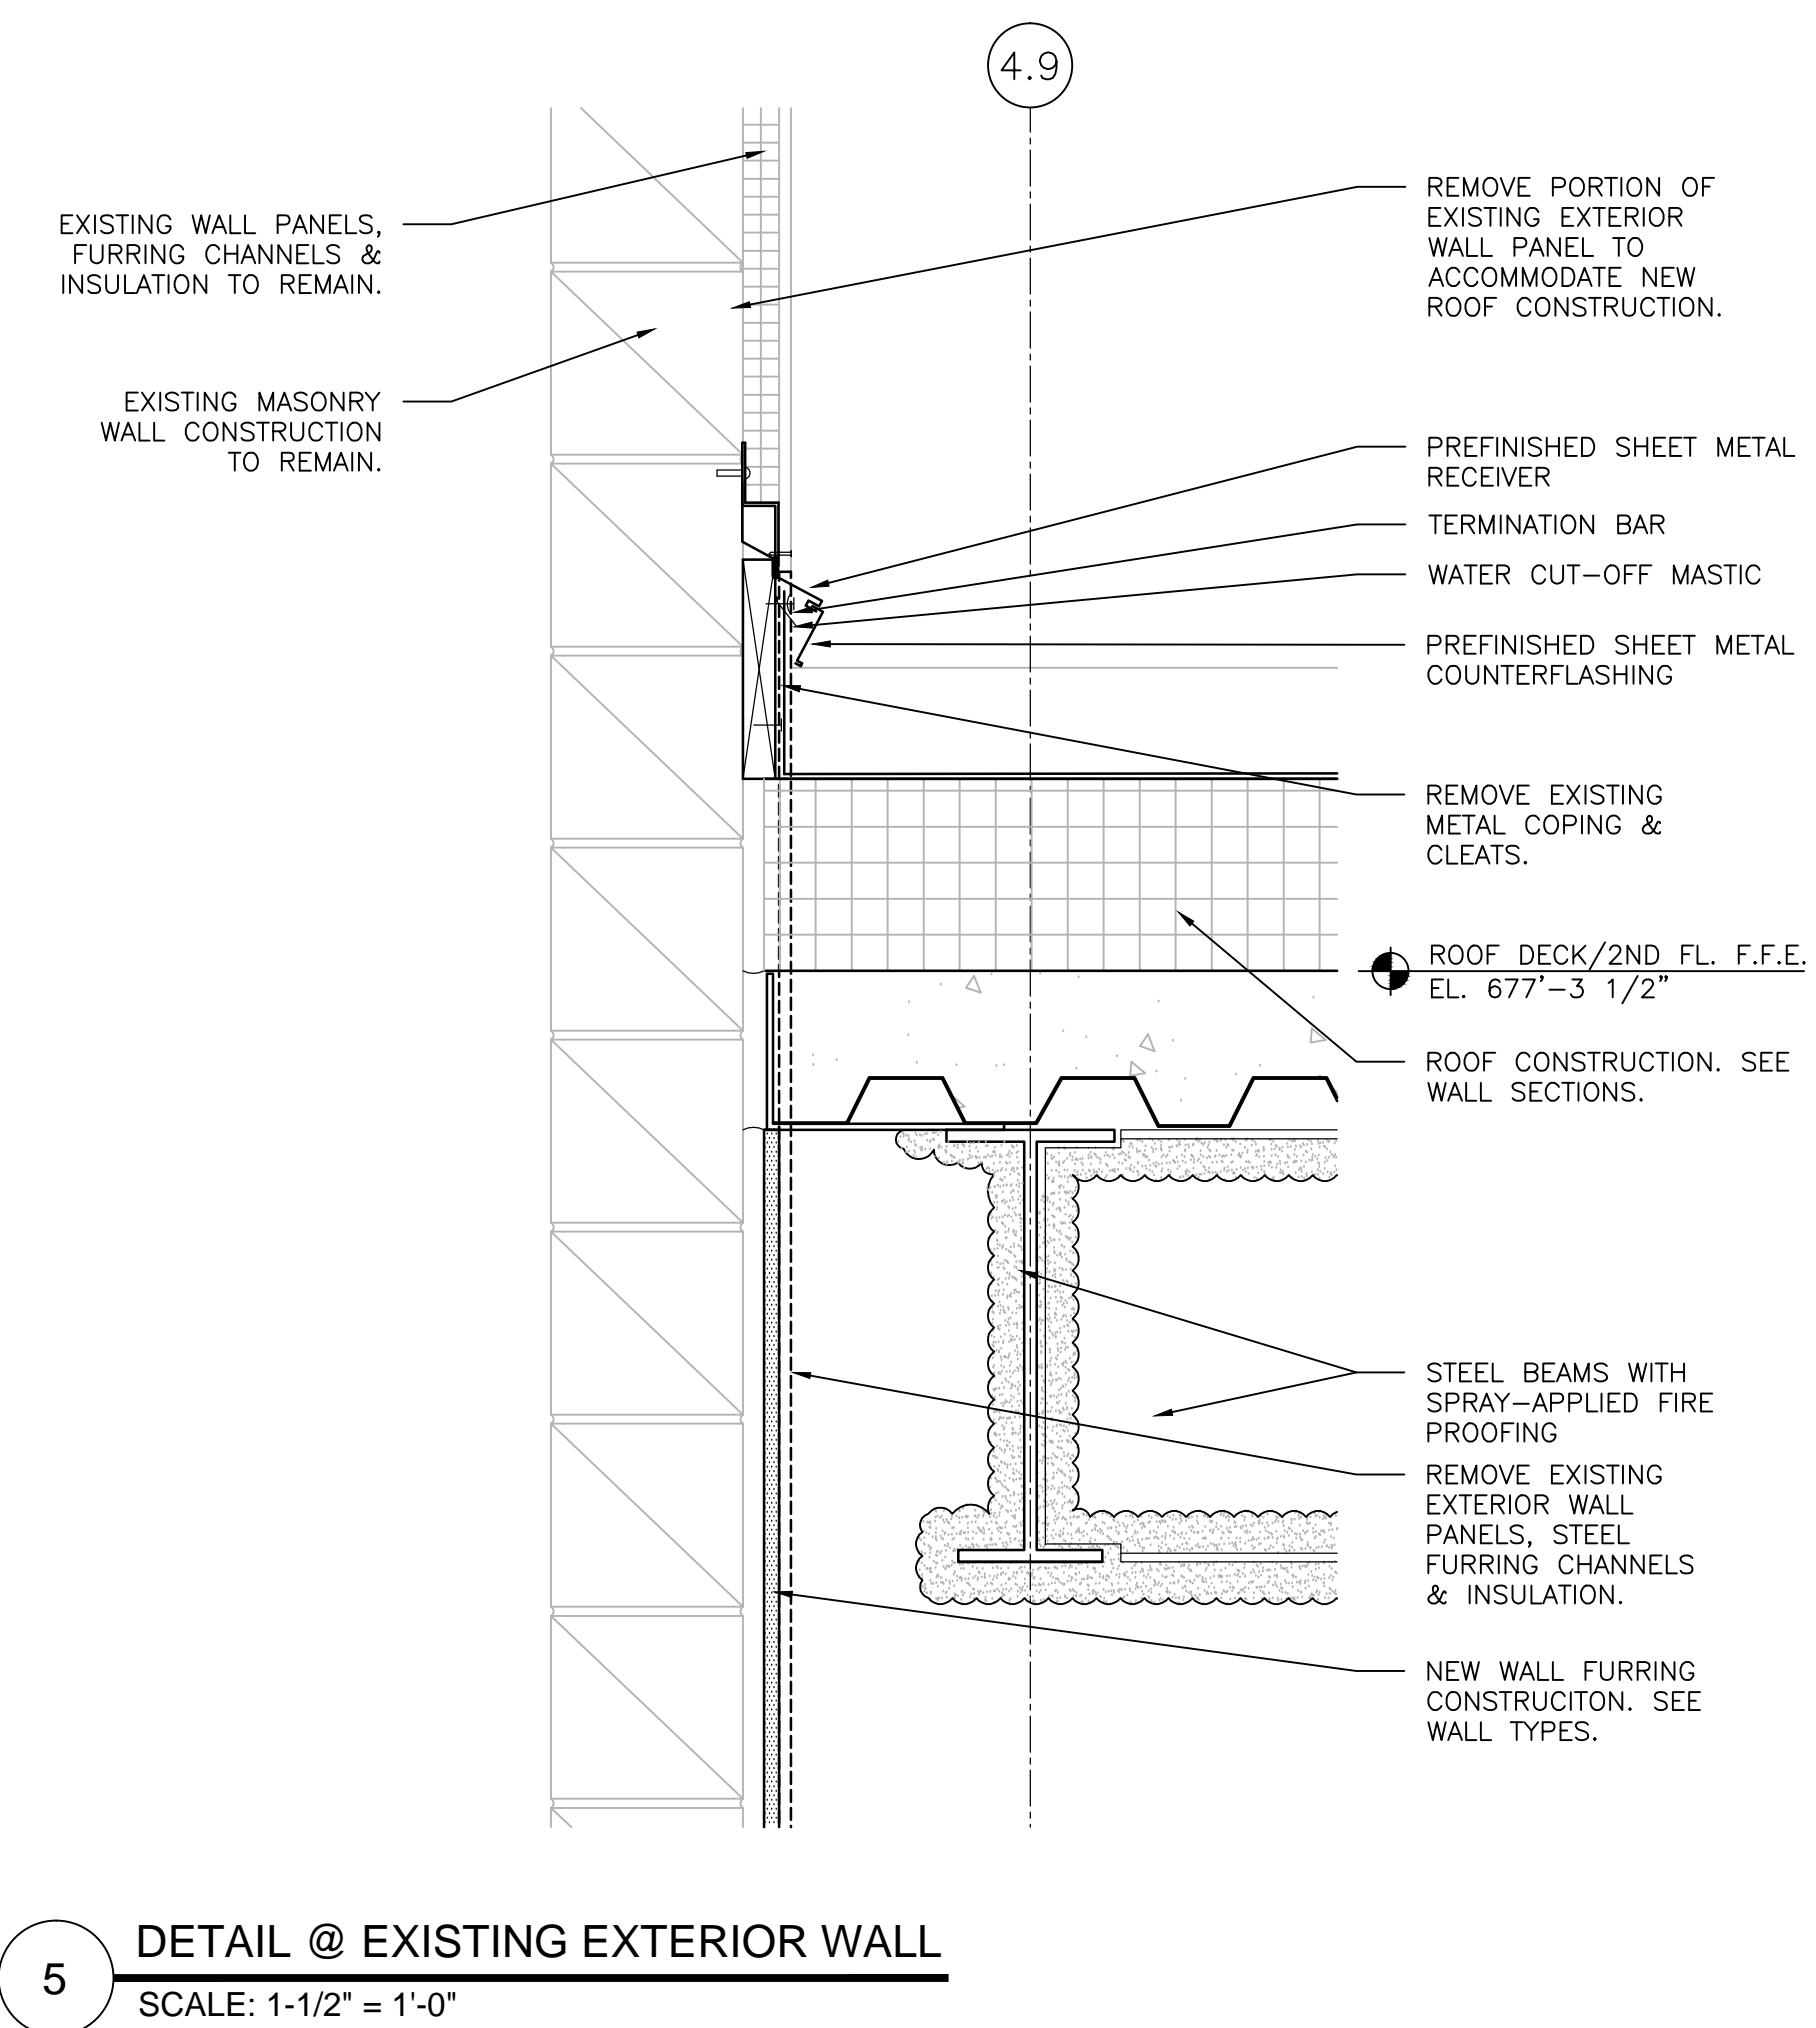


5 DETAIL @ EXISTING EXTERIOR WALL
SCALE: 1-1/2" = 1'-0"

Amendment #2	7-19-16
Revisions:	Date



Department of Veterans Affairs
Medical Center
5000 W. National Avenue
Milwaukee, WI

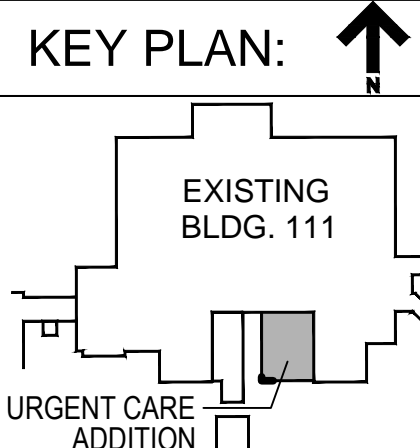

CONSULTANTS:
PCG
THE SIGMA GROUP
R.A. Smith National
Lerdahl

PROJECT LEADER:
Chequamegon
309 N. WATER ST.
SUITE 650
MILWAUKEE, WI 53202
PHONE: (414) 258-6004

Drawing Title DETAILS
Approved: Project Director

Project Title 111 EXPAND URGENT CARE
Location: VA Medical Center, Milwaukee, WI
Date January 28th, 2016
Checked By: KAB
Drawn By: KAB

Project Number 695-402
Building Number 111
Drawing Number A505

Office of
Facilities
Management
Department of
Veterans Affairs