

A

B

C


D

E


F

G


three inches = one foot
one and one half inches = one foot
one inch = one foot
three quarters inch = one foot
one half inch = one foot
three eighths inch = one foot
one quarter inch = one foot
one eighth inch = one foot

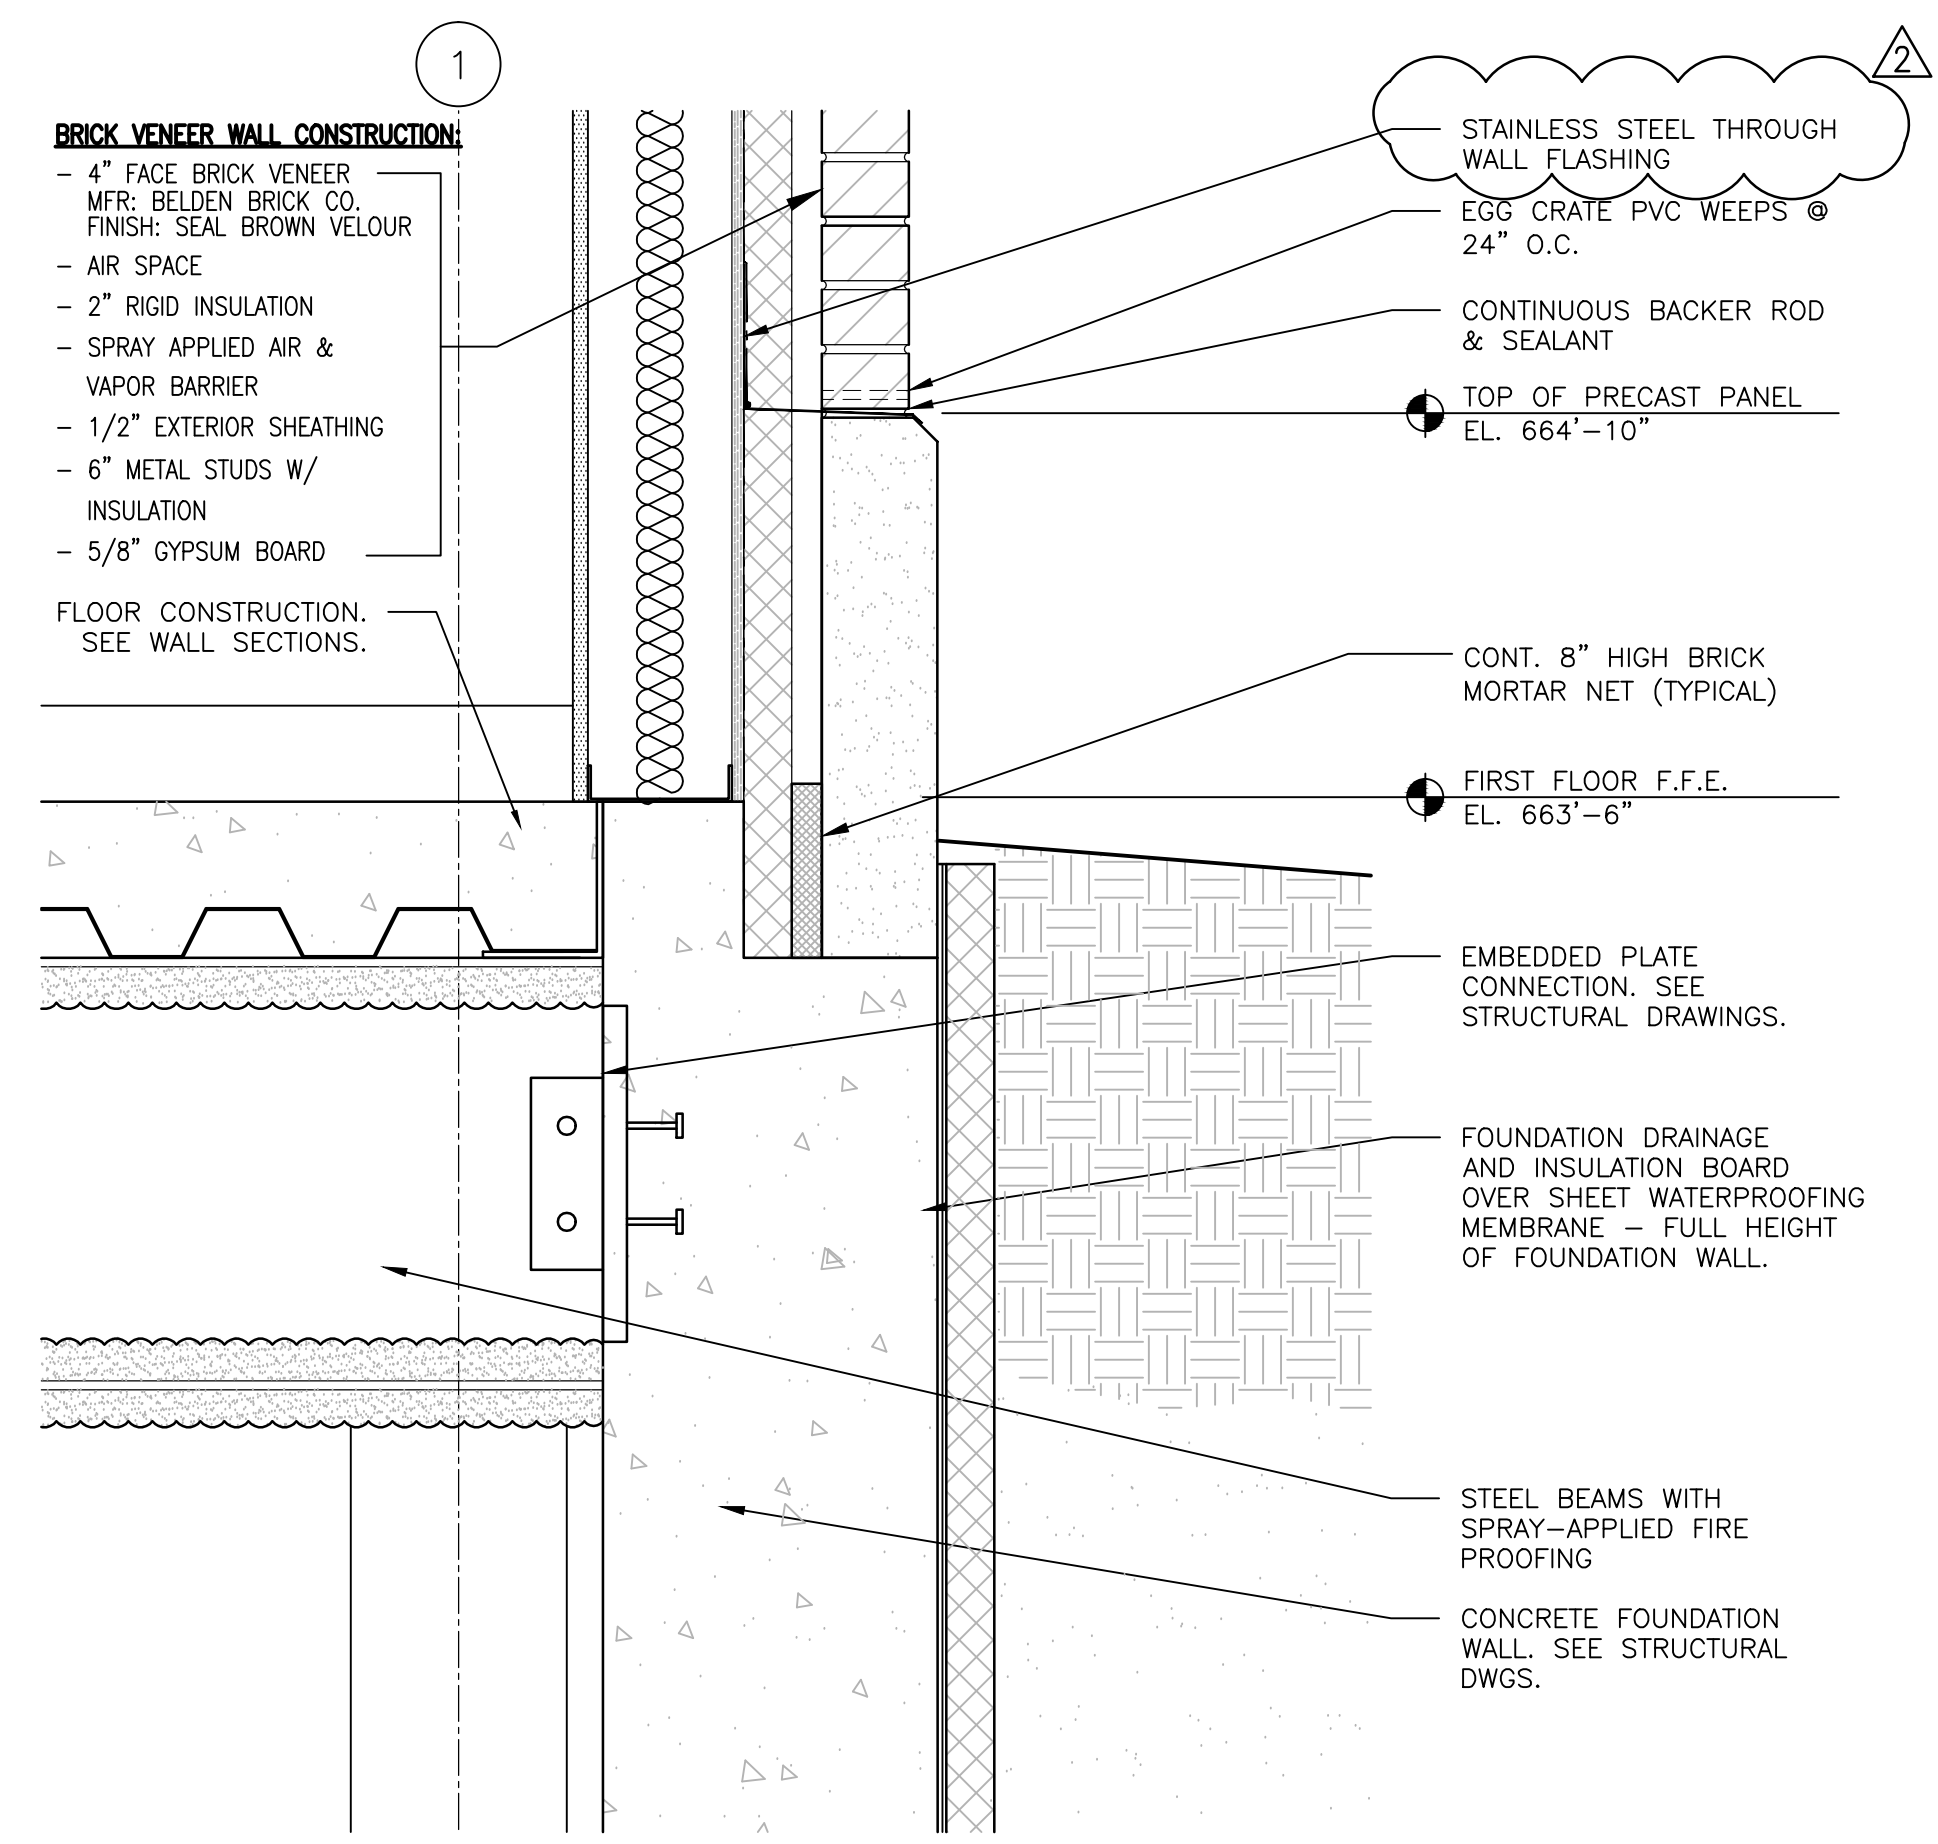


1 DETAIL @ WALL BASE
SCALE: 1-1/2" = 1'-0"

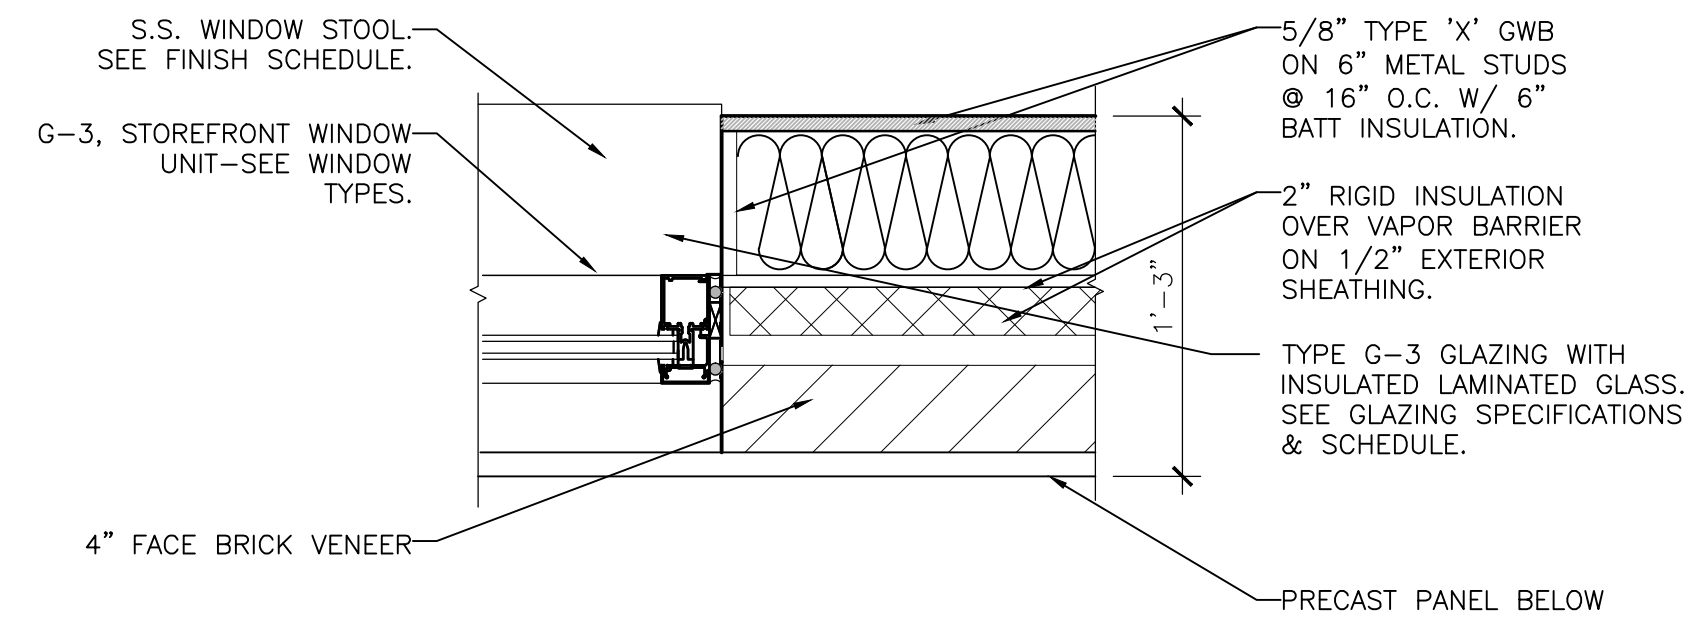

4 PLAN DETAIL @ WINDOW JAMB
SCALE: 1-1/2" = 1'-0"

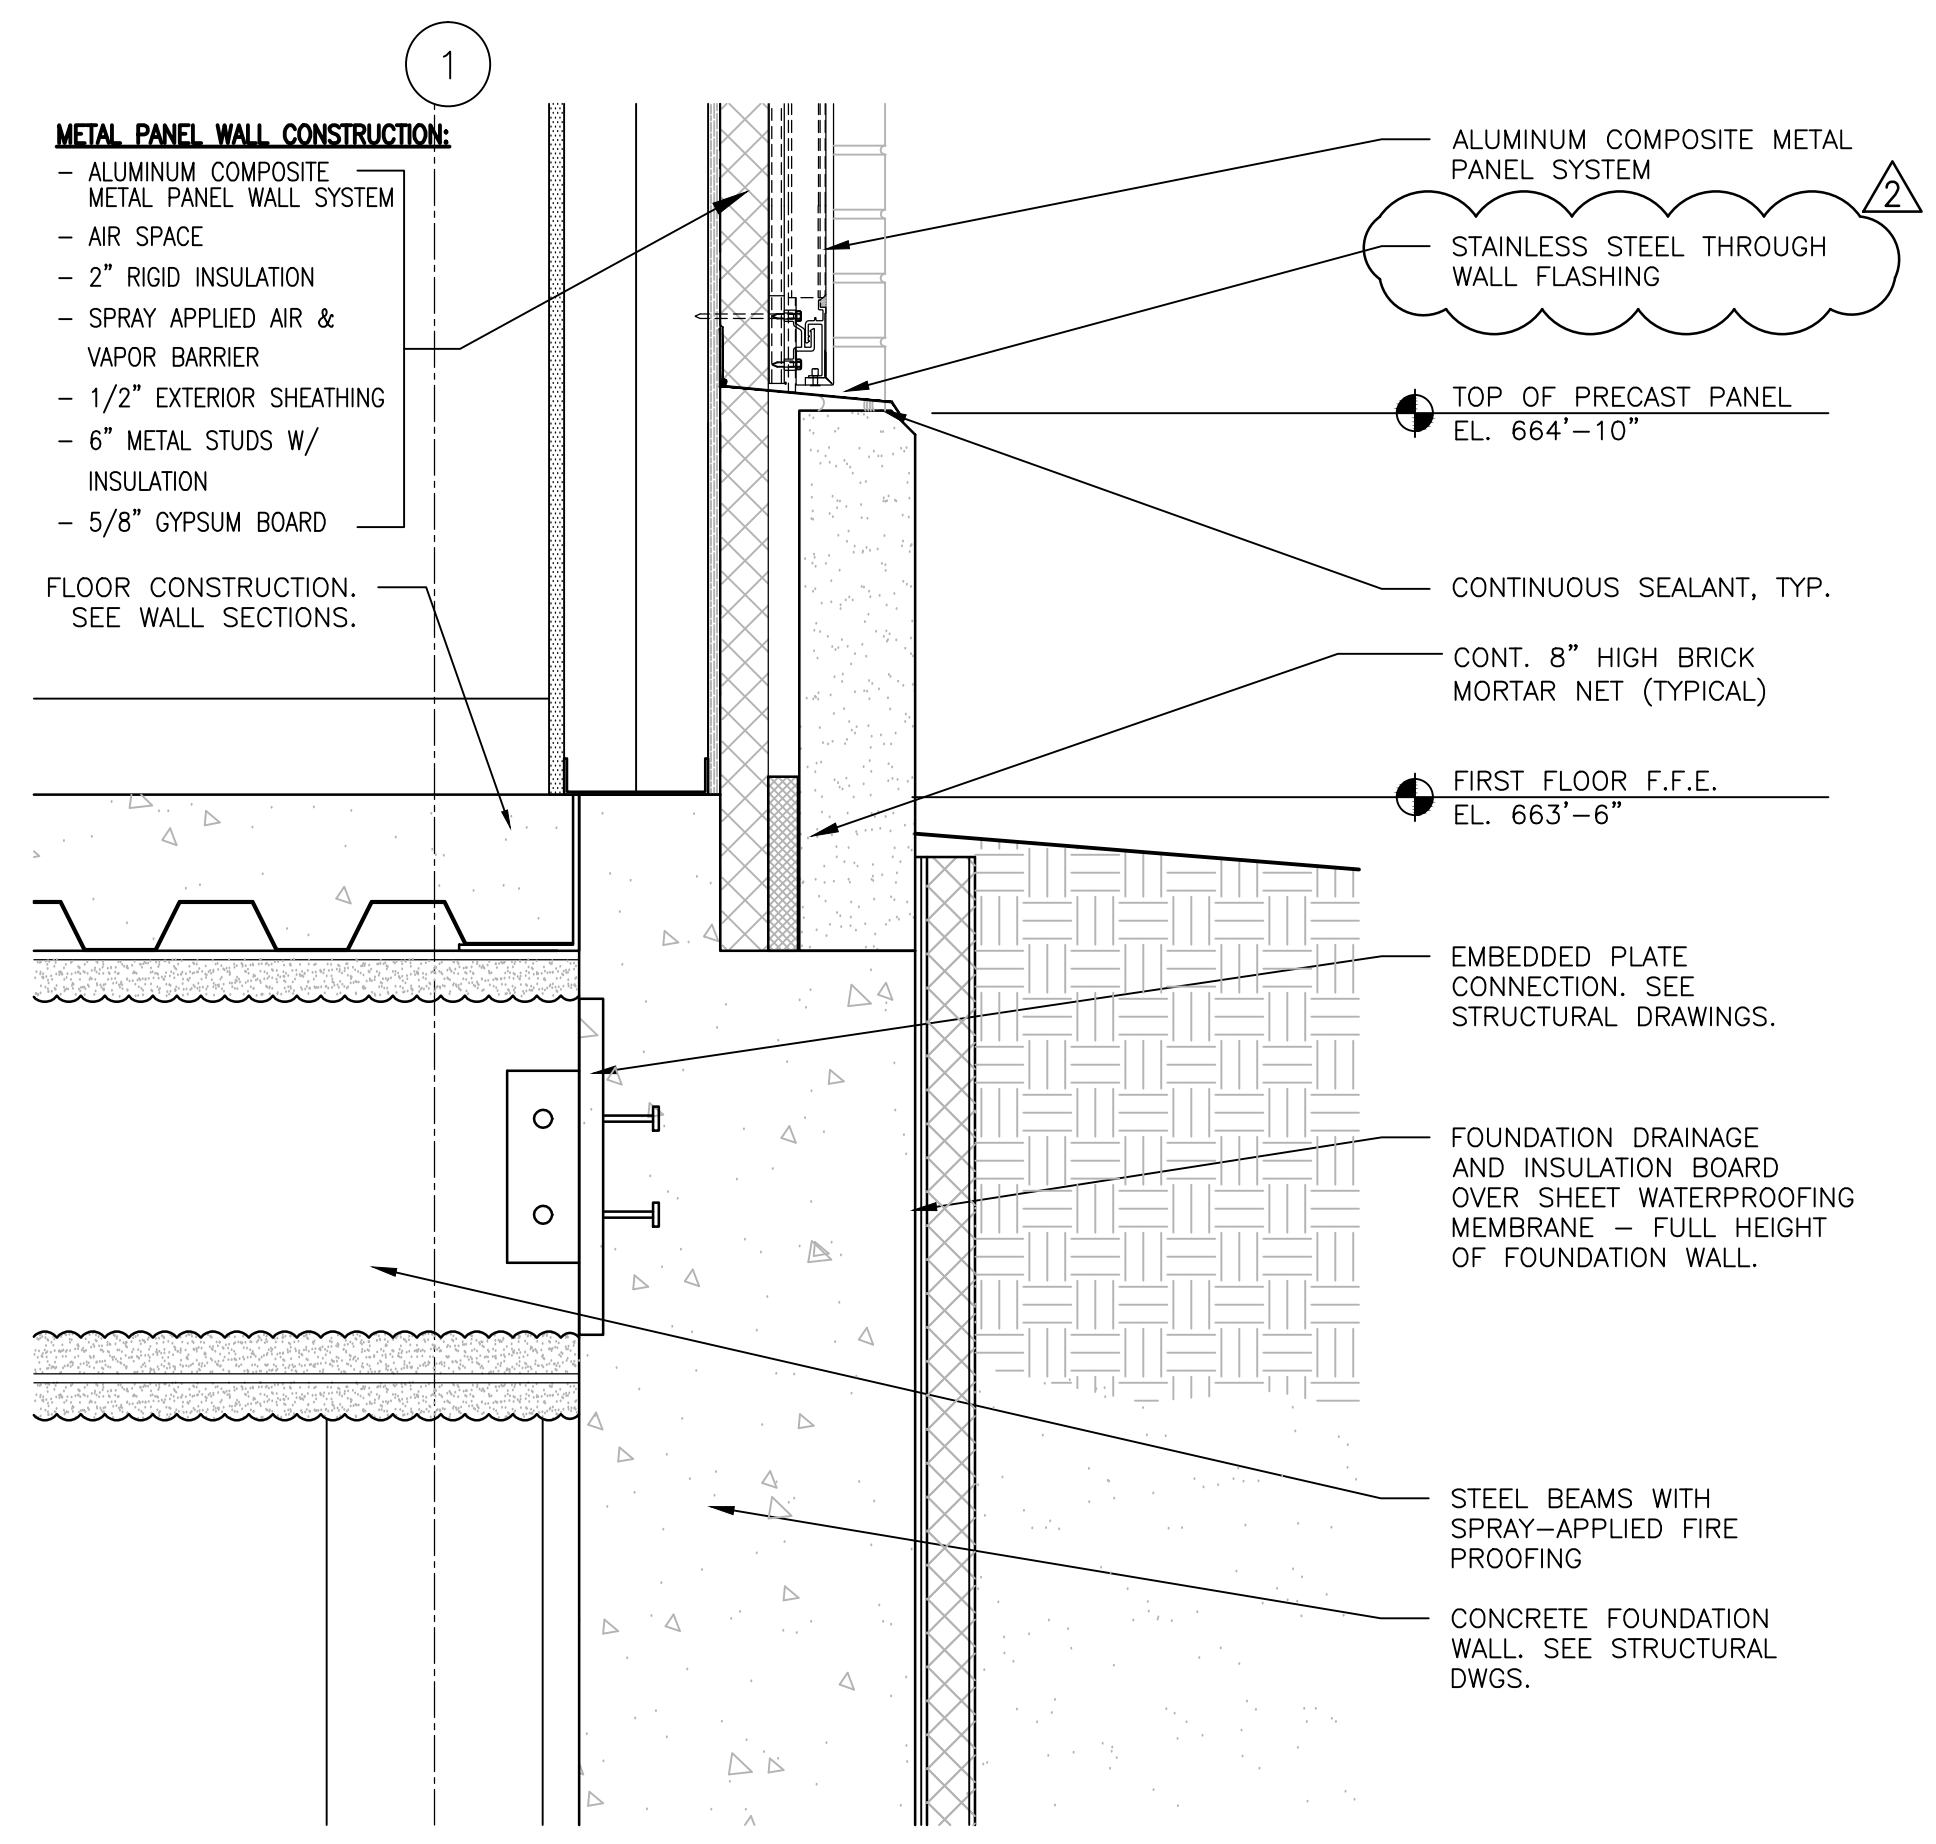


2 DETAIL @ WALL BASE
SCALE: 1-1/2" = 1'-0"

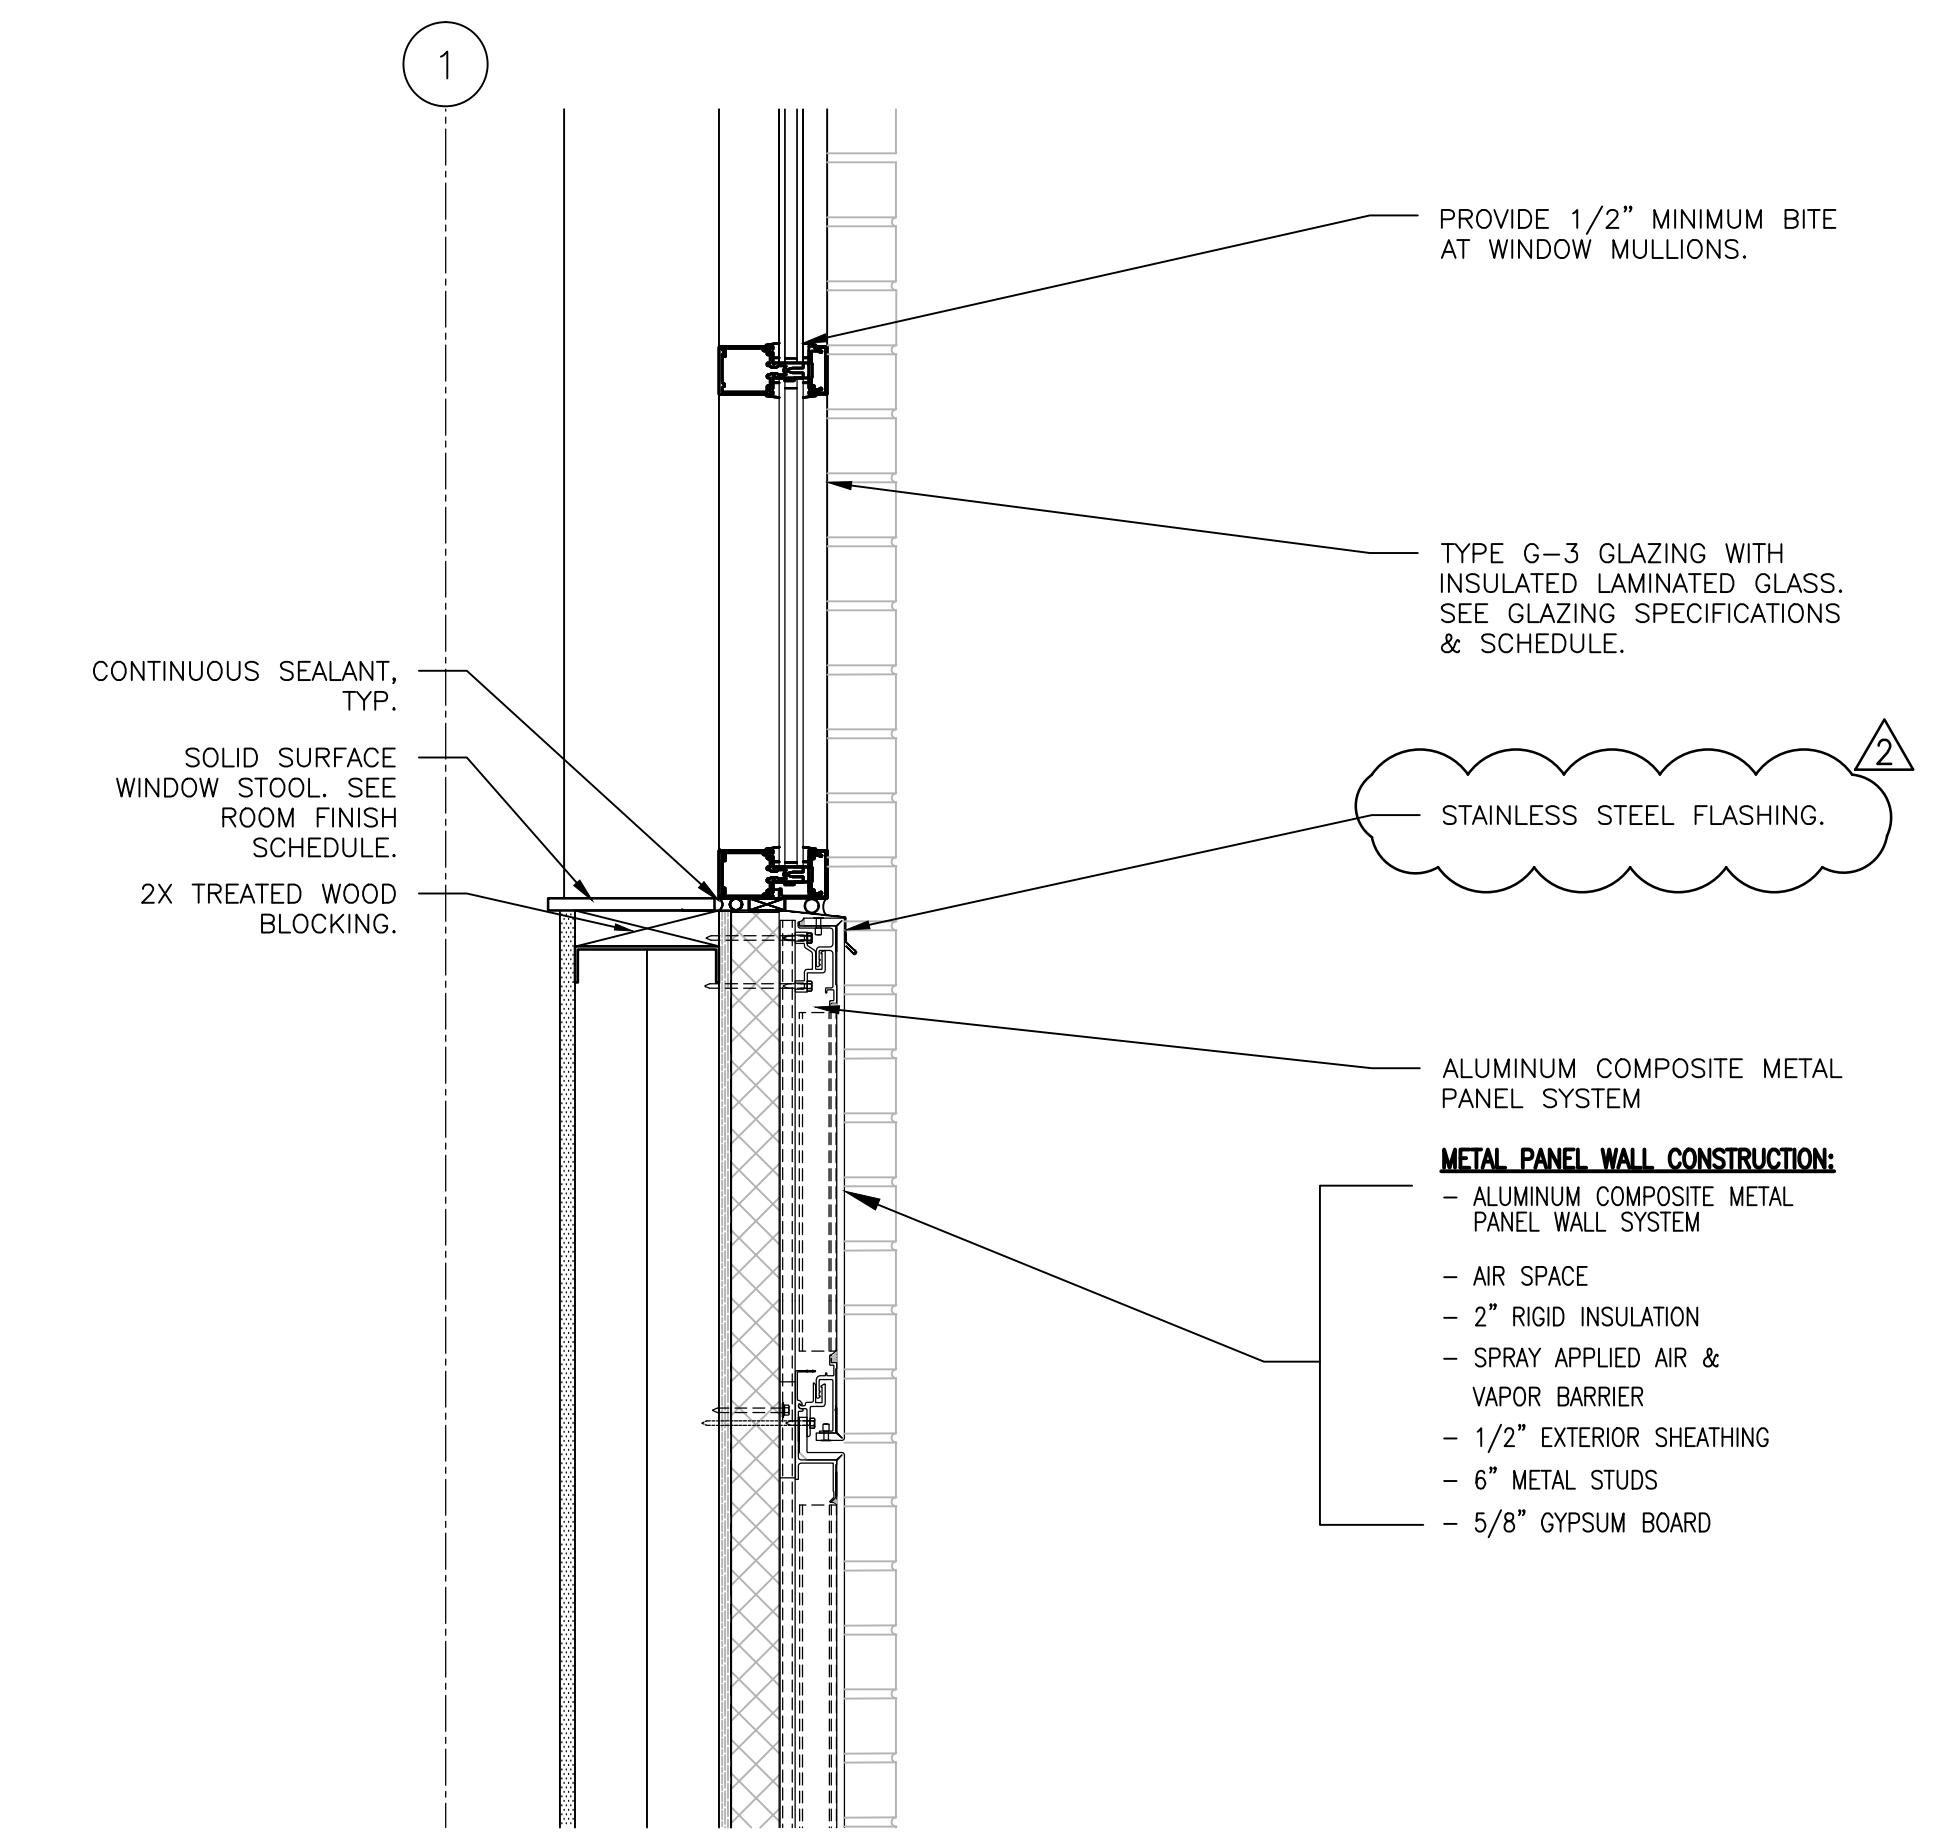


3 DETAIL @ WALL BASE
SCALE: 1-1/2" = 1'-0"

Amendment #2	7-19-16
Revisions:	Date

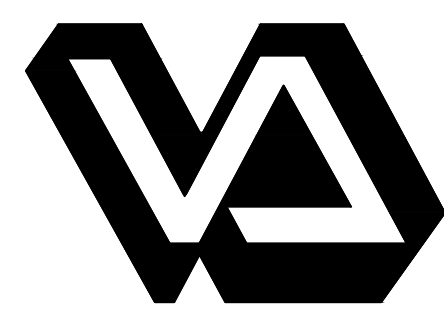

Department of Veterans Affairs
Medical Center
5000 W. National Avenue
Milwaukee, WI

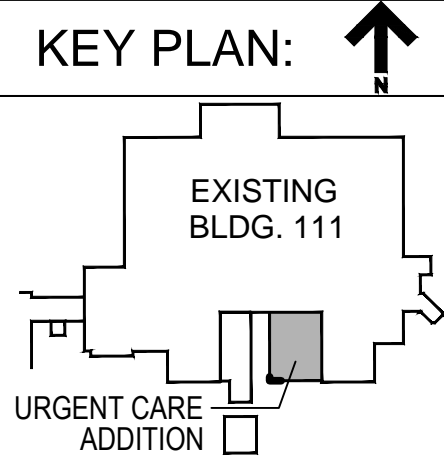

CONSULTANTS:

PCG
DESIGN / BUILD SERVICES

R.A. Smith
National

THE SIGMA GROUP

Lerdahl

PROJECT LEADER:

Chequamegon
BAY GROUP, INC.

309 N. WATER ST.
SUITE 650
MILWAUKEE, WI 53202
PHONE: (414) 258-6004

Drawing Title DETAILS	Project Title 111 EXPAND URGENT CARE	Project Number 695-402	Office of Facilities Management
Approved: Project Director	Location: VA Medical Center, Milwaukee, WI	Building Number 111	
Date January 28th, 2016	Checked By: KAB	Drawn By: KAB	
Drawing Number A506			Department of Veterans Affairs