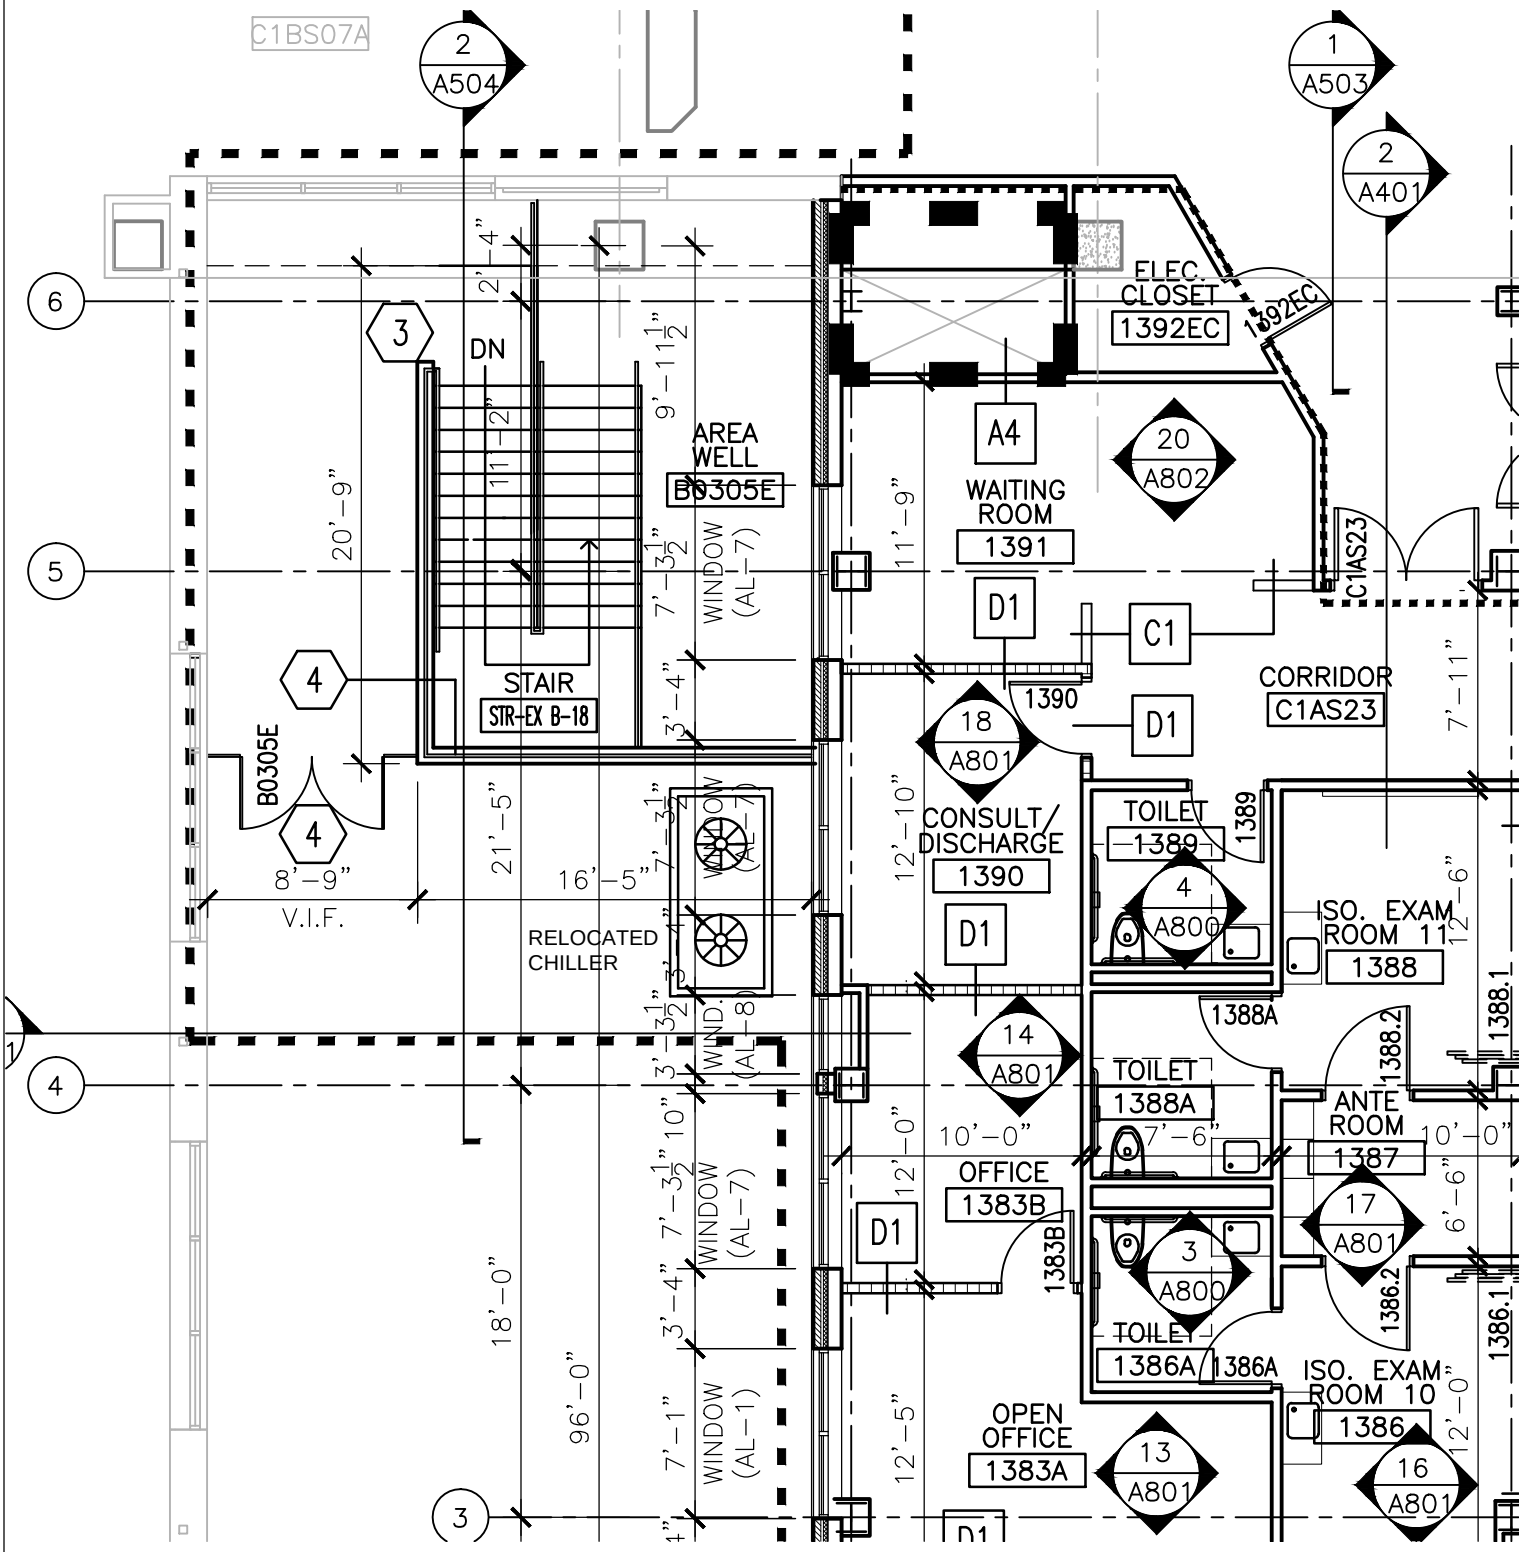

PARTIAL FIRST FLOOR PLAN
BID DEDUCT #5
REDUCED AREA WELL

ISSUED BY: Chequamegon Bay Group, Inc. ASHLAND, WI • MILWAUKEE, WI • DULUTH, MN WWW.CHEQBAYGRP.COM	Department of Veterans Affairs Medical Center 5000 W. National Avenue Milwaukee, WI	Issued For: Reference Drawing No: Scale: As Shown Issue Date:	PRE-BID RFI A101 7/13/16
	Project Name: 111 Expand Urgent Care Project No.: 695-402		PRE-BID RFI DRAWING #2