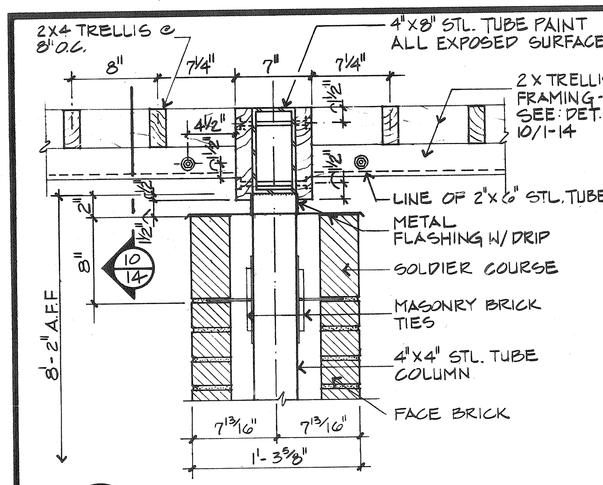

1/14 TRELLIS AT COLUMN
SCALE: 11/2" = 1'-0"

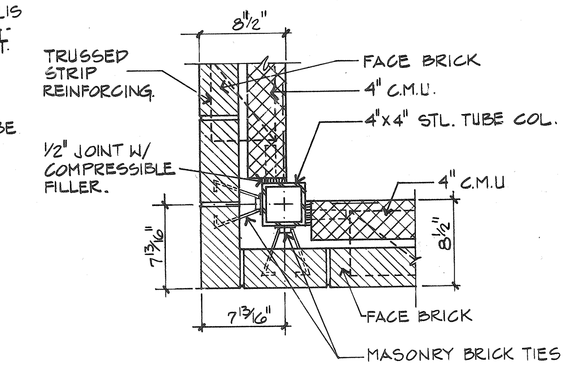

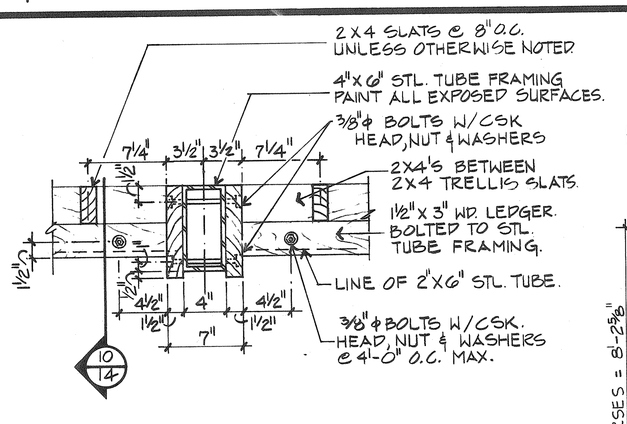

9/14 TRELLIS DETAIL
SCALE: 11/2" = 1'-0"

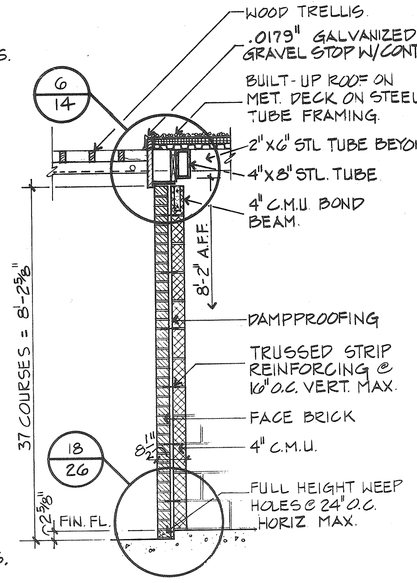

14/L4 WALL SECTION
SCALE: 1/2" = 1'-0"

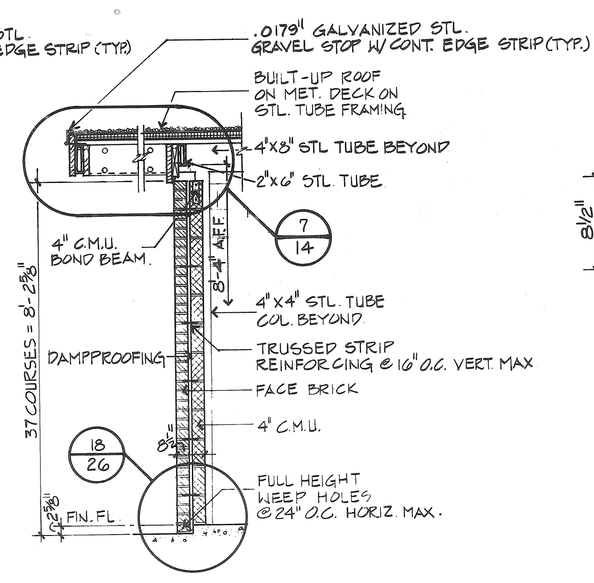

15/L4 WALL SECTION
SCALE: 1/2" = 1'-0"

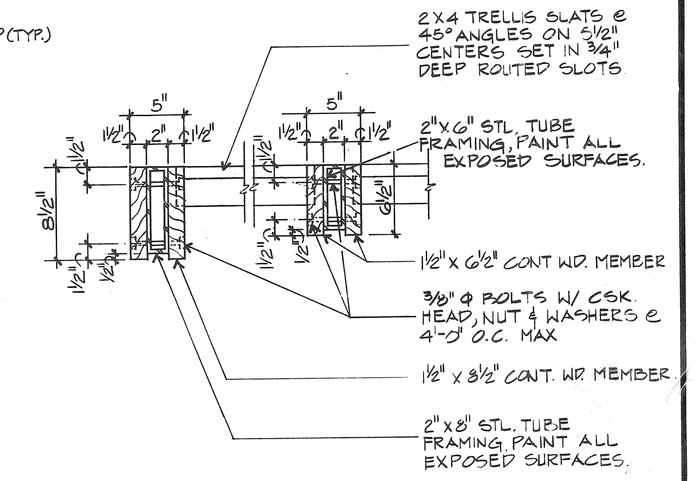

16/14 TRELLIS DETAIL
SCALE: 11/2" = 1'-0"

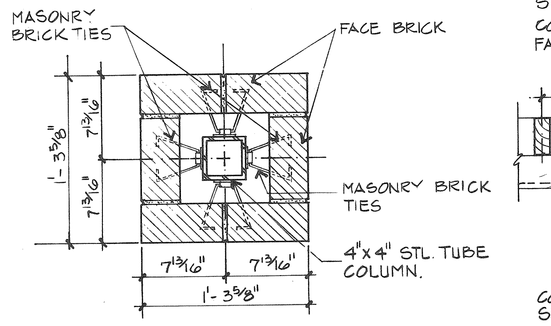

2/L4 COLUMN DETAIL
SCALE: 11/2" = 1'-0"

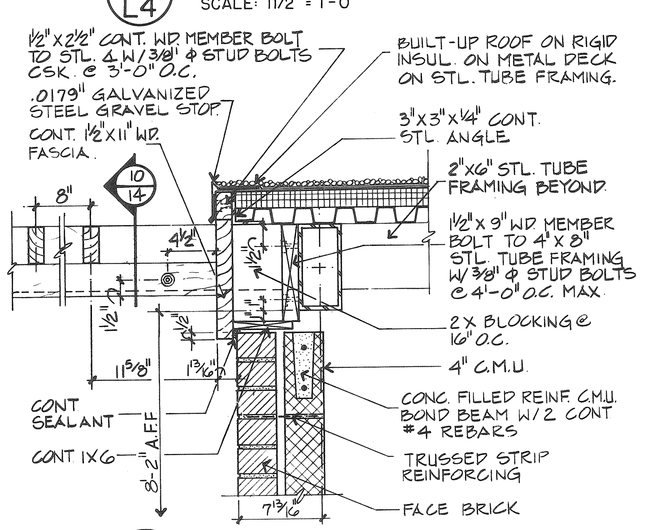

5/L4 COLUMN DETAIL
SCALE: 11/2" = 1'-0"

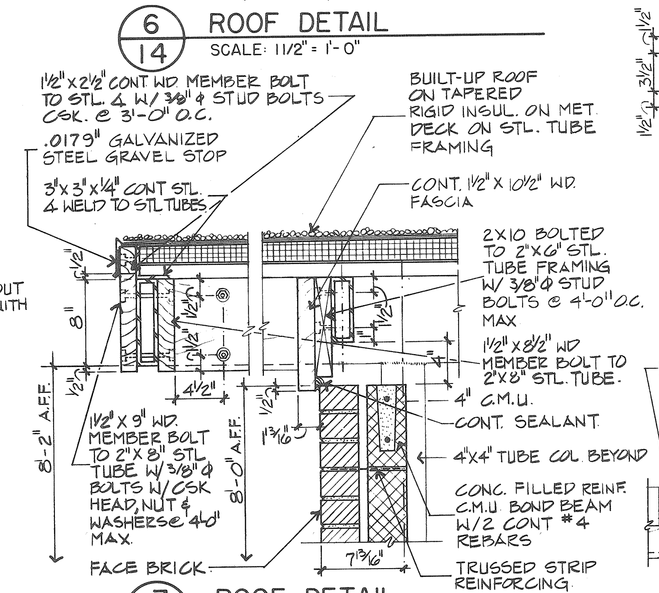

6/14 ROOF DETAIL
SCALE: 11/2" = 1'-0"

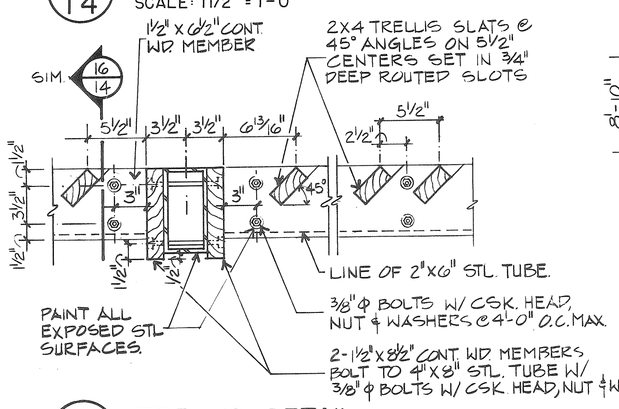

10/14 TRELLIS DETAIL
SCALE: 11/2" = 1'-0"

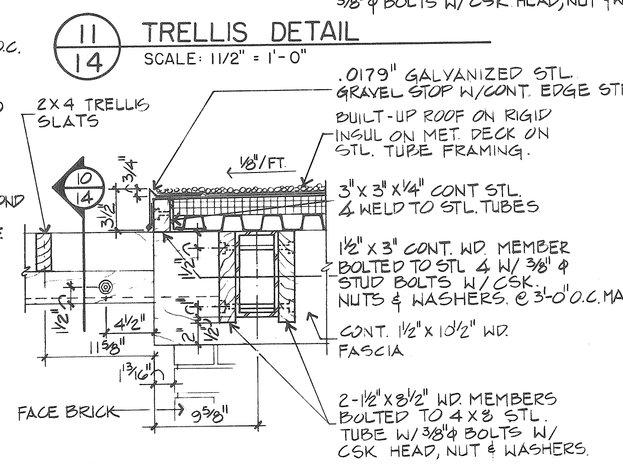

13/14 TRELLIS DETAIL
SCALE: 11/2" = 1'-0"

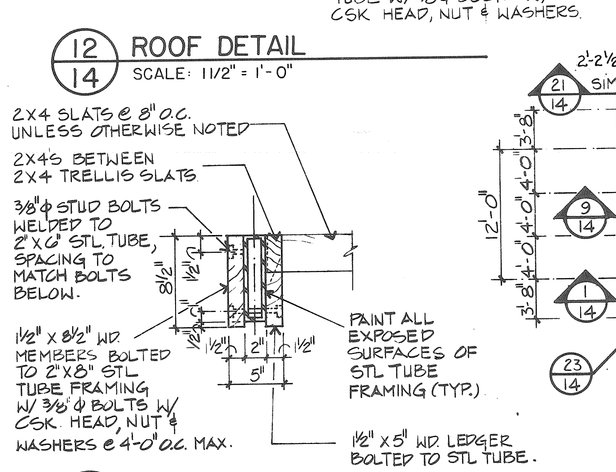

12/14 ROOF DETAIL
SCALE: 11/2" = 1'-0"

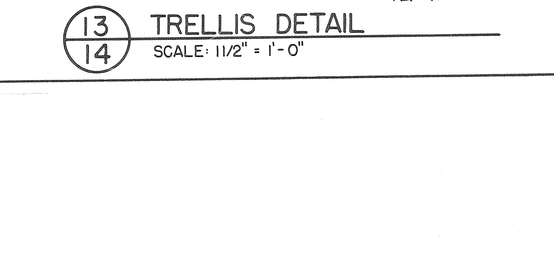

13/14 TRELLIS DETAIL
SCALE: 11/2" = 1'-0"

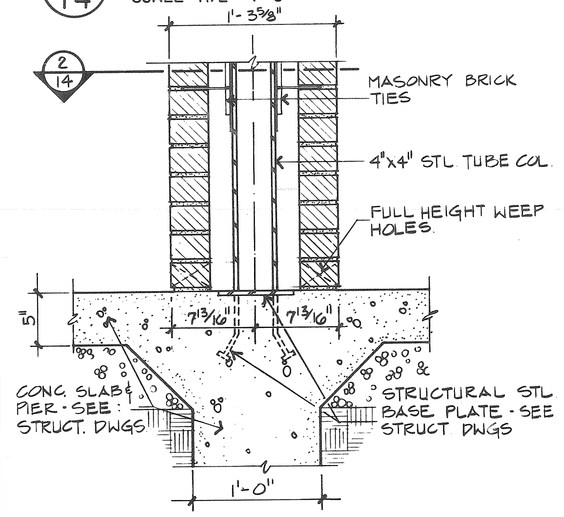

3/14 COLUMN BASE DETAIL
SCALE: 11/2" = 1'-0"

4/14 COLUMN BASE DETAIL
SCALE: 11/2" = 1'-0"

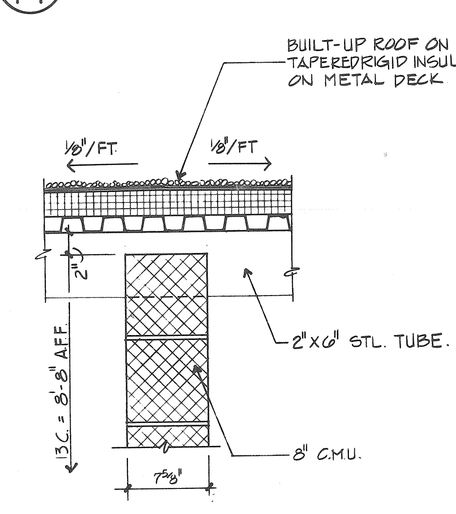

8/L4 WALL DETAIL
SCALE: 11/2" = 1'-0"

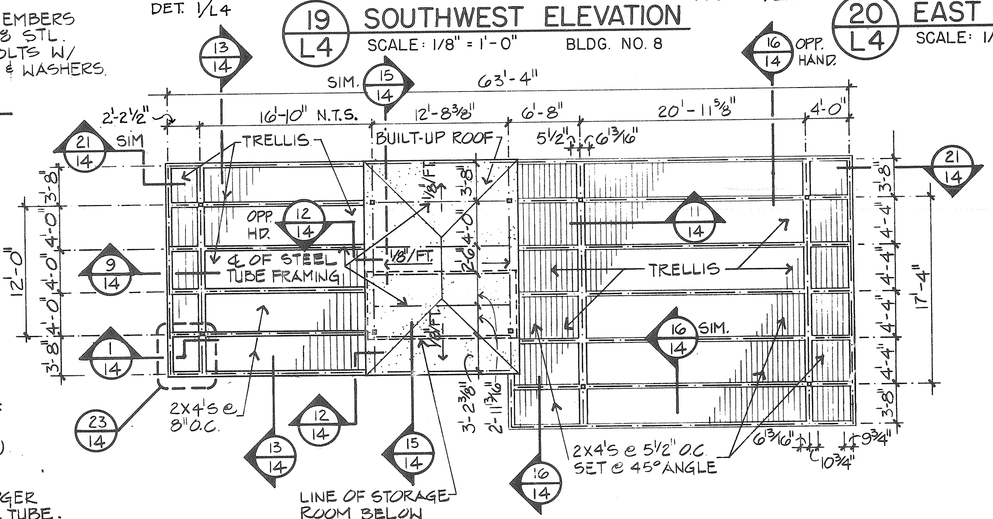

22/L4 ROOF AND TRELLIS PLAN AT BLDG. NO. 8
SCALE: 1/8" = 1'-0"

19/L4 SOUTHWEST ELEVATION
SCALE: 1/8" = 1'-0" BLDG. NO. 8

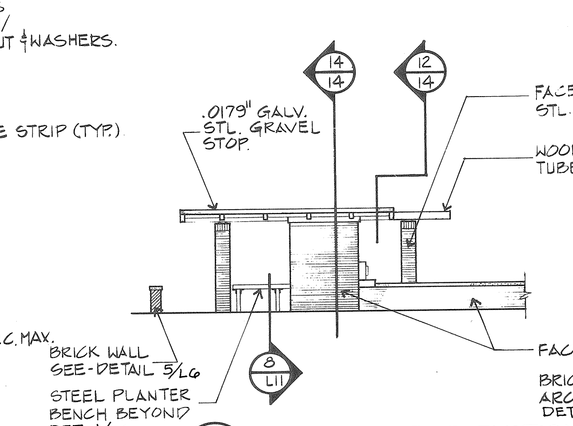

20/L4 EAST ELEVATION
SCALE: 1/8" = 1'-0" BLDG. NO. 8

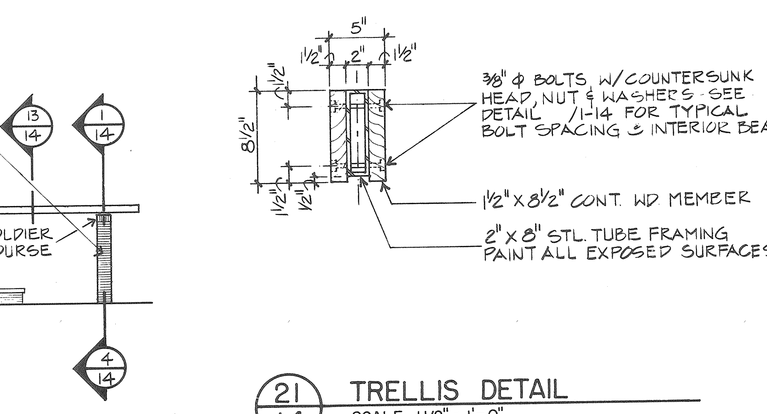

21/14 TRELLIS DETAIL
SCALE: 11/2" = 1'-0"

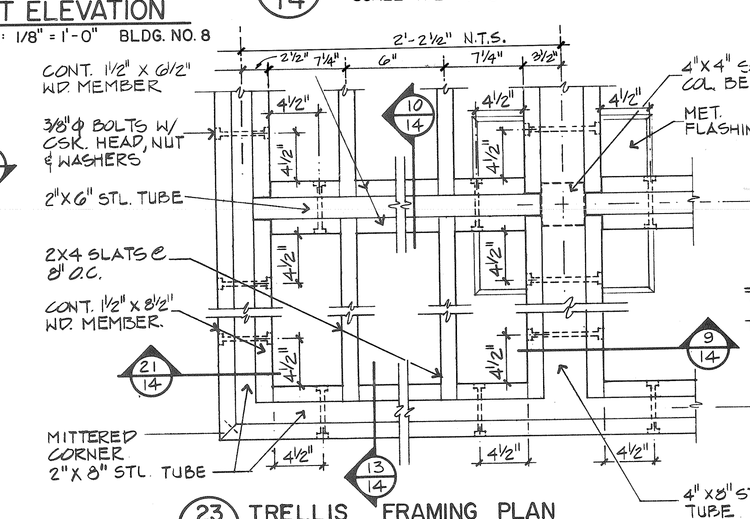

23/14 TRELLIS FRAMING PLAN
SCALE: 11/2" = 1'-0"

RECORD DRAWINGS	2-7-92	NOTE: SEE DRAWING 1-42 FOR 1/8" FLOOR PLAN
Revisions	Date	

A JOINT VENTURE OF
PHELPS/GARZA/BOMBERGER
MARMON BARCLAY SOUTER FOSTER HAYS
ARCHITECTS PLANNERS
5545 Fredericksburg Road Suite 100
San Antonio, Texas 78229

MARMON BARCLAY SOUTER FOSTER HAYS
MECH./ELECT. ENGINEERS

W. E. SIMPSON CO. INC.
STRUCTURAL ENGINEERS

WOMMACK B. BOMBERGER REGISTERED ARCHITECT STATE OF TEXAS 5-16-89

FIRST AID STATION & STOR. BLD'G. NO. 8 & DETAILS - ADDITIVE ALTERNATE NO. 2

Drawing Title: FIRST AID STATION & STOR. BLD'G. NO. 8, ELEVATIONS & DETAILS.

Project Title: 30 - BED SPINAL CORD INJURY UNIT

Date: MAY 19, 1989

Project No.: 671 - 046

Approved Project Director / Hospital Director

Building Number: 1 | Checked: LC | Drawn: RG

Location: VAMC - SAN ANTONIO, TEXAS

DRAWING NO.: 1-14

Dwg. 17 of 46

Veterans Administration

U.S. GOVERNMENT PRINTING OFFICE: 1984-440-467