




U.S. Department of Veterans Affairs

PROJECT NUMBER: 578-16-020 Repair Exterior Building 20

| FACILITY DEPARTMENT BY LEVEL | |
|---------------------------------|------------------|
| FACILITY DEPARTMENT | AREA |
| 0B - BASEMENT | |
| COMMON SPACE | 22 SF |
| ENGINEERING | 1,758 SF |
| VERTICAL SPACE | 52 SF |
| 01 - LEVEL 01 | |
| A&MM ADMIN | 4,182 SF |
| COMMON SPACE | 2,847 SF |
| EMS | 12,256 SF |
| ENGINEERING | 1,059 SF |
| TENANT SPACE | 5,208 SF |
| UNASSIGNED VACANT SPACE | 2,996 SF |
| VERTICAL SPACE | 647 SF |
| 01M - MEZZANINE | |
| EMS | 1,219 SF |
| VERTICAL SPACE | 78 SF |
| 02 - LEVEL 02 | |
| COMMON SPACE | 2,095 SF |
| EMS | 396 SF |
| ENGINEERING | 321 SF |
| TENANT SPACE | 13,697 SF |
| UNASSIGNED VACANT SPACE | 8,088 SF |
| VERTICAL SPACE | 631 SF |
| 02M - MEZZANINE | |
| ENGINEERING | 395 SF |
| BUILDING NET GROSS TOTAL | 57,947 SF |

BUILDING DIRECTORY

- | | | | | |
|-----------------------------------------------------------|-------------------------------------|---------------------------------------------|-------------------------------------------|-----------------------------------|
| 1 OUTPATIENT CLINICS, ADMINISTRATION OFFICES AND RESEARCH | 19 BASEBALL FIELD and SEATING STAND | 37 NAC / CMDP | 202 ELECTRICAL SUBSTATION | 227 EMERGENCY GENERATOR |
| 2 ENGINEERING, FISCAL, SAFETY OFFICES | 20 MOTOR POOL | 42 FLAG POLE | 203 PATIENT RECREATION PAVILION | 228 CLINICAL AREAS |
| 3 ENGINEERING SHOPS | 21 MAINTENANCE STORAGE | 45 CANTEEN & POST OFFICE | 204 GREENHOUSE | 229 RESEARCH |
| 4 DRM | 23 HOUSEKEEPING QUARTERS | 46 FORMER GOLF COURSE RECREATION BUILDING | 215 DATA PROCESSING CENTER | 230 EMS / ARMY CORPS OF ENGINEERS |
| 5 POWER HOUSE | 24 HOUSEKEEPING QUARTERS | 47 GAS METER HOUSE | 217 EXTENDED CARE | 231 SALT STORAGE |
| 7 STRUCTURE'S SHED | 25 HOUSEKEEPING QUARTERS | 48 LAUNDRY DISTRIBUTION | 218 EMERGENCY GENERATOR FOR BUILDING 217 | 232 RONALD McDONALD HOUSE |
| 8 ENGINEERING, MRW / POLICE | 26 HOUSEKEEPING QUARTERS | 53 CATHOLIC CHARITIES | 219 CHILLER FOR BLDG 217 | 240 FREEDOM'S PATH |
| 9 AUDITORIUM, RECREATION AND VOLUNTARY SERVICES | 27 HOUSEKEEPING QUARTERS | 100 FISHER HOUSE FOUNDATION | 220 WAREHOUSE/SERVICE BUILDING | 300 TRAILER (CONTRACTOR USAGE) |
| 12 EMPLOYEE GYM, COMP & PEN | 28 HOUSEKEEPING QUARTERS | 113 BLIND REHABILITATION CENTER | 221 RCF LONG TERM SPINAL CORD INJURY UNIT | |
| 13 COUNSELING CENTER | 29 HOUSEKEEPING QUARTERS | 128 SPINAL CORD INJURY AND DISORDERS CENTER | 222 EMERGENCY GENERATOR | |
| 14 CATHOLIC CHARITIES | 30 EMS STORAGE | 195 WATER STORAGE TANK (1,000,000 GALLON) | 223 EMERGENCY GENERATOR | |
| 15 UNDERGROUND WATER RESERVOIR (700,000 GALLON) | 31 QUARTERS | 197 VALVE HOUSE | 224 EMERGENCY GENERATOR | |
| 16 I. G. OFFICE OF AUDIT | 32 QUARTERS | 200 MAIN HOSPITAL | 225 EMERGENCY GENERATOR | |
| 17 HUMAN RESOURCES | 33 RADIATION LABORATORY | 201 OXYGEN STORAGE | 226 EMERGENCY GENERATOR | |
| 18 VIREC | 34 GEORGE DILBOY MEMORIAL STATUE | | | |
| | 35 MAIN GATE HOUSE | | | |

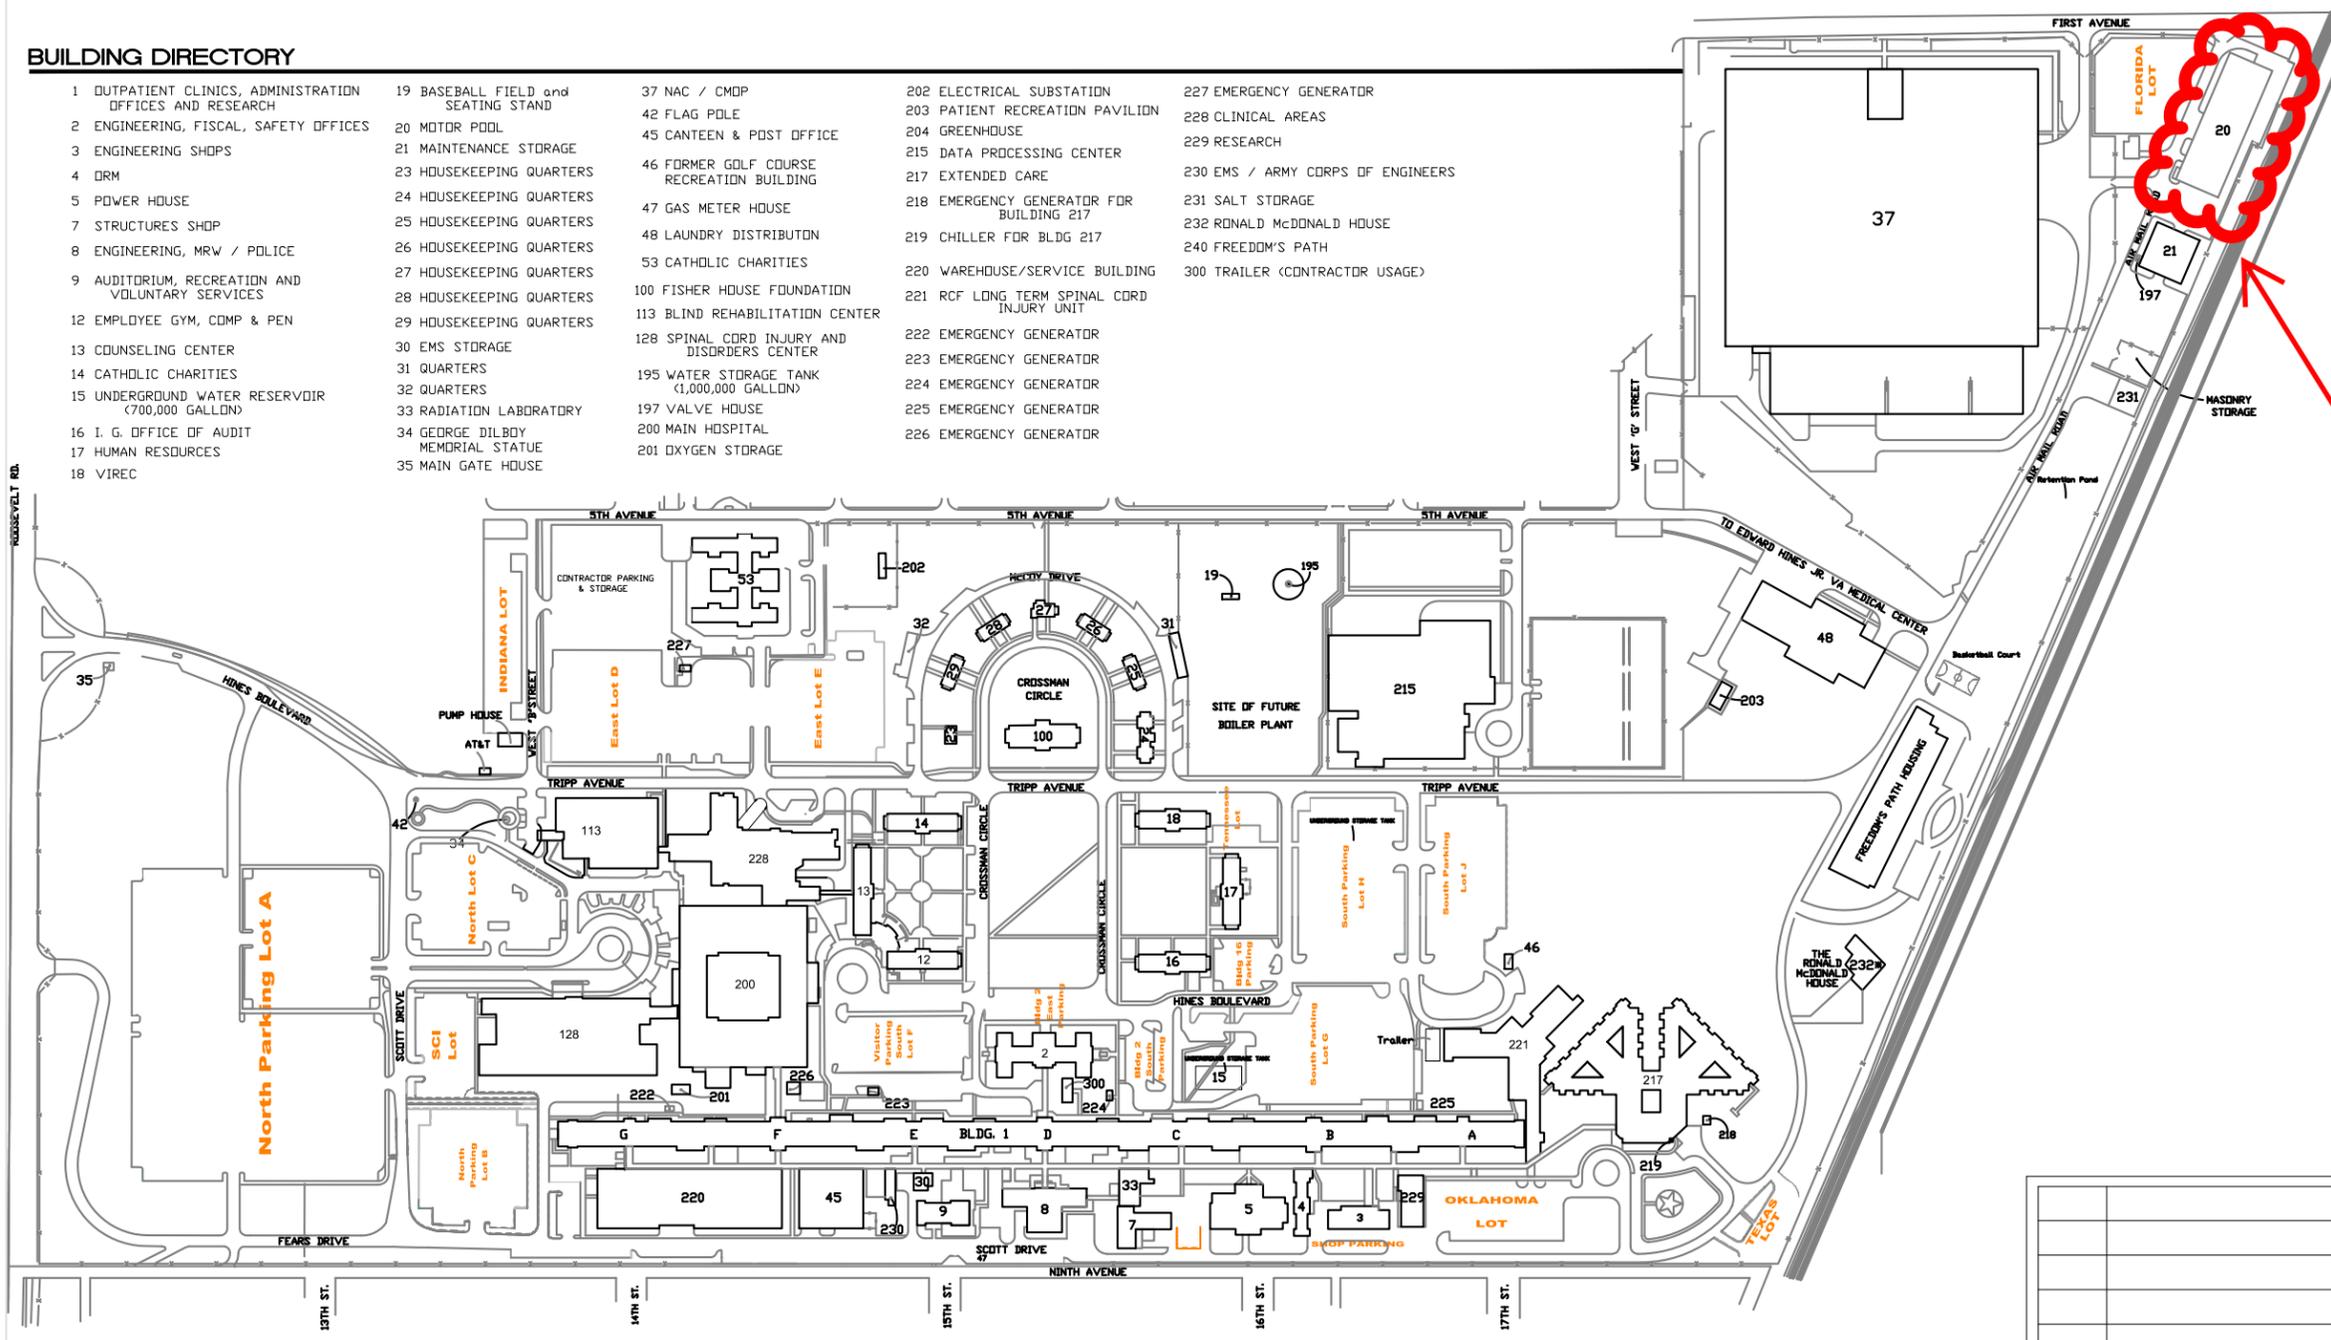


Project Location

| NO. | REVISION / DESCRIPTION | ISSUE DATE |
|-----|------------------------------------|------------|
| 01 | 578-16-020 Repair Exterior Bldg 20 | 4/15/2016 |
| | | |
| | | |
| | | |
| | | |

Not to scale. Contractor is responsible for field verifying all conditions.

Numbers (in red) correspond to demolition notes.

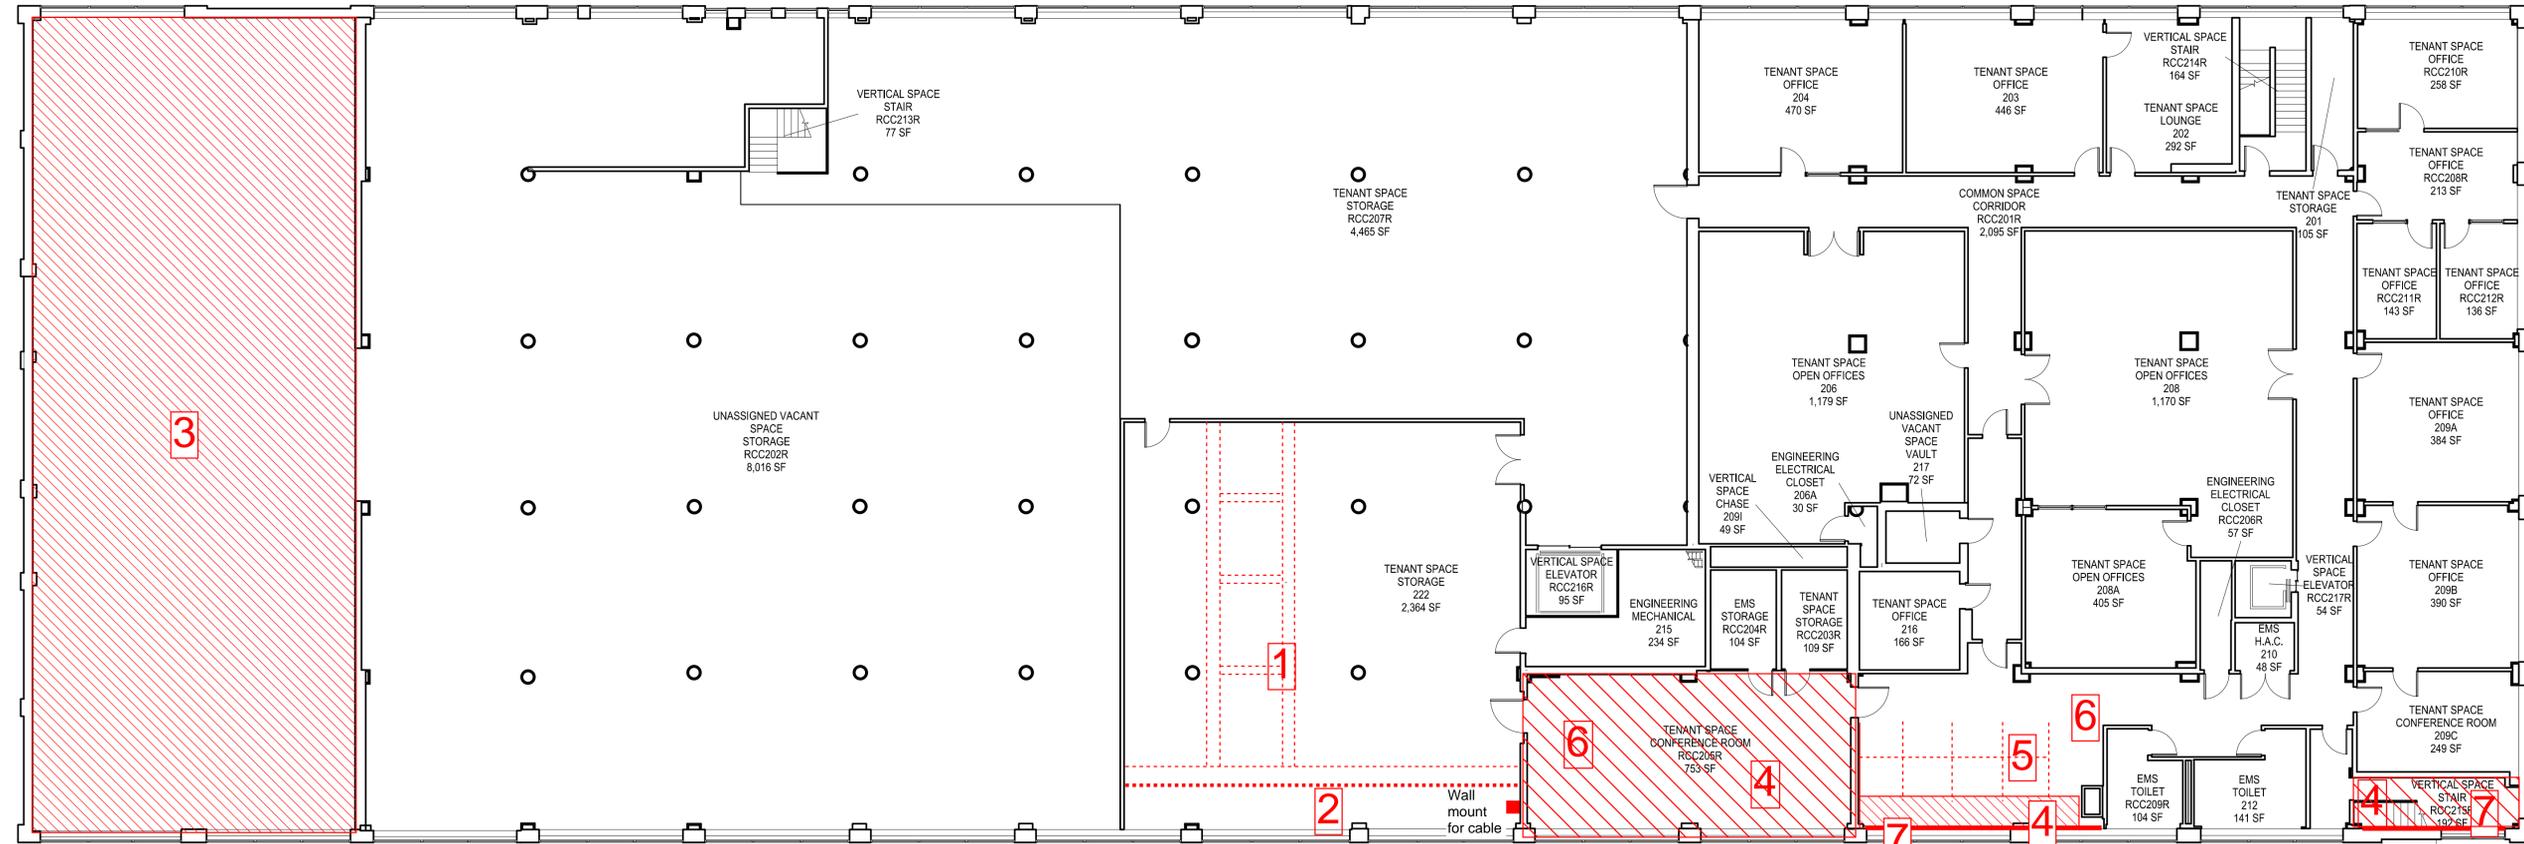

- Demo Notes Corresponding to drawing numbers:
1. Demo existing cable tray and all associated hangers
 2. Demo existing network cable conduit and associated hangers
 3. Demo existing roof material, structure to remain
 4. Demo damaged ceiling tiles, keep grid in place
 5. Demo office furniture
 6. Demo carpet from entire room
 7. Demo damaged drywall
 8. Demo existing 2nd floor windows - South face
 9. Demo existing chimney and parapet, support electrical conduit
 10. OPTION 1: Demo existing 2nd floor windows - North face

- New Work Notes:
1. Install wall mounted unistrut and coil network cable neatly around. See detail 1
 2. Install new 2nd floor windows at south face
 3. Install new drywall to replace removed
 4. Install new roofing to replace removed
 5. Install new drywall to replace removed
 6. New paint for entire room. Sherwin Williams Paint color TBD
 7. Install ceiling tile as needed to replace removed
 8. Repoint existing exterior brick as needed, patch roof membrane as indicated in SOW
 9. Install new flashing and gutter at southeast roof corner
 10. OPTION 1: install 2nd floor windows - north face

Detail 1 Intent - Wall mounted unistrut for network cable bundle



NORTH ARROW

CONTRACTING FIRM:

CLIENT &
PROJECT
NAME:

DRAWING TITLE:

EDWARD HINES, JR. VA HOSPITAL

FACILITY DEPARTMENT FLOOR PLAN - LEVEL 02

APPROVED BY:

BLDG NUMBER: 020

PROJECT NUMBER: 578-16-020

DRAWING SCALE:



ISSUE DATE: 7/13/2016




U.S. Department of
Veterans Affairs

No work on this level. Reference Only.


| FACILITY DEPARTMENT | AREA |
|-----------------------------|------------------|
| A&MM ADMIN | 4,182 SF |
| COMMON SPACE | 2,847 SF |
| EMS | 12,256 SF |
| ENGINEERING | 1,059 SF |
| TENANT SPACE | 5,208 SF |
| UNASSIGNED VACANT SPACE | 2,996 SF |
| VERTICAL SPACE | 647 SF |
| LEVEL NET GROSS AREA | 29,195 SF |

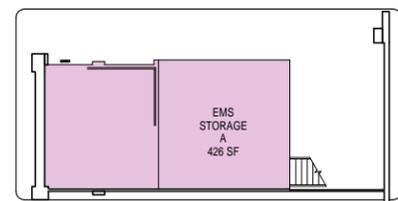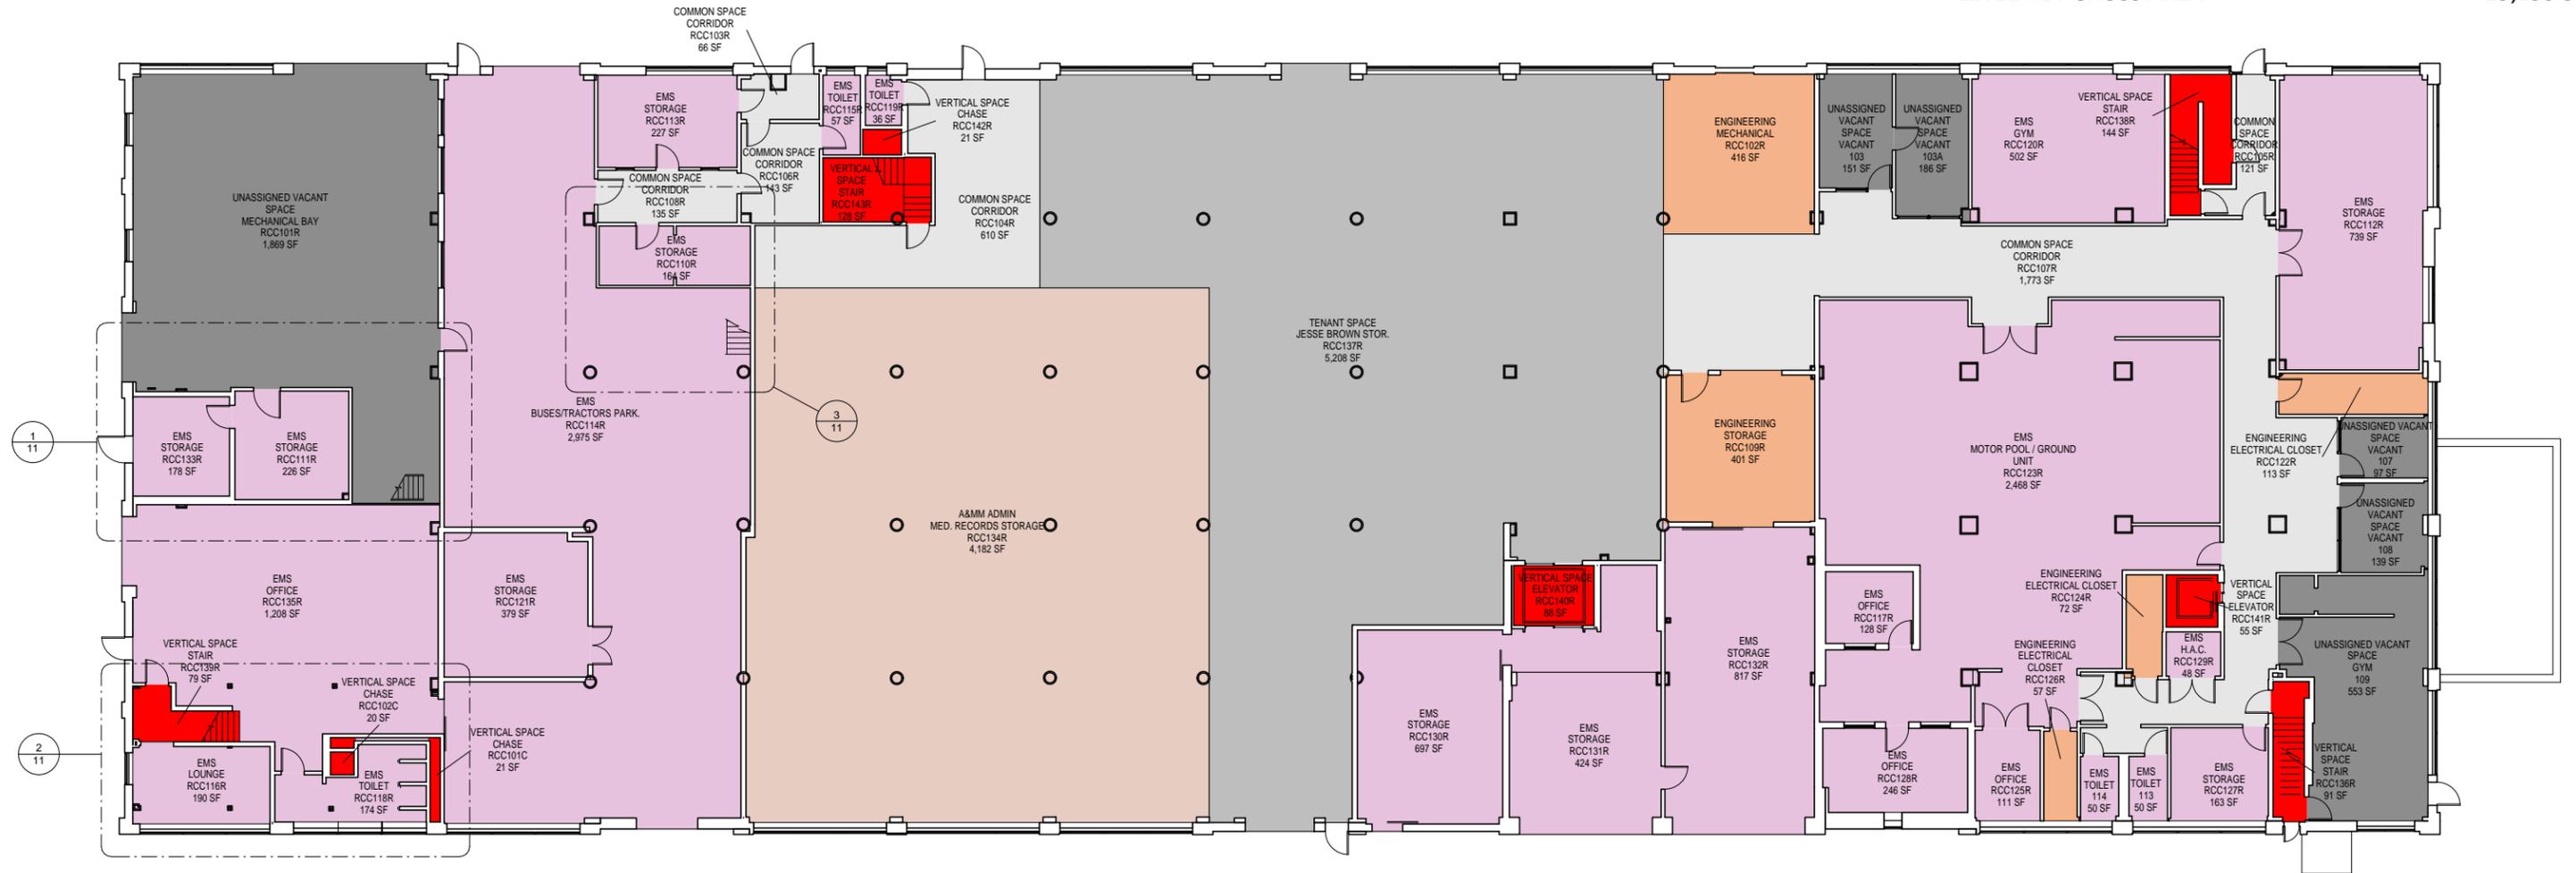

1 MEZZANINE, STORAGE

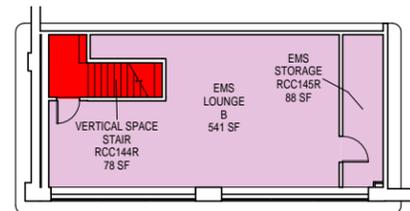

2 MEZZANINE, LOUNGE

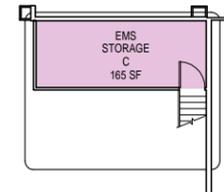

3 MEZZANINE, STORAGE

| FACILITY DEPARTMENT | MEZZ AREA |
|-----------------------------|-----------------|
| EMS | 1,219 SF |
| VERTICAL SPACE | 78 SF |
| LEVEL NET GROSS AREA | 1,297 SF |



1/17/2016 4:20:14 PM

CLIENT & PROJECT NAME: EDWARD HINES, JR. VA HOSPITAL

DRAWING TITLE: FACILITY DEPARTMENT FLOOR PLAN - LEVEL 01

APPROVED BY:

BLDG NUMBER: 020


PROJECT NUMBER:

DRAWING SCALE: 3/32" = 1'-0" ISSUE DATE: 01/20/2016



| FACILITY DEPARTMENT | | AREA |
|-------------------------------------------------------------------------------------|----------------|----------|
|  | COMMON SPACE | 22 SF |
|  | ENGINEERING | 1,758 SF |
|  | VERTICAL SPACE | 52 SF |
| LEVEL NET GROSS AREA | | 1,832 SF |

No work on this level. Reference Only.

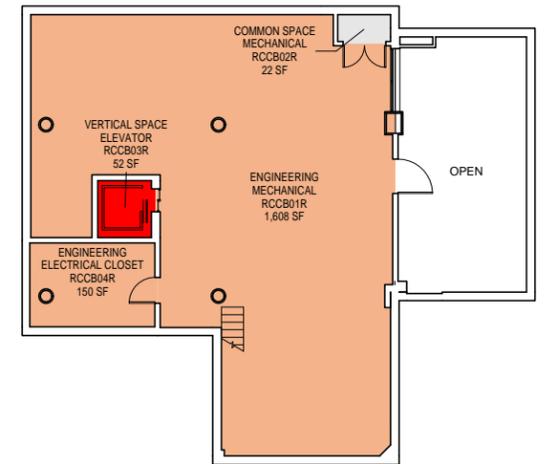

1/17/2016 4:20:13 PM



NORTH ARROW

| | |
|------------------------|--------------------------------------------------|
| CLIENT & PROJECT NAME: | EDWARD HINES, JR. VA HOSPITAL |
| DRAWING TITLE: | FACILITY DEPARTMENT FLOOR PLAN - BASEMENT |

| | |
|------------------------------|------------------------|
| APPROVED BY: | |
| BLDG NUMBER: 020 | |
| PROJECT NUMBER: | |
| DRAWING SCALE: 3/32" = 1'-0" | ISSUE DATE: 01/20/2016 |

