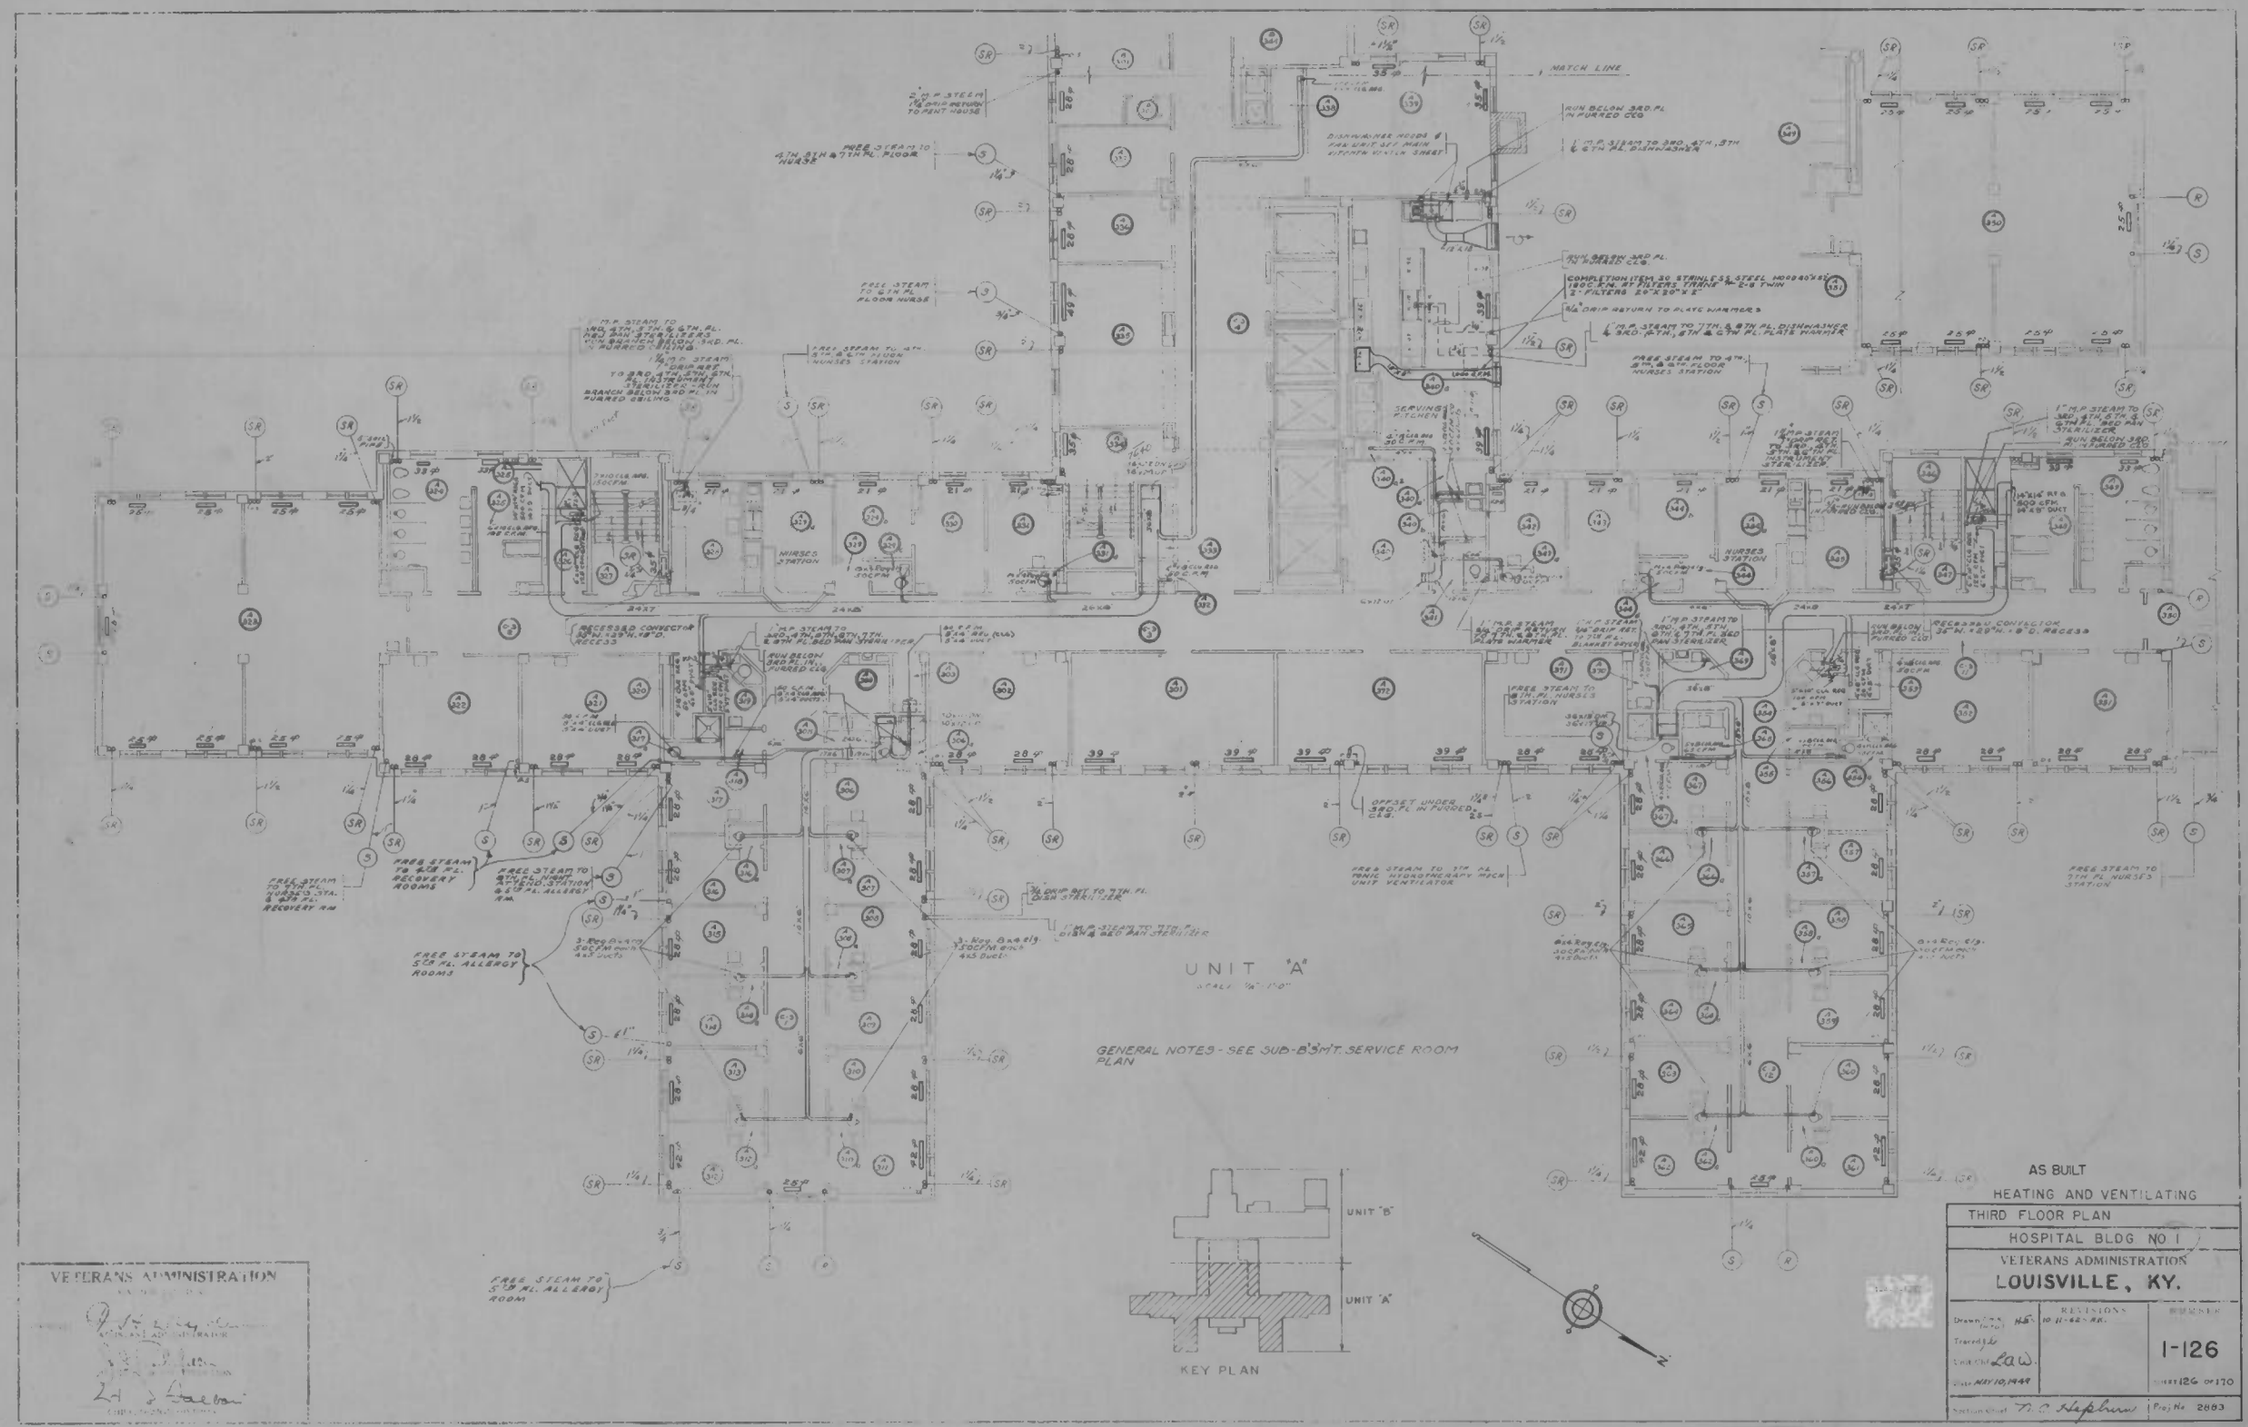
MATCH LINE
NURSES STATION
SERVING KITCHEN
UNIT "A"
GENERAL NOTES - SEE SUB-B'S'MT. SERVICE ROOM PLAN
UNIT "B"
UNIT "A"
KEY PLAN
VETERANS ADMINISTRATION
AS BUILT
HEATING AND VENTILATING
THIRD FLOOR PLAN
HOSPITAL BLDG NO 1
VETERANS ADMINISTRATION
LOUISVILLE, KY.
REVISIONS
1-126
SHEET 126 OF 170
MAY 10, 1949
Proj No 2883