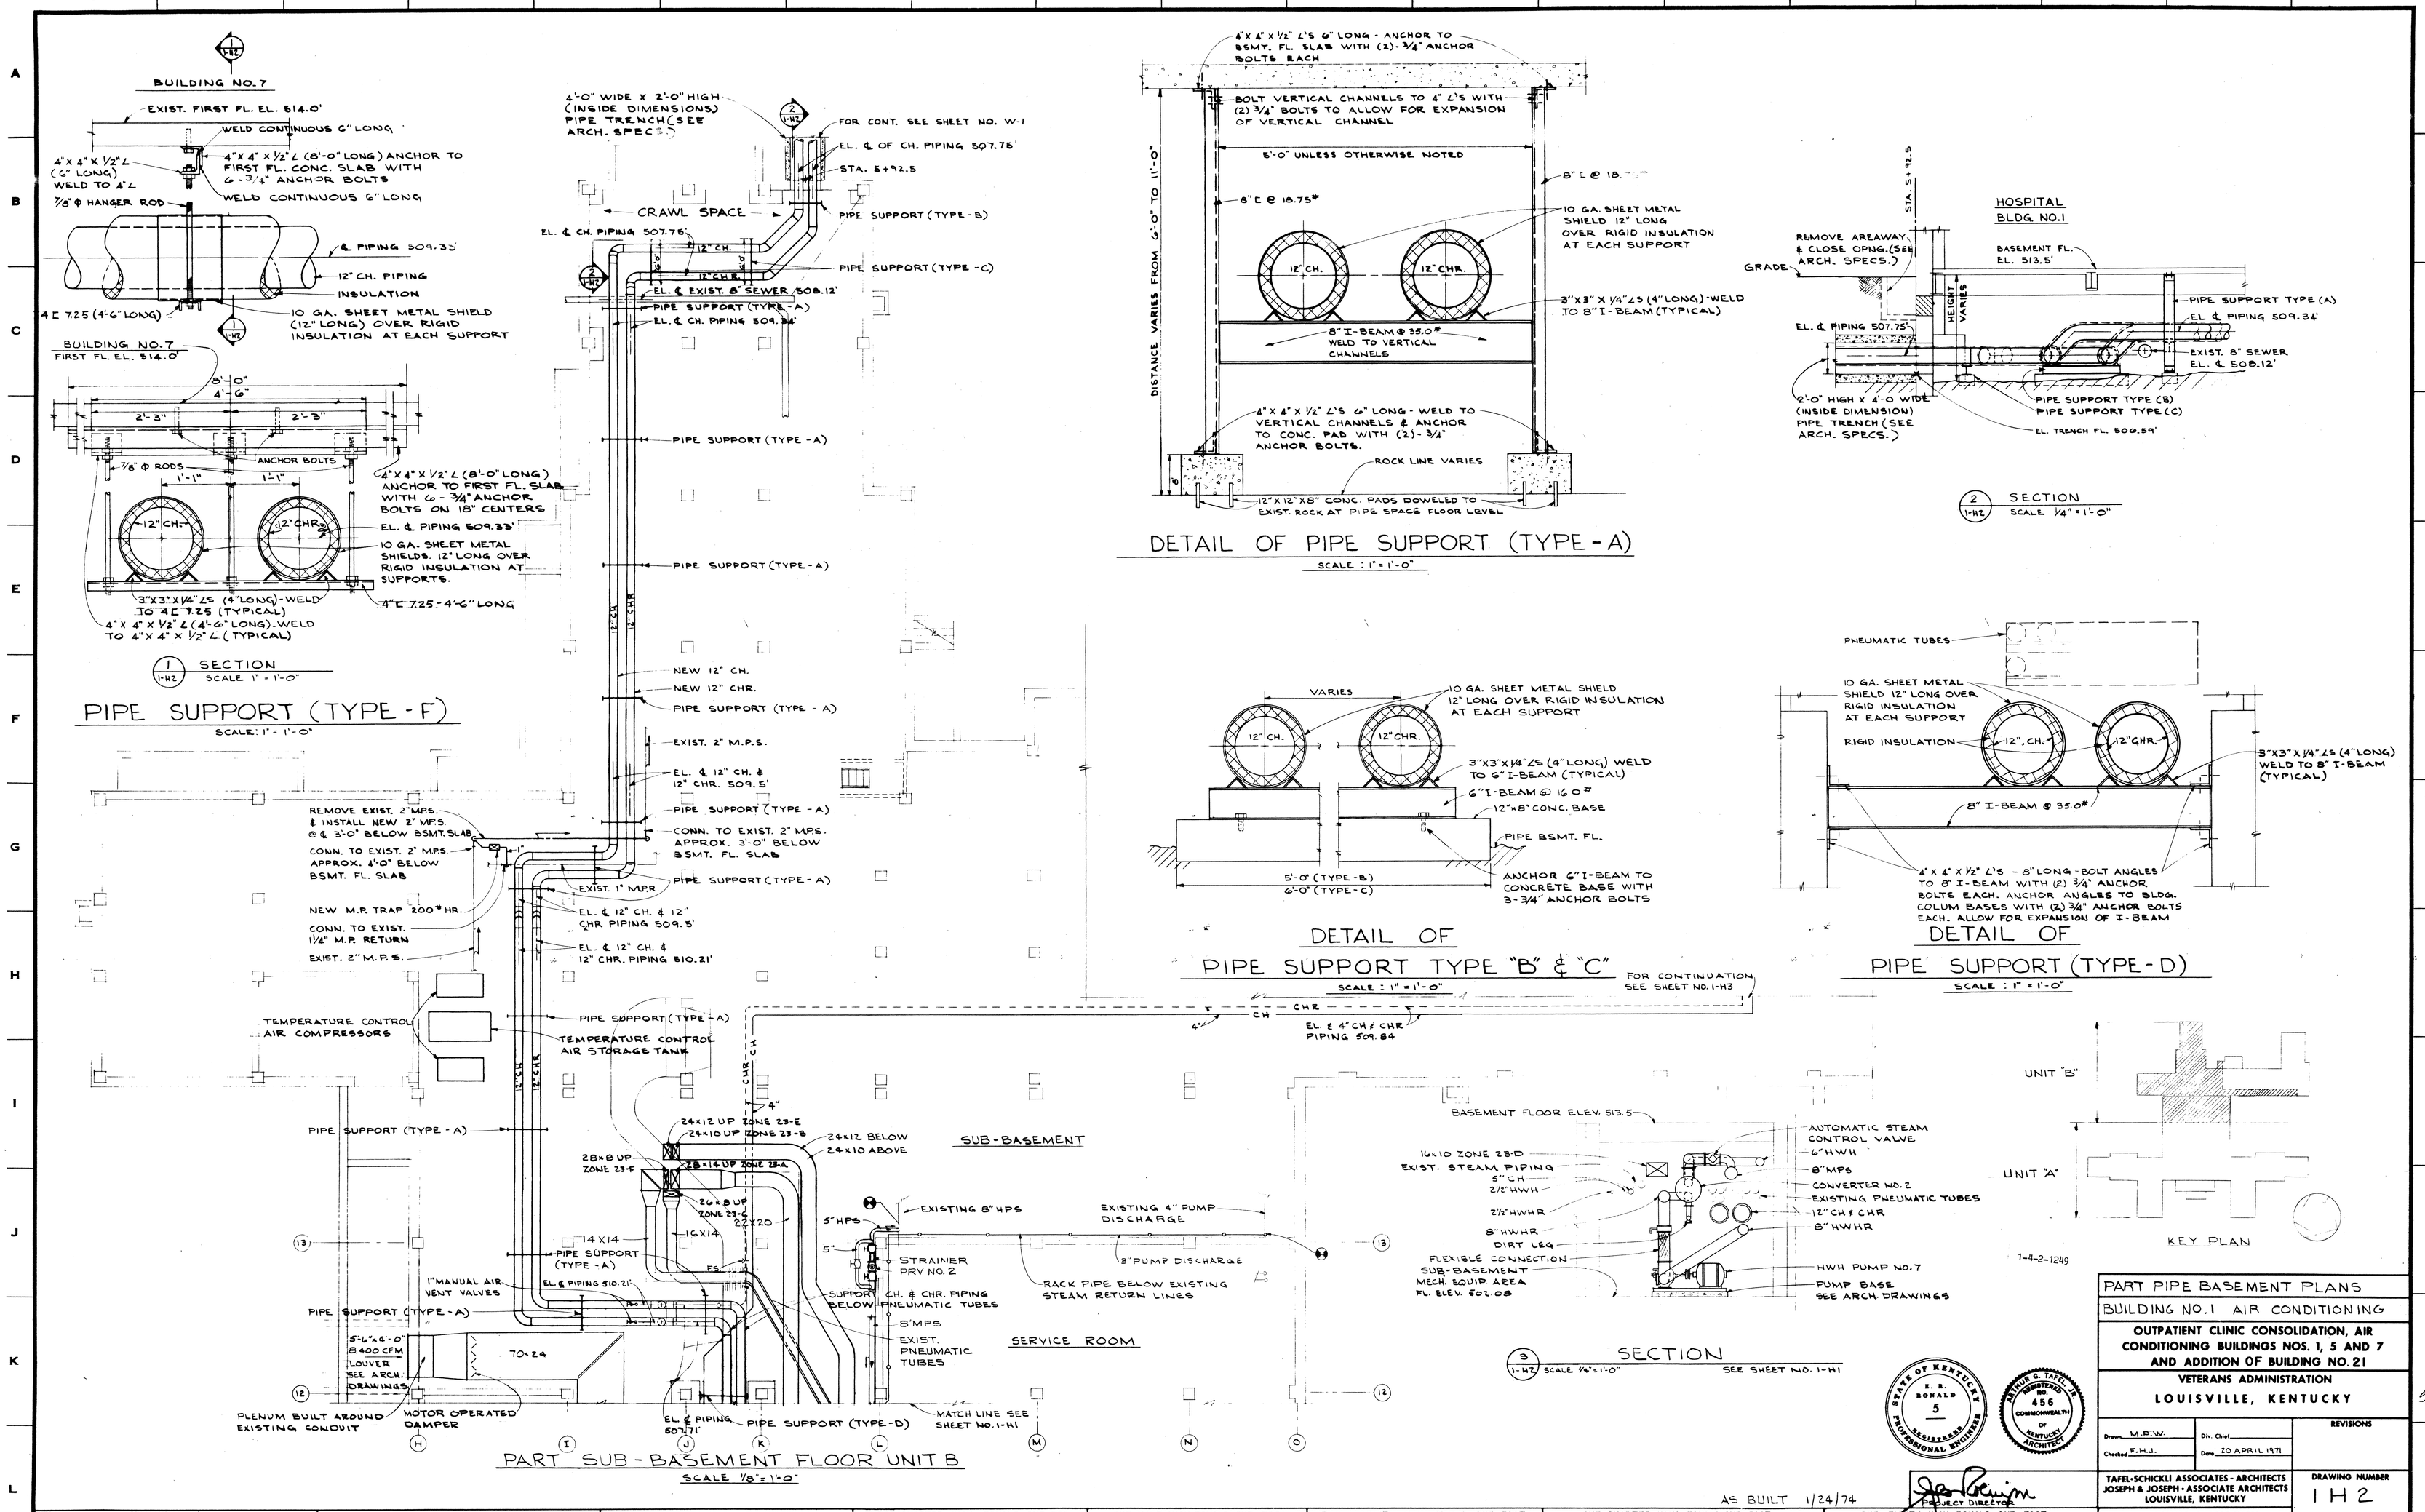

PART PIPE BASEMENT PLANS

BUILDING NO. 1 AIR CONDITIONING

OUTPATIENT CLINIC CONSOLIDATION, AIR CONDITIONING BUILDINGS NOS. 1, 5 AND 7 AND ADDITION OF BUILDING NO. 21

VETERANS ADMINISTRATION

LOUISVILLE, KENTUCKY

54

STATE OF KENTUCKY — E. R. RONALD — 5 — REGISTERED PROFESSIONAL ENGINEER

ARTHUR G. TAFEL, JR. — REGISTERED NO. 456 — COMMONWEALTH OF KENTUCKY — ARCHITECT

AS BUILT 1/24/74

PROJECT DIRECTOR

Drawn M.D.W. | Checked F.H.J. | Div. Chief | Date 20 APRIL 1971

REVISIONS

TAFEL-SCHICKLI ASSOCIATES - ARCHITECTS
JOSEPH & JOSEPH - ASSOCIATE ARCHITECTS
LOUISVILLE, KENTUCKY

E. R. RONALD & ASSOCIATES
CONSULTING ENGINEERS
LOUISVILLE, KENTUCKY

DRAWING NUMBER 1H2

Sheet 2 of 28

Proj. No. 16 - 5180

THREE INCHES EQUALS ONE FOOT | ONE AND ONE HALF INCHES EQUALS ONE FOOT | ONE INCH EQUALS ONE FOOT | THREE QUARTER INCH EQUALS ONE FOOT | ONE HALF INCH EQUALS ONE FOOT | THREE EIGHTH INCH EQUALS ONE FOOT | ONE QUARTER INCH EQUALS ONE FOOT | ONE EIGHTH INCH EQUALS ONE FOOT

RETURN TO PLAN LIBRARY

FILE FOLDER NO. 2C

VA FORM 09-6231, OCT 1966