



1½" DIAMETER METAL HAND
RAIL RETURN INTO POSTS

TEMPORARY
WOOD STAIR
SEE 3/A-201

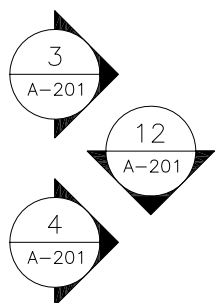

3'-0" X 7'-0"
TEMPORARY DOOR
PROVIDE OPENING
IN WALL FOR DOOR
PATCH WALL TO MATCH
EXISTING AFTER
COMPLETION OF PORCH
CENTER DOOR IN WALL

PAINT WALLS IN
THIS ROOM AFTER
PATCHING WALL

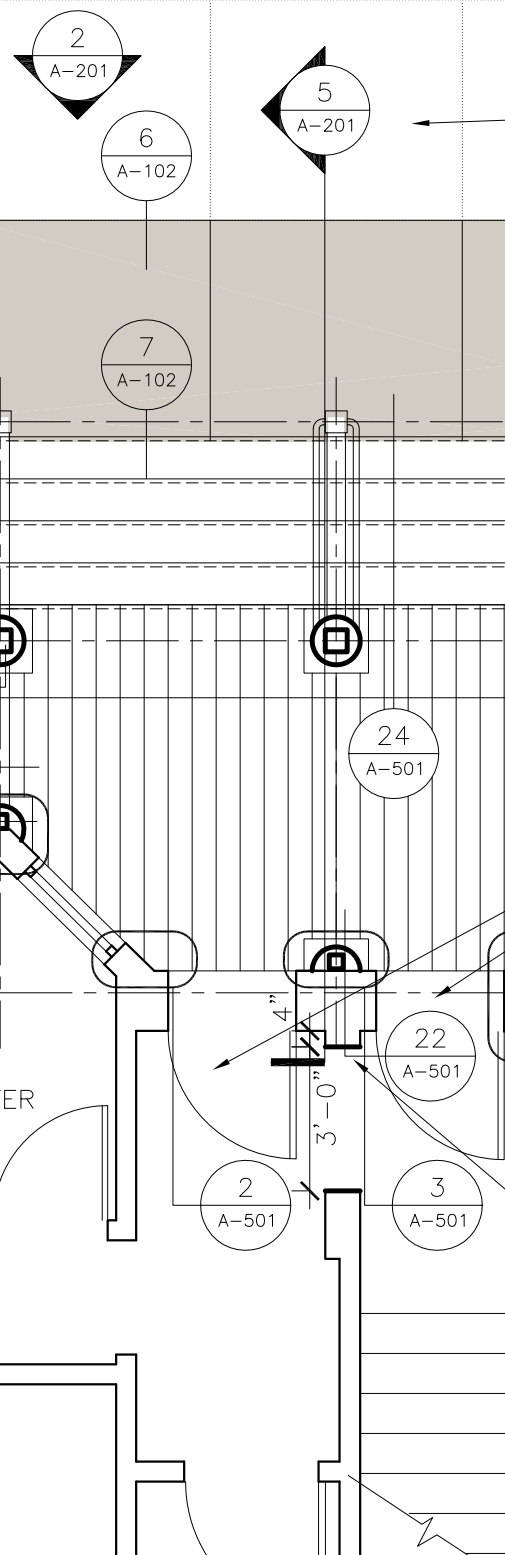

GROUND FLOOR CONSTRUCTION PLAN

REVISES 3/A-102

Facilities
Management
Services



Department of
Veterans Affairs

CONSTRUCTION PLAN

CONNECTICUT HEALTHCARE SYSTEM
WESTHAVEN CAMPUS
SAFETY CORRECTION
BROWNELL HOUSE

JANUARY 19, 2012
JOB #1351-00

PROJECT NUMBER
689-09-502

SCALE
1/4" = 1'-0"

SK-3

Lothrop associates^{LLP} architects

333 WESTCHESTER AVENUE, WHITE PLAINS, NEW YORK - 914 741 1115
95 ALLENS CREEK, BUILDING 1, SUITE 322, ROCHESTER, NEW YORK - 585 469 2828
125 HALF MILE ROAD, SUITE 200, RED BANK, NEW JERSEY - 732 933 2734