


COVERS SHALL BE MOUNTED FLUSH WITH FINAL GRADE

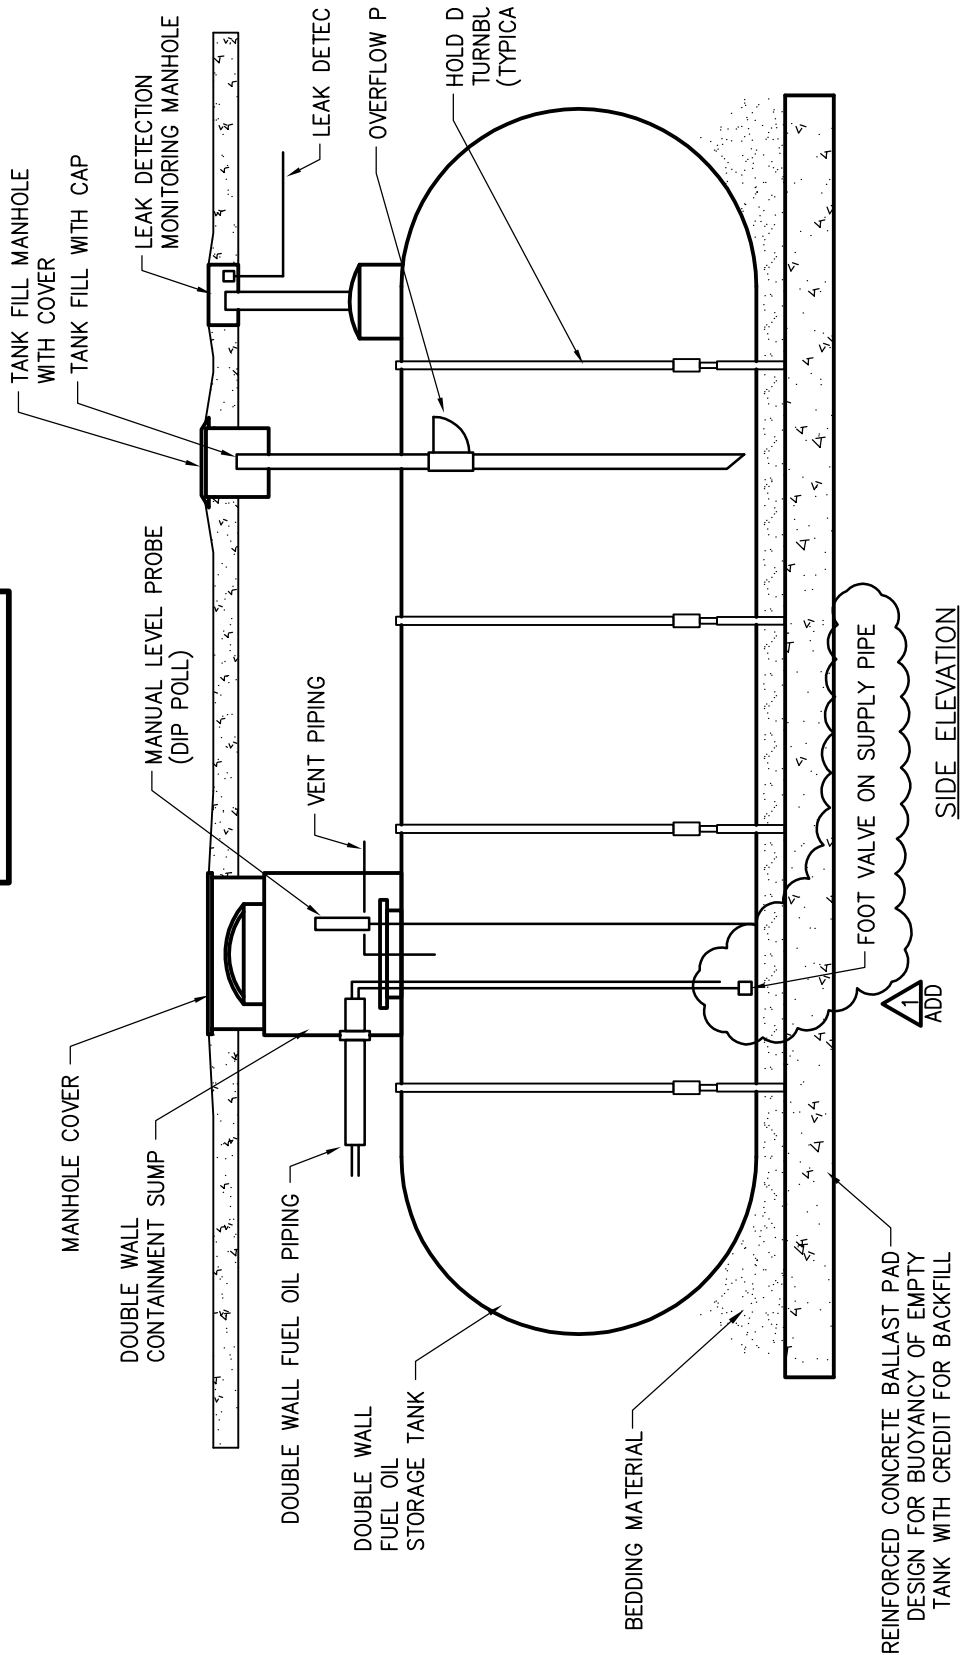

1 UNDERGROUND FUEL OIL STOF

NO SCALE

SHIVEHATTERY
ARCHITECTURE + ENGINEERING

Iowa | Illinois | Missouri

<http://www.shive-hottery.com>

**MECHANICAL DETAILS (7-M3)
REPLACE BUILDING 7 UST
IOWA CITY, IOWA**

1-20-12	SCALE
DRAWN MSJ	FIELD BOOK
APPROVED TRF	REVISION
REFERENCE DRAWING	

PROJECT NO.
1112350
DVA #636A8-12-004

ISSUED FOR
ADD #1

M3

7-M3