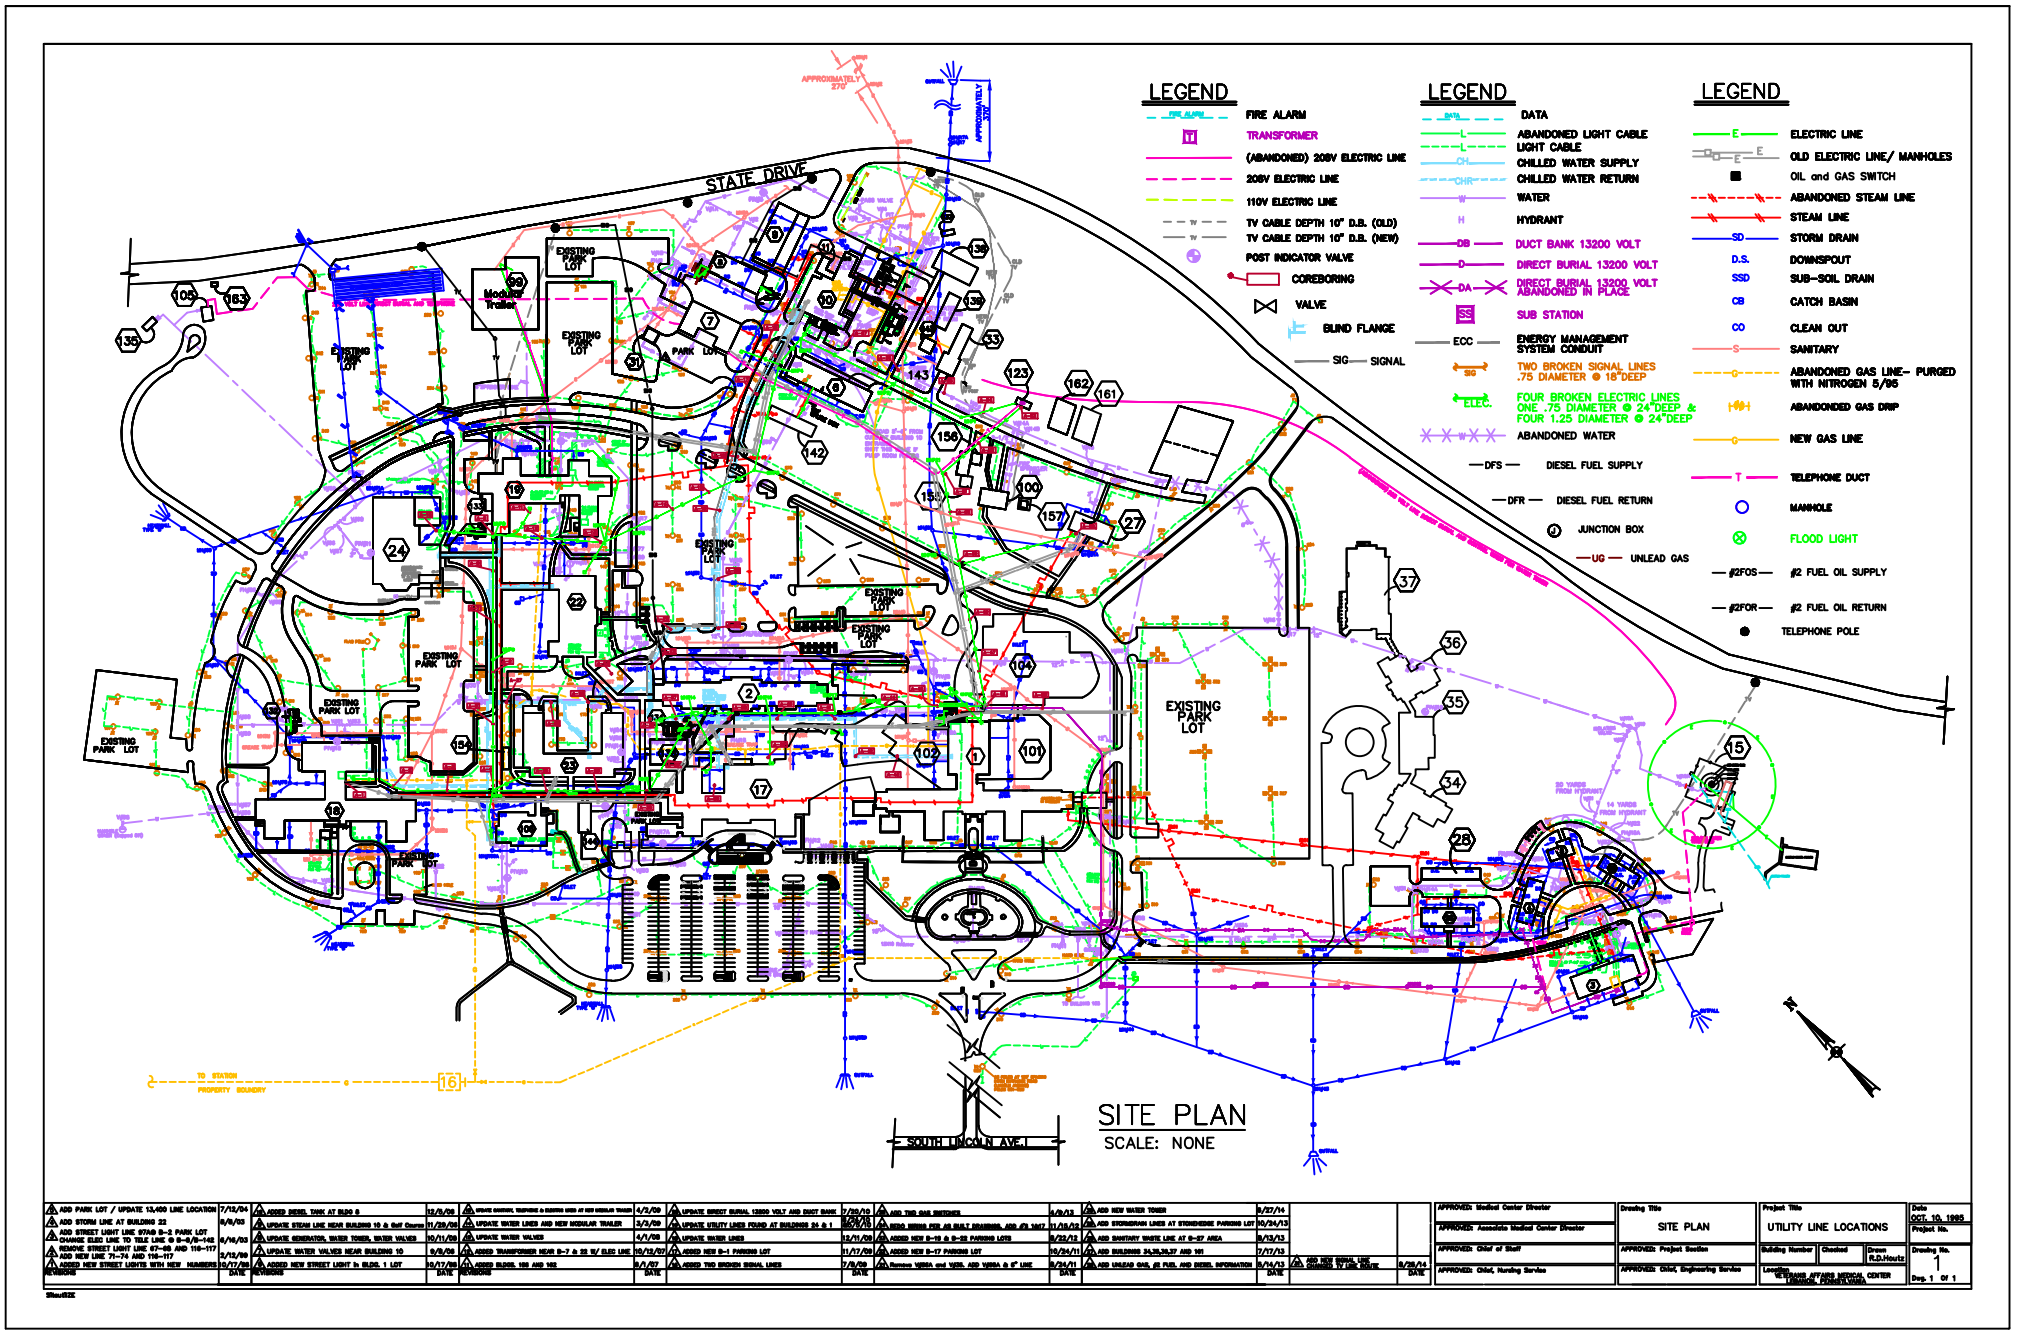

ADD PARK LOT / UPDATE 13,400 LINE LOCATION	7/12/04	ADDED DIESEL TANK AT BLDG 5	12/3/96	STEAM ANNEX, REMOVE 4 EXIST MEN AT HIS MODULAR TRAILER	4/2/99	UPDATE STREET BURIAL 13200 VOLT AND DUCT BANK	7/29/10	ADD TWO GAS SWITCHES	4/9/13	ADD NEW WATER TOWER	9/27/14			APPROVED: Medical Center Director		Drawing Title SITE PLAN		Project Title UTILITY LINE LOCATIONS		Date OCT. 10, 1995
ADD STORM LINE AT BUILDING 22	6/8/03	UPDATE STEAM LINE NEAR BUILDING 10 & Golf Course	11/26/96	UPDATE WATER LINES AND NEW MODULAR TRAILER	2/3/99	UPDATE UTILITY LINES FOUND AT BUILDINGS 24 & 1	10/4/10	ADDED NEW 208V AS BUILT DRAWING AND JOB 1417	11/19/12	ADD STORMSEWER LINES AT STONEHENGE PARKING LOT	10/24/13			APPROVED: Associate Medical Center Director				Project No.		
CHANGE ELEC LINE TO TIE LINE @ S-4/S-14S	6/16/03	UPDATE GENERATOR, WATER TOWER, WATER VALVES	10/11/96	UPDATE WATER VALVES	4/1/98	UPDATE WATER LINES	12/11/09	ADDED NEW S-19 & S-20 PARKING LOTS	9/20/12	ADD SANITARY WASTE LINE AT S-37 AREA	9/13/13			APPROVED: Chief of Staff						
REMOVE STREET LIGHT LINE #7-48 AND 116-117	2/13/99	UPDATE WATER VALVES NEAR BUILDING 10	9/9/96	ADDED TRANSFORMER NEAR S-7 & 22 W/ ELEC LINE	10/12/07	ADDED NEW S-1 PARKING LOT	11/17/09	ADDED NEW S-17 PARKING LOT	10/24/11	ADD BUILDINGS 24,30,36,37 AND 101	7/17/13			APPROVED: Chief, Nursing Service				Drawing No. 1		
ADD NEW LINE 71-74 AND 116-117																			
ADDED NEW STREET LIGHTS WITH NEW NUMBERS	10/17/05	ADDED NEW STREET LIGHT In BLDG. 1 LOT	10/17/05	ADDED BLDGS. 100 AND 102	8/1/07	ADDED TWO BROKEN SIGNAL LINES	7/9/08	Remove 12B5A and 12B5, ADD 12B5A & 6" LINE	8/24/11	ADD UNLEAD GAS, #2 FUEL AND DIESEL INFORMATION	8/14/13	ADD NEW SIGNAL LINE TO CONNECT TO EXIST ROUTE	6/26/14	APPROVED: Chief, Engineering Service		Location: VETERANS AFFAIRS MEDICAL 
REVISIONS	DATE	REVISIONS	DATE	REVISIONS	DATE		DATE		DATE		DATE		DATE						

Sheet/SIZE