PARKING
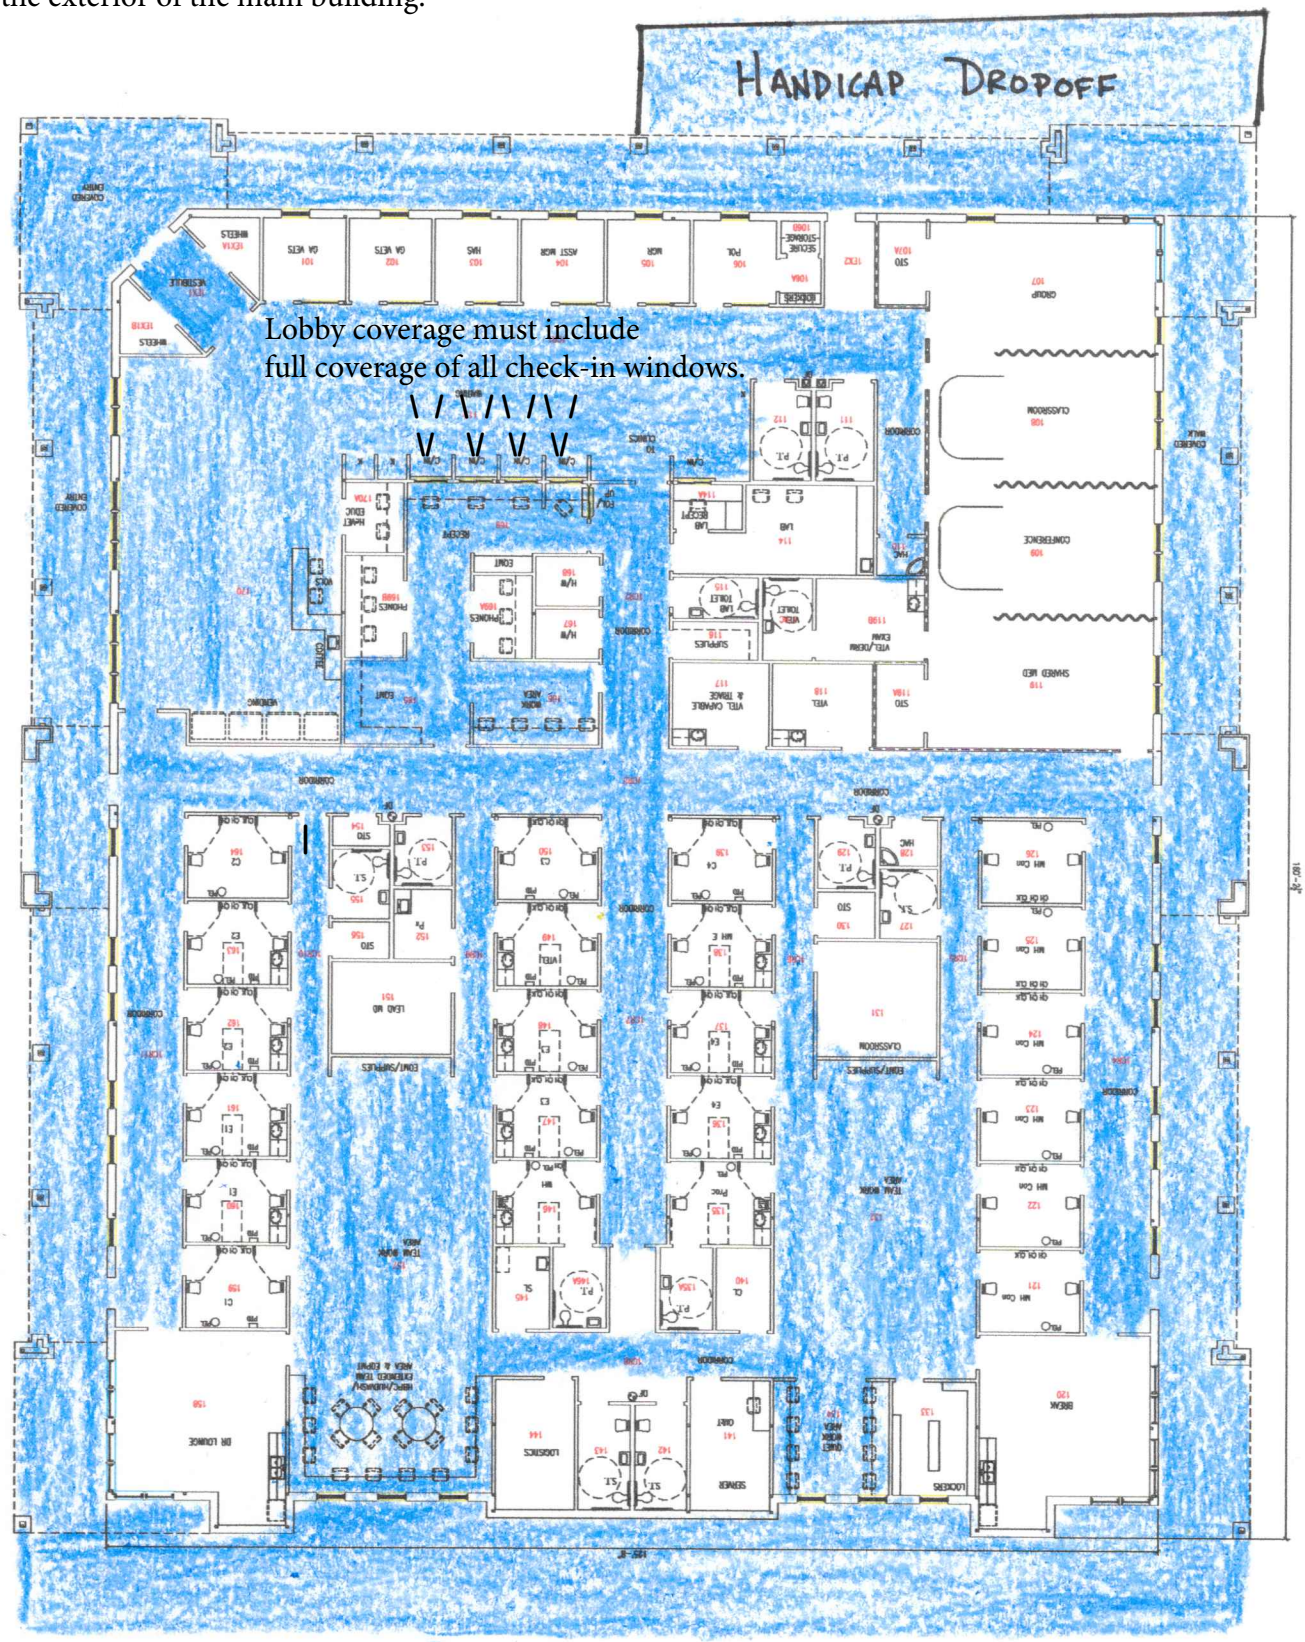
Coverage of Parking area will be via cameras mounted on the exterior of the main building. 360 degree coverage of parking lot is not necessary. Handicap dropoff coverage will also be via camera mounted on the exterior of the main building.