



APR 25 1996

1. Nameplate met  
 "NON-PCB"  
 statement  
 2. Provide certificate  
 of factory impulse  
 test from the  
 manufacturer

# COOPER 3φ TRANSFORMER

KV A SERIAL	500	CLASS DA	CONT RISE 65	°C 60Hz
	MFG DATE			
CP SER	0096SP11K87A			
V	13800	4.84% IZ @ 85°C MFG DATE		
V	480Y/277	WHEN MANUFACTURED CONTAINED LESS THAN 1 PPM PCB'S CAUTION - READ INSTRUCTION MANUAL S210-12-1		
HV AL	95 KV BIL			
HV NEUT.	95 KV BIL			
HO BUSH	-- KV BIL			
LV AL	30 KV BIL			

APPROX. WEIGHT IN LBS.	
CORE & COIL UNTANKING	1721
TANK & FIT	1971
FLUID: OIL GALLONS: 283	2094
TOTAL	5786

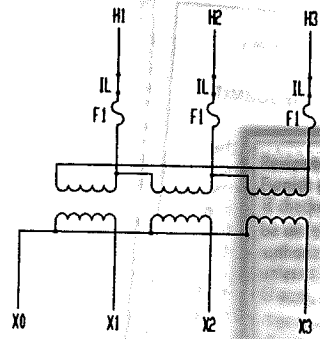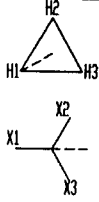

TAP	VOLTAGE	MAX AMPS
A	14490	19.9
B	14150	20.4
C	13800	20.9
D	13460	21.4
E	13110	22.0

If checked below, fabrication MAY NOT be undertaken. Resubmit corrected copies for final Review. Correction shall be limited to items marked.

Revise and Resubmit   
 Resubmit as noted

... the design concept of the ... given in the Contract ... dimensions to be con- ... information that pertains solely ... the means, methods, techniques, ... of construction; and for coordination of ...

WILSON CONSULTANTS INC.  
 6511  
 DATE 5/3/96



TRANSFORMER PRODUCTS  
 WAUKESHA, WI U.S.A.

1189600A8812-00

650-067

62.0

NOTES:  
 1) ACTUAL PLATE IS A NEGATIVE OF THE ABOVE DRAWING.  
 2) ACTUAL %IZ TO BE STAMPED IN AFTER TESTING.

MATERIAL: ALUMINUM

4/18/96

sect 16321

*[Signature]*

440833,001

REVISION

COOPER POWER SYSTEMS  
 TRANSFORMER PRODUCTS

PART NAME

NAMEPLATE

PRINT DIST:

ANGULAR  
 +/- 2°

DWG DAJ

CHK *[Signature]*

ISS

03-19-96

12:11:35

\*  
 CRITICAL  
 DIMENSION

SCALE

DTS

1189600A8812