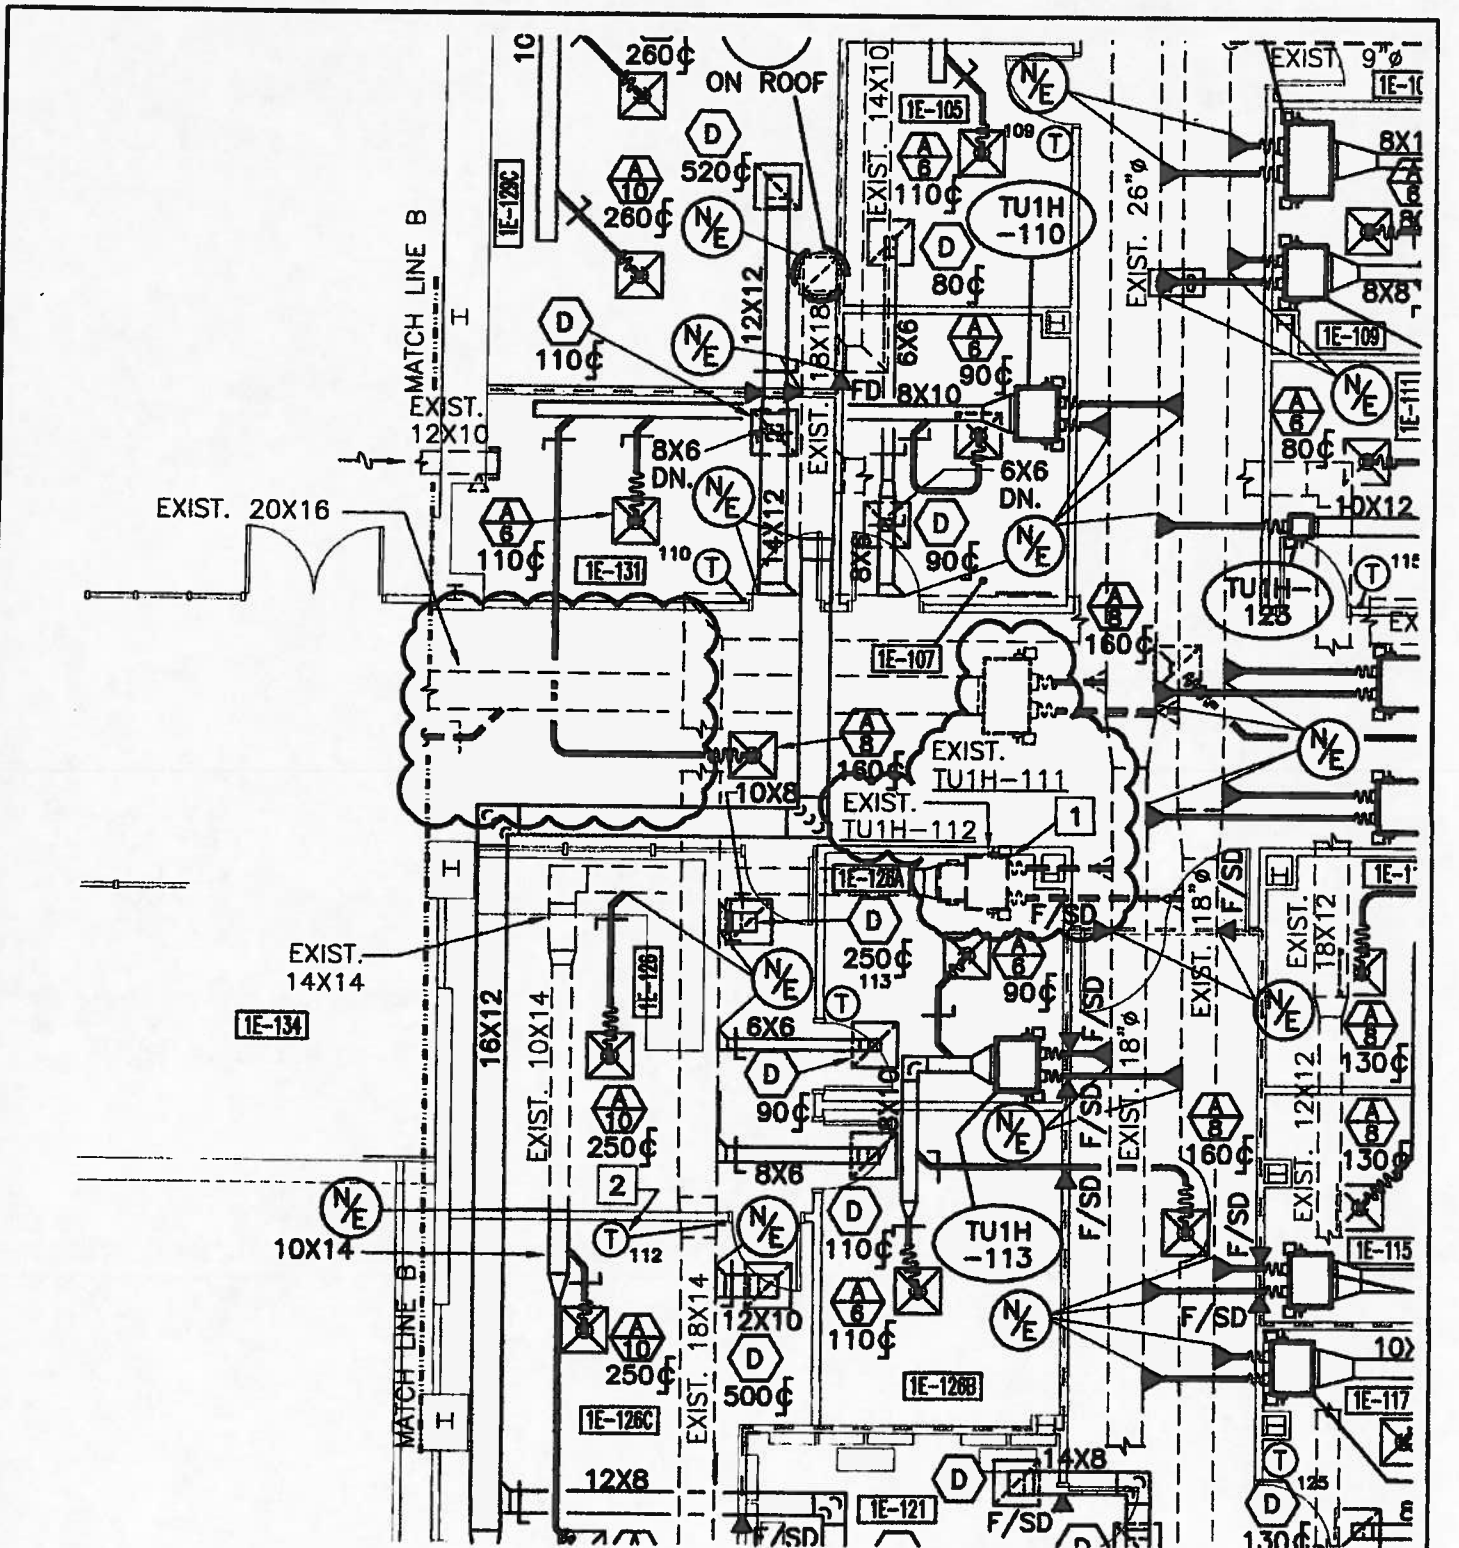

PROJECT NAME: RENOVATE "E" WING BUILDING 801, DOWNTOWN DIVISION AUGUSTA, GEORGIA				
TITLE: HVAC NEW WORK PLAN				SHEET NO. M2.0
DATE: 01-10-12	DRAWN BY: SEB	ENGINEER: CAB	JOB NO. 08101	BULLETIN NO. BDM-1