NOTES:
(THIS SHEET ONLY)

1. PRV #1 AND #2 IN THIS LOCATION. SEE "STEAM PRESSURE REDUCING STATION SINGLE VALVE" DETAIL ON SHEET M503.
2. 3" S-70 OUT OF PRV-1.
3. 4" S-15 OUT OF PRV-2.
4. COLLECT FAN COIL UNIT DRAIN, COOLING COIL DRAIN, AND HUMIDIFIER DRAIN INTO 1½" PIPE AND RUN DOWN THROUGH FLOOR, THROUGH CURB AND ROOF TO HUB DRAIN ABOVE CEILING. SEE PLUMBING.
5. COLLECT CONDENSATE RETURN DRAINS FROM HEATING WATER SYSTEM AND FAN COIL UNIT INTO 1½" PIPE AND RUN DOWN INSULATED AND HEAT TRACE TO HUB DRAIN ABOVE CEILING. SEE PLUMBING.
6. COLLECT FAN COIL UNIT DRAIN, COOLING COIL DRAIN, AND HUMIDIFIER DRAIN INTO 1½" PIPE AND RUN DOWN INSULATED AND HEAT TRACE TO HUB DRAIN ABOVE CEILING. SEE PLUMBING.

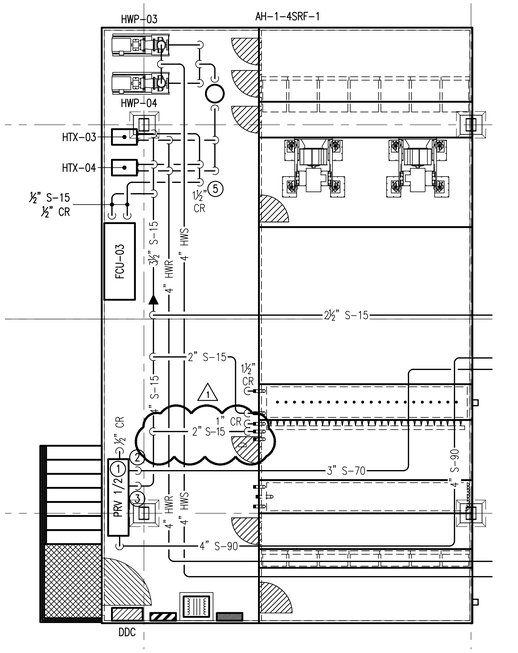

ENLARGED AH-1-4SRF-1 AIR HANDLING UNIT HOT WATER AND STEAM PIPING – MECHANICAL
SCALE: 1/4" = 1'-0"

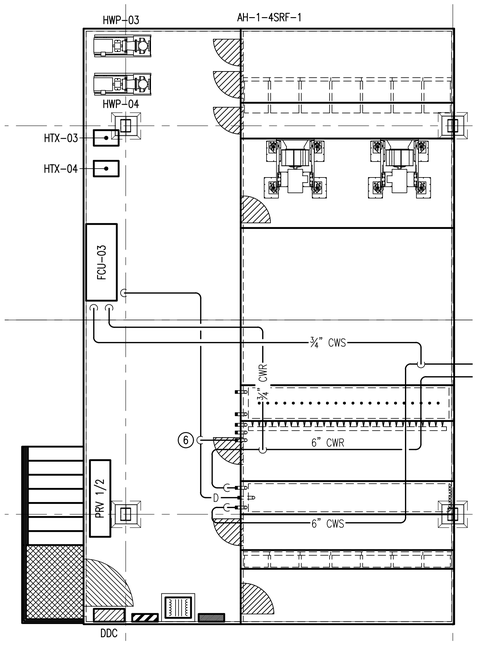

ENLARGED AH-1-4SRF-1 AIR HANDLING UNIT CHILLED WATER AND DRAIN PIPING – MECHANICAL
SCALE: 1/4" = 1'-0"

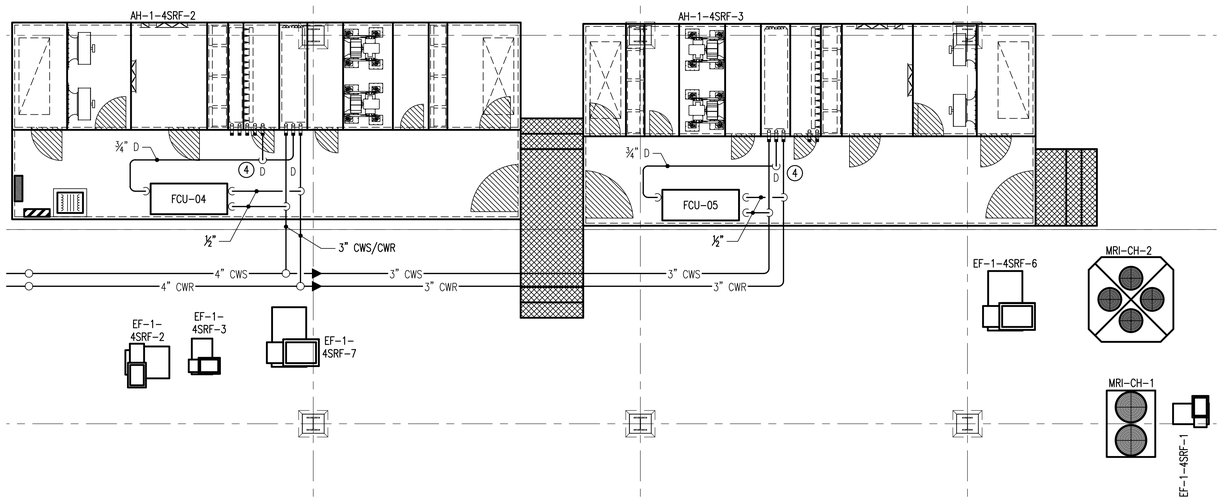

ENLARGED AH-1-4SRF-2 AND AH-1-4SRF-3 AIR AIR HANDLING UNIT CHILLED WATER AND DRAIN PIPING – MECHANICAL
SCALE: 1/4" = 1'-0"

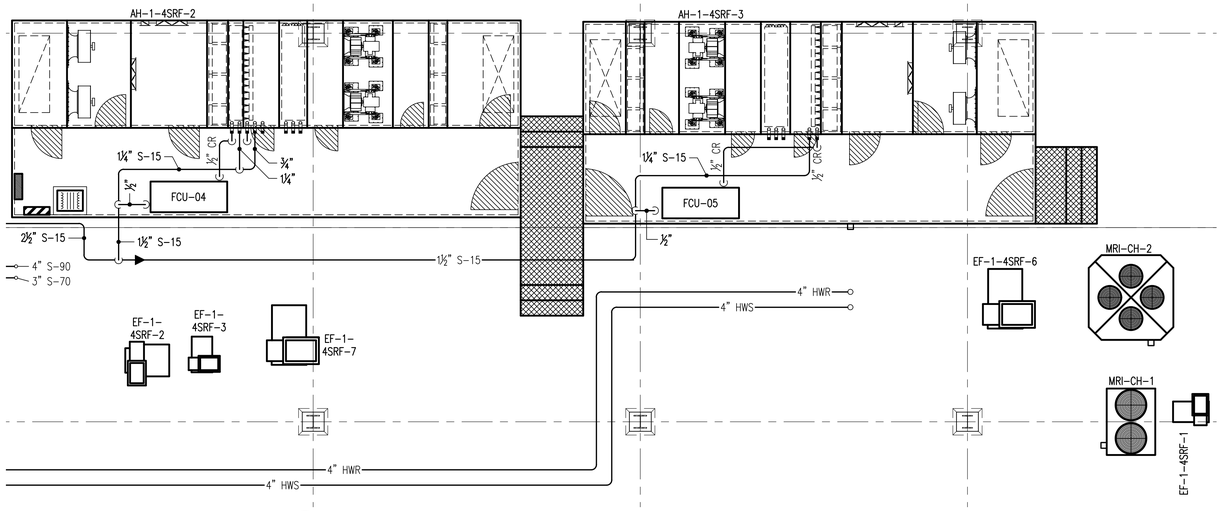

ENLARGED AH-1-4SRF-2 AND AH-1-4SRF-3 AIR HANDLING UNIT HOT WATER AND STEAM PIPING – MECHANICAL
SCALE: 1/4" = 1'-0"

Revisions:	Date
1 – PIPE SIZE CHANGE TO HUMIDIFIER FOR AH-1-4SRF-1	7/20/16

CONSULTANTS:

APPLIED ENGINEERING SOLUTIONS
440 Martin Luther King, Jr. Blvd., Suite 401
Macon, Georgia 31201
Phone: (478) 314-1270 – Fax: (478) 314-1271
www.oes-pe.com

ARCHITECT/ENGINEERS:

TOLAND MIZELL MOLNAR
590 Means Street NW, Suite 200
Atlanta, GA 30318
404.214.9774


Approved: Project Director

Project Title: EXPAND RADIOLOGY AND SPS OVERTON BROOKS VAMC

Location: SHREVEPORT, LA

Date: 04-17-2015 | Checked: PJC | Drawn: JSW

Project Number: 667-083

Building Number: 1

Drawing Number: M406

Dwg. 123 of 160

FINAL SUBMITTAL

OFFICE OF CONSTRUCTION AND FACILITIES MANAGEMENT

VA | U.S. Department of Veterans Affairs

VA FORM 08-6231