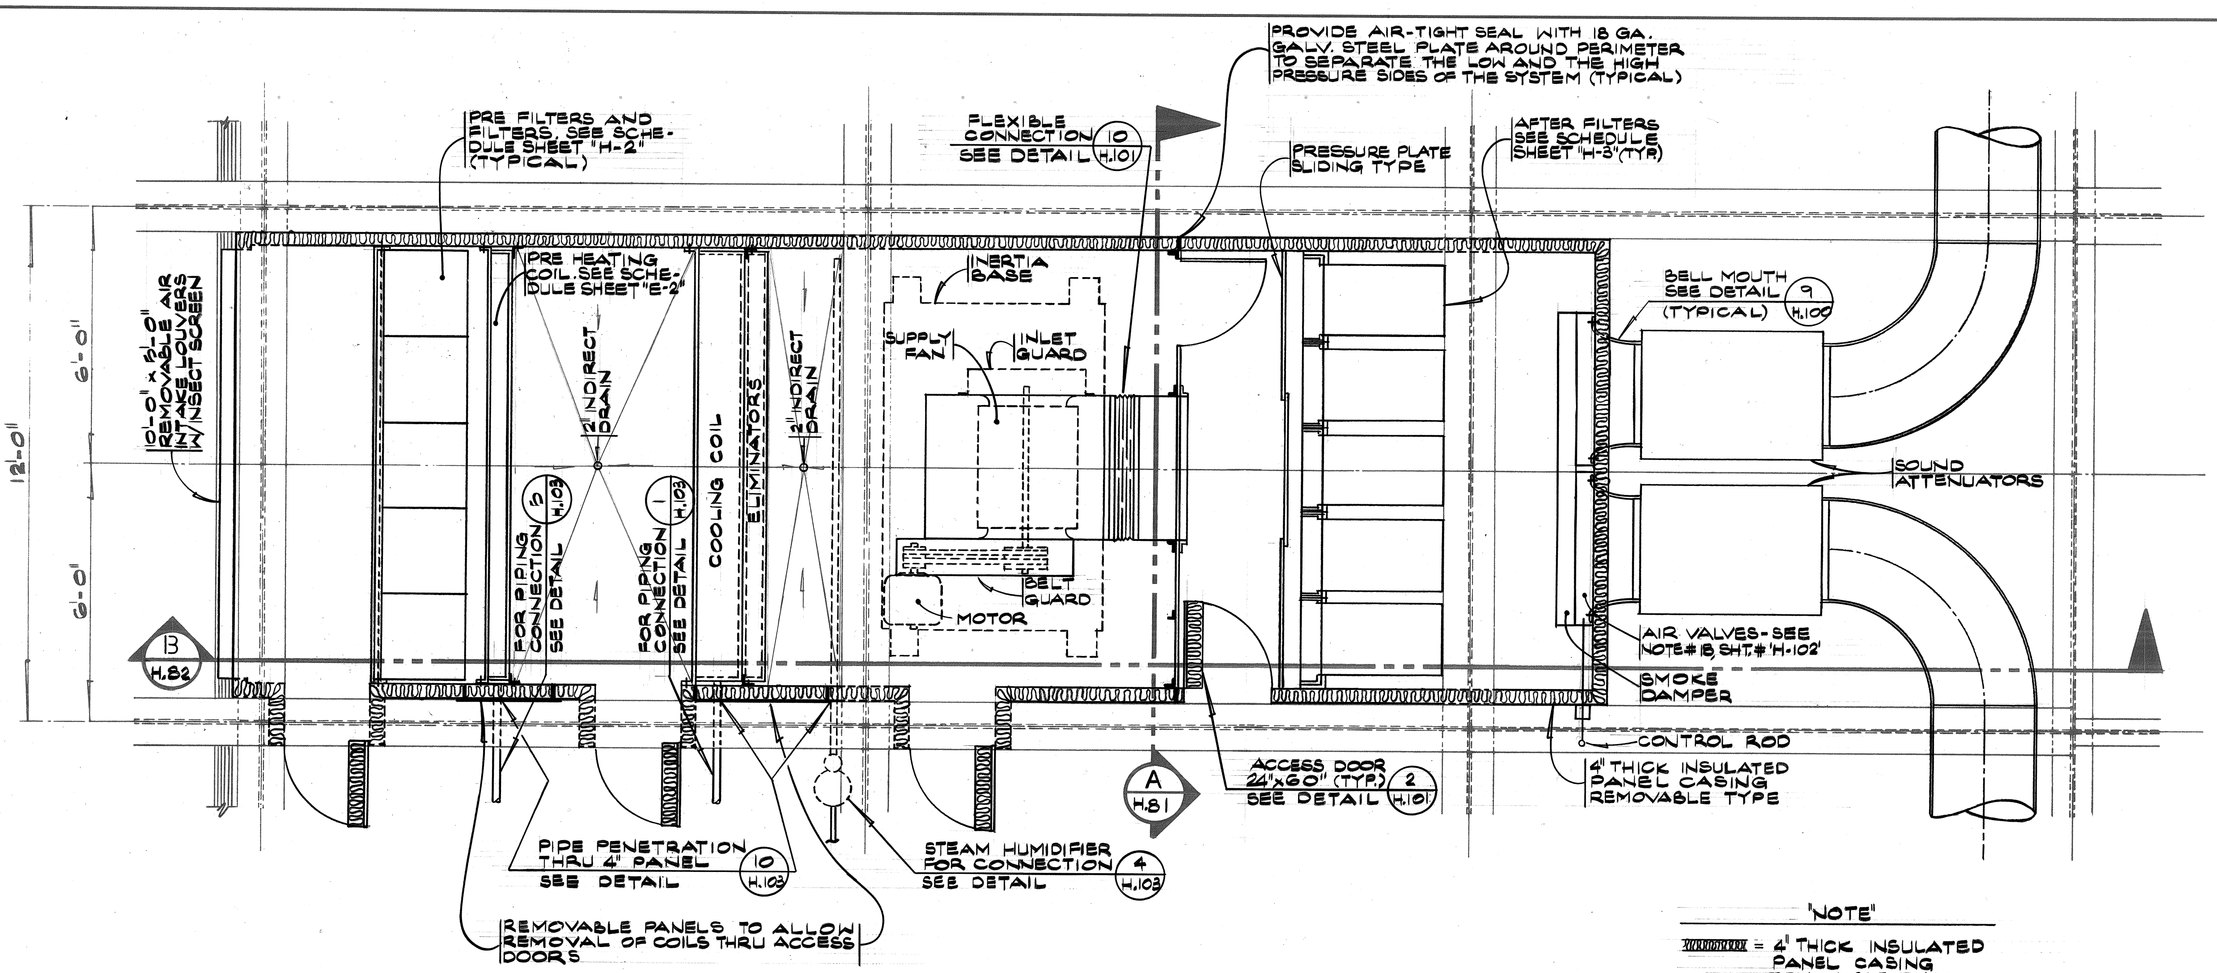

PLAN
SCALE: 1/2"=1'-0"

'NOTE'
xxxxxxxx = 4" THICK INSULATED PANEL CASING REMOVABLE TYPE

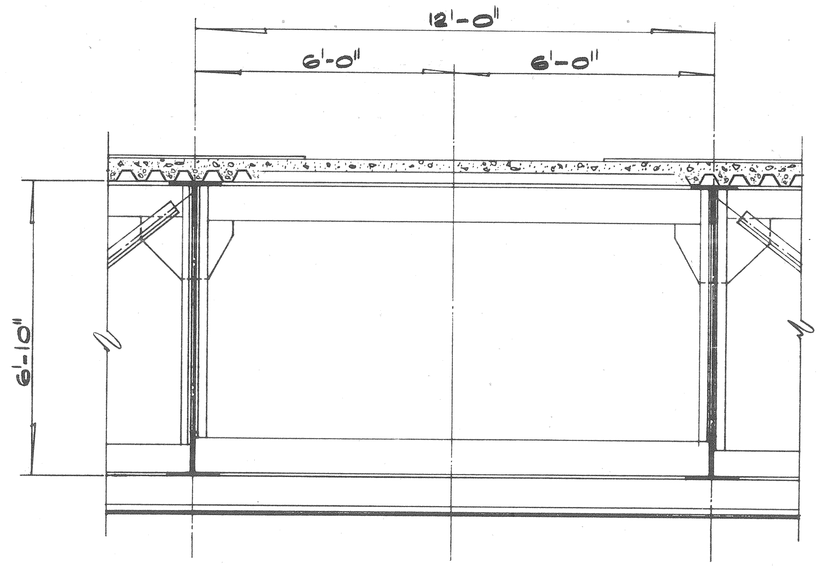

FOR THIS ELEVATION SEE DETAIL A H.81

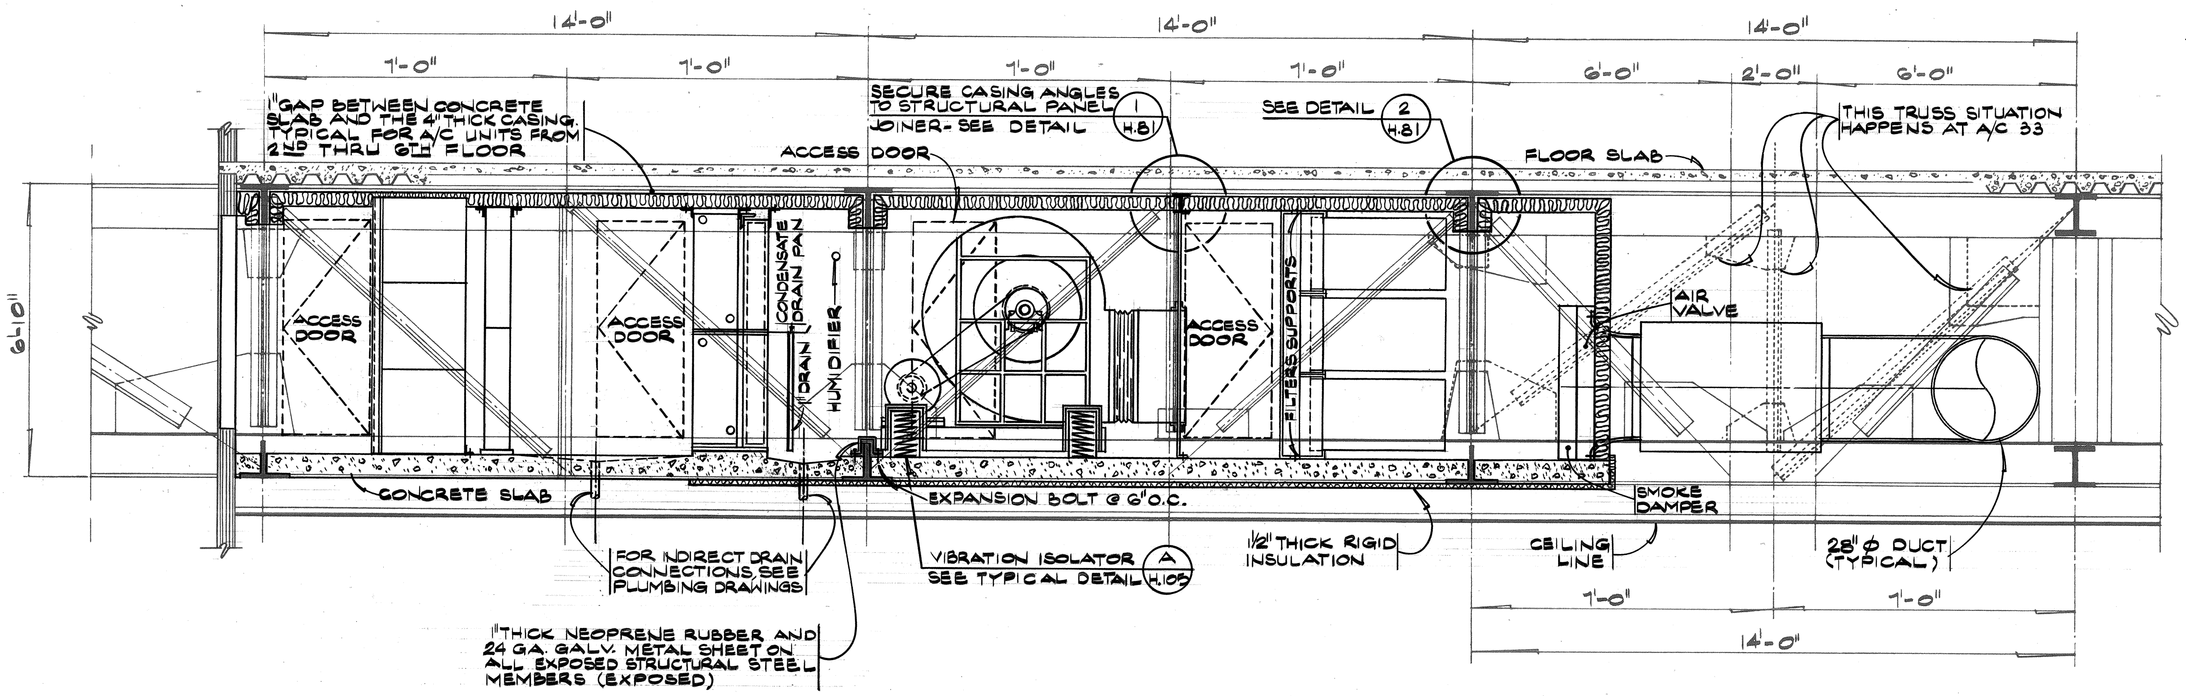

SECTION B H.82
SCALE: 1/2"=1'-0"

A/C UNITS # 32 & 33
(DRAW THRU UNIT TYPE)

1-4-1-1372

0 6" 1' 2' 4' 6"
SCALE: 1/4"=1'-0"

AMENDMENT DRAWING

FAN ROOM PLANS & SECTIONS

PHASE 2 BLDG. 500

820 BED HOSPITAL BUILDING

VETERANS ADMINISTRATION
VAH, LOS ANGELES, CALIFORNIA

Drawn B.N. Proj. Mgr. R.H.C.
Checked D.C. Date 7-10-74

REVISIONS
AS BUILT

CHARLES LUCKMAN ASSOCIATES
PLANNING • ARCHITECTURE • ENGINEERING
9220 SUNSET BLVD. LOS ANGELES, 90069

DRAWING NUMBER 2-1
500-H.82

Approved: PROJECT DIRECTOR

Sheet 623 of 802

Proj. No. 691-072

R•J•M ASSOCIATES
CONSULTING ENGINEERS
9200 SUNSET BLVD.
LOS ANGELES, CALIFORNIA

REGISTERED PROFESSIONAL ENGINEER HARRY A. SAUNDERS No. M-13465 CIVIL STATE OF CALIFORNIA

40

RETURN TO PLAN LIBRARY

FILE FOLDER NO. 2C-1