REPLACE VCT & BASE & CARPET

AFTER HOURS-Weekends ONLY

PHASED

1 Fourth Floor Plan - Building 1 (North Building)

NOT TO SCALE
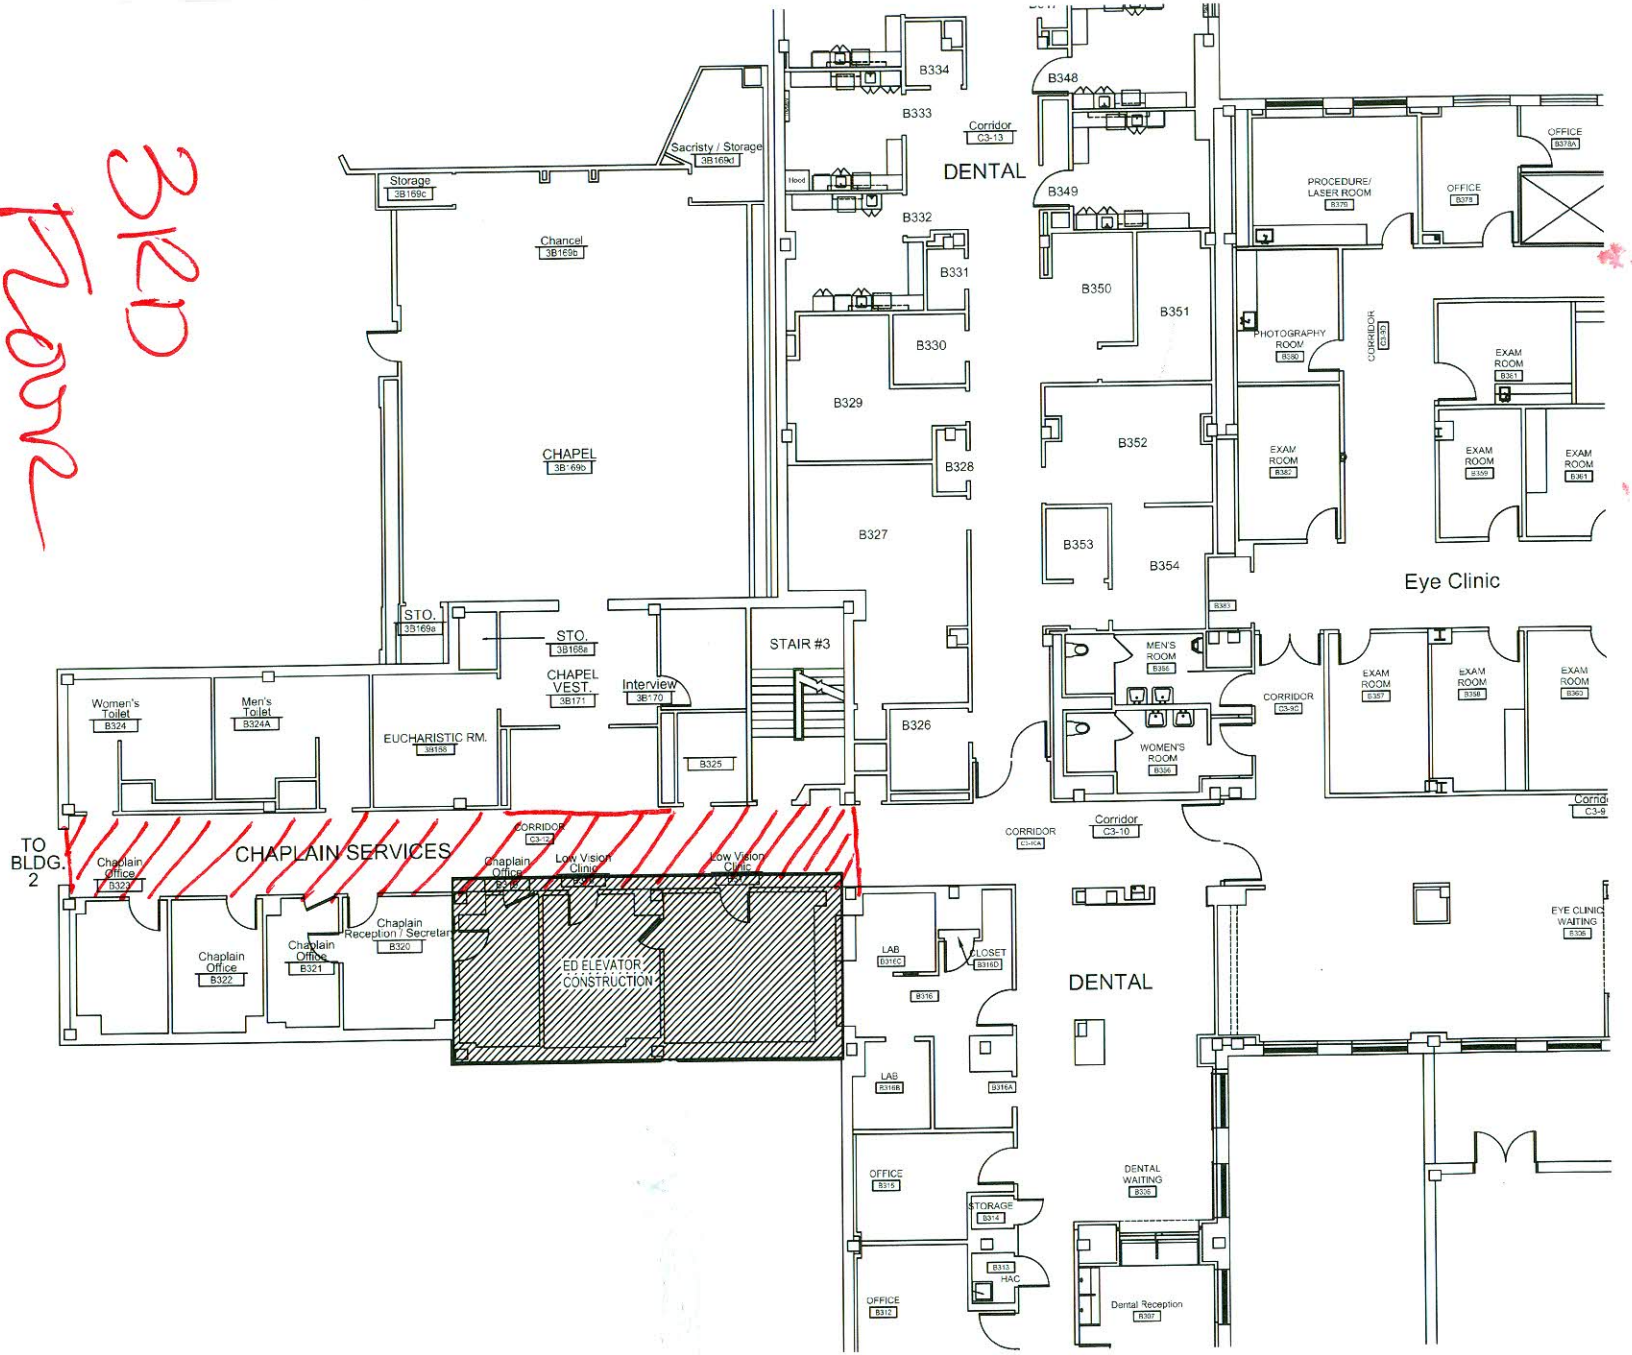
