



P:\0324\1\2002-01 02-02 11171003.dwg, 45.1 = 3 N ELEVATIONS, 1/18/2006 11:09:28 AM, 9/20

PK

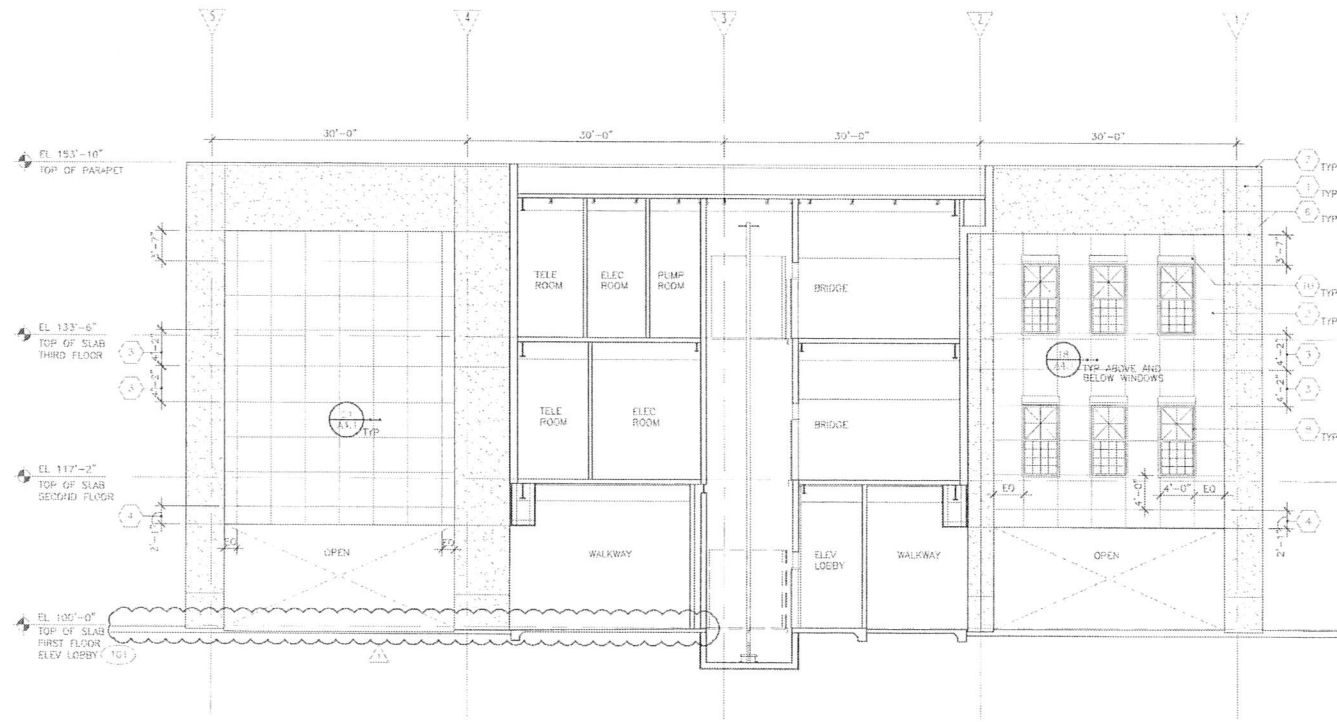

NORTH ELEVATION

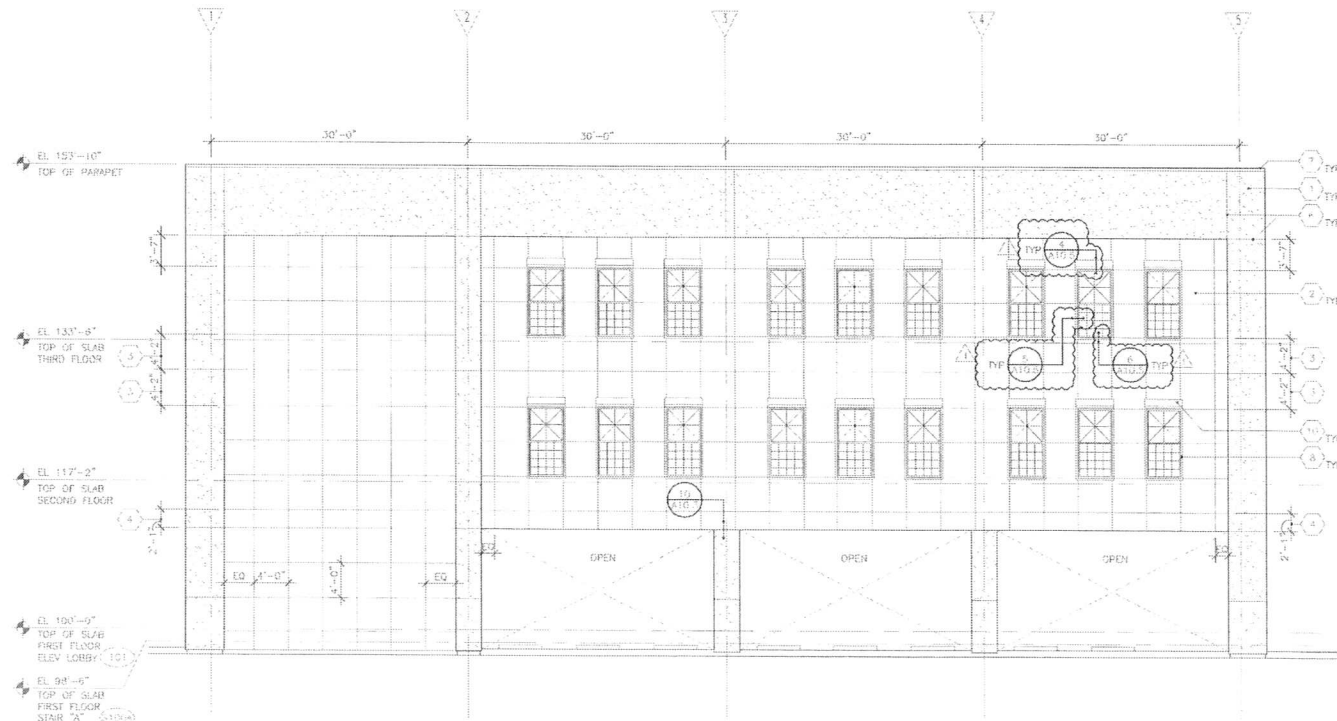

SOUTH ELEVATION

- EXTERIOR ELEVATION SPECIFIC NOTES**
ELEVATION SPECIFIC NOTES APPLY TO SHEETS AS.1 THROUGH AS.3 ONLY.
1. SYNTHETIC STUCCO/EIFS
 2. CAST STONE, 4'-0\"/>

VETERANS BENEFITS ADMINISTRATION - OFFICE OF FACILITIES
VA - FILE STORAGE BUILDING
ST. PETERSBURG, FLORIDA

Raion & Partners, Inc.
Architects
545 Bay Street, Tampa, Florida 33606
Telephone: (813) 253-5455 FAX: (813) 253-5456

SHEET NUMBER
AS.1

DATE: 05-19-06
DESIGNED BY: JS
REVIEWED BY: JS
DRAWN BY: JS
CHECKED BY: RS
Richard Schmitt
Florida, AR0006680

EXTERIOR ELEVATIONS
SCALE: 1/8" = 1'-0"